

CERTIFICATE OF LOCATION OF GOVERNMENT CORNER

County of Anoka

State of Minnesota


Witness Corner of Sec. 19 Township 32 Range 22
 (on north line of NW1/4)

On the 20th day of September, 1988, the described corner was evidenced by a 3/4" iron rod set by MN DNR

and to perpetuate the location of said corner, at the exact location thereof, a permanent marker was placed consisting of a cast iron monument with a sign and post ^{1.5'} on the southeast side

AND on the ___ day of _____, _____, said permanent marker was _____

Updated reference ties are as shown below.

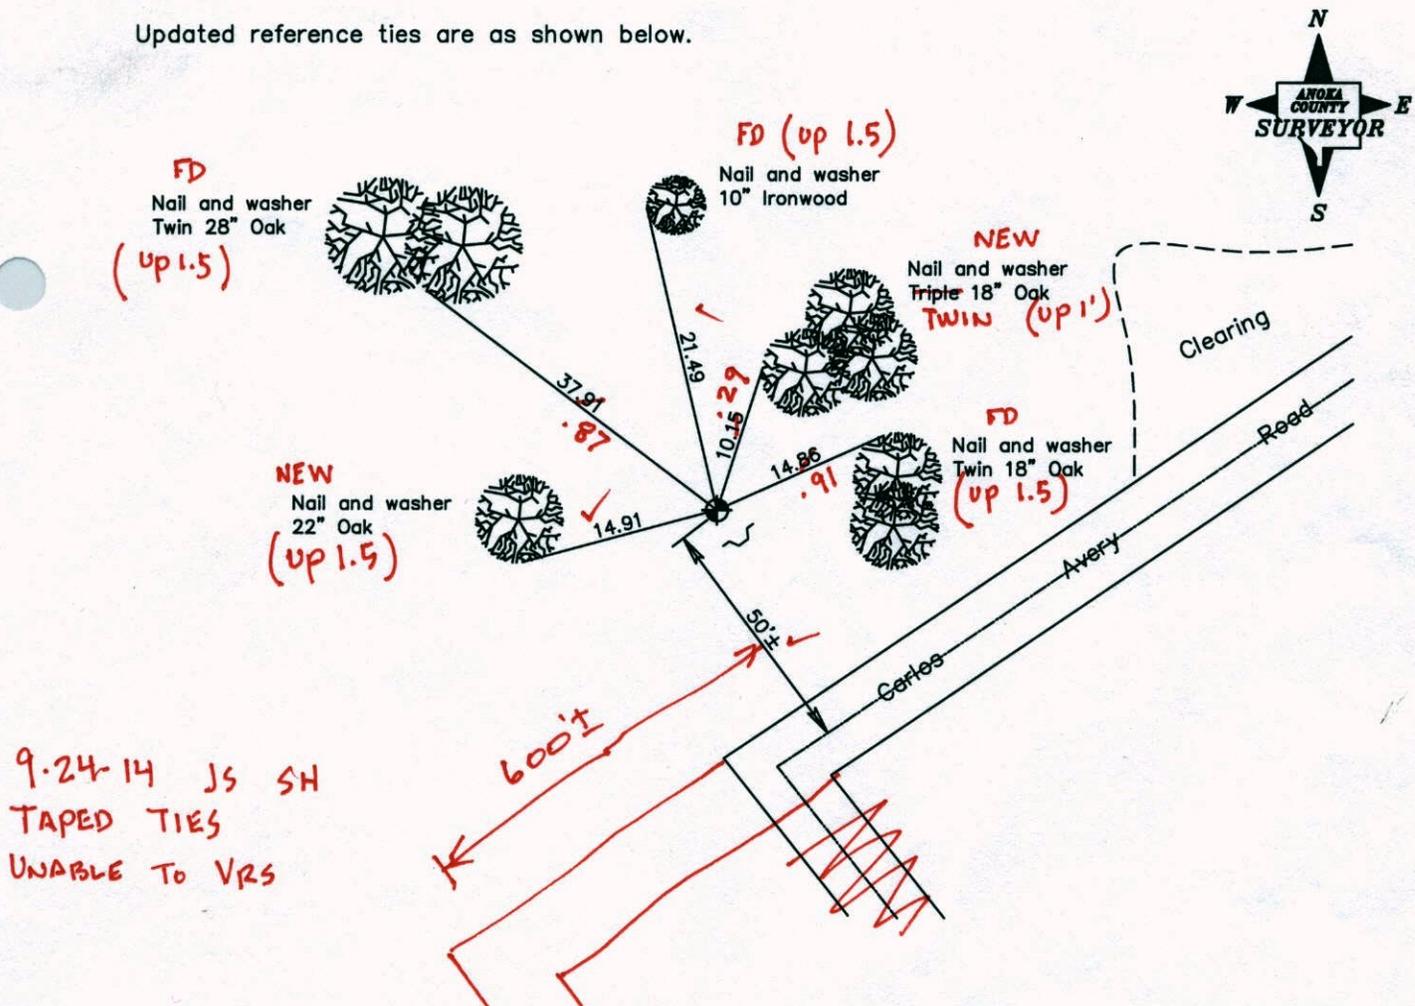

9.24.14 JS SH
 TAPED TIES
 UNABLE TO VRS

Revised date
7/12/90
9/06/95
3/04/02

N.A.D. 1983 Coordinates (1996 Adjustment)	
County Project Coordinates	
Northing	179902.2762
Easting	532767.0135
Date	3/04/02

I hereby certify that this United States public land survey monument record is correct and complete to the best of my knowledge and belief.

_____, Anoka County Surveyor

Minnesota License Number _____

CERTIFICATE OF LOCATION OF GOVERNMENT CORNER

County of Anoka

State of Minnesota


Witness Corner of Sec. 19 Township 32 Range 22
(on north line of NW1/4)

On the 20th day of September, 1988, the described corner was evidenced by a 3/4" iron rod set by MN DNR

and to perpetuate the location of said corner, at the exact location thereof, a permanent marker was placed consisting of a cast iron monument with a sign and post on the southeast side

AND on the ___ day of _____, _____, said permanent marker was _____

Updated reference ties are as shown below.

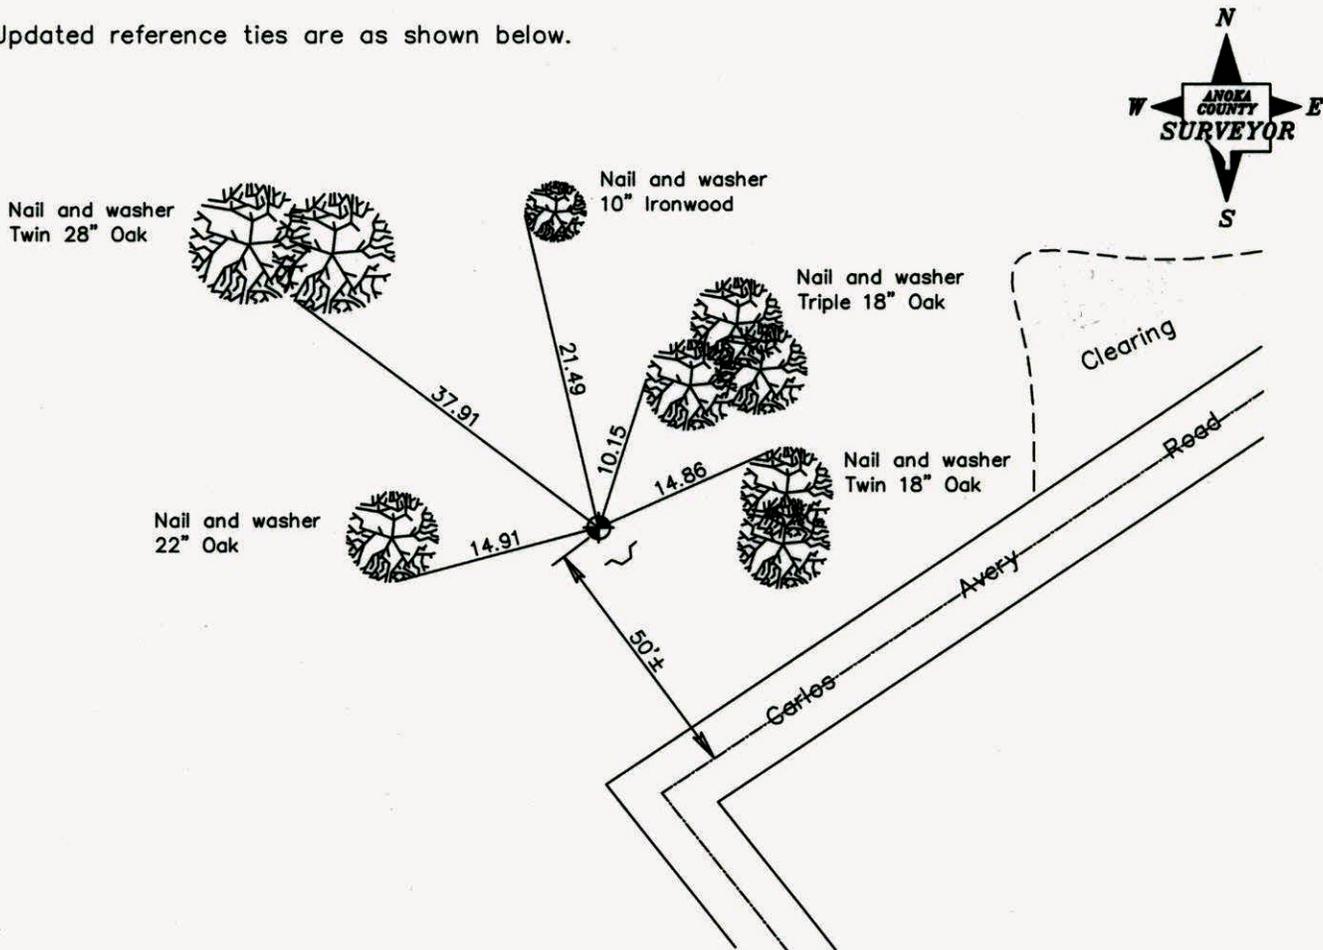

Revised date

7/12/90
9/06/95
3/04/02

N.A.D. 1983 Coordinates
(1996 Adjustment)

County Project Coordinates
Northing <u>179902.2762</u>
Easting <u>532767.0135</u>
Date <u>3/04/02</u>

I hereby certify that this United States public land survey monument record is correct and complete to the best of my knowledge and belief.

_____ Date _____
_____, Anoka County Surveyor
Minnesota License Number _____

CERTIFICATE OF LOCATION OF GOVERNMENT CORNER

County of Anoka


State of Minnesota

W.C. on N. Line of NW $\frac{1}{4}$ Corner of Sec. 19 Township 32 Range 22

I hereby certify that on the 20 day of September, 1988, I found the described corner which was evidenced by $\frac{3}{4}$ " Iron Rod Set by MN. DNR


and I further certify that to perpetuate the location of said corner, I did, at the exact location thereof, place a permanent marker consisting of Cast Iron Monument with Sign & Post on S.E. side

which reference or witness monuments are located in the manner following:

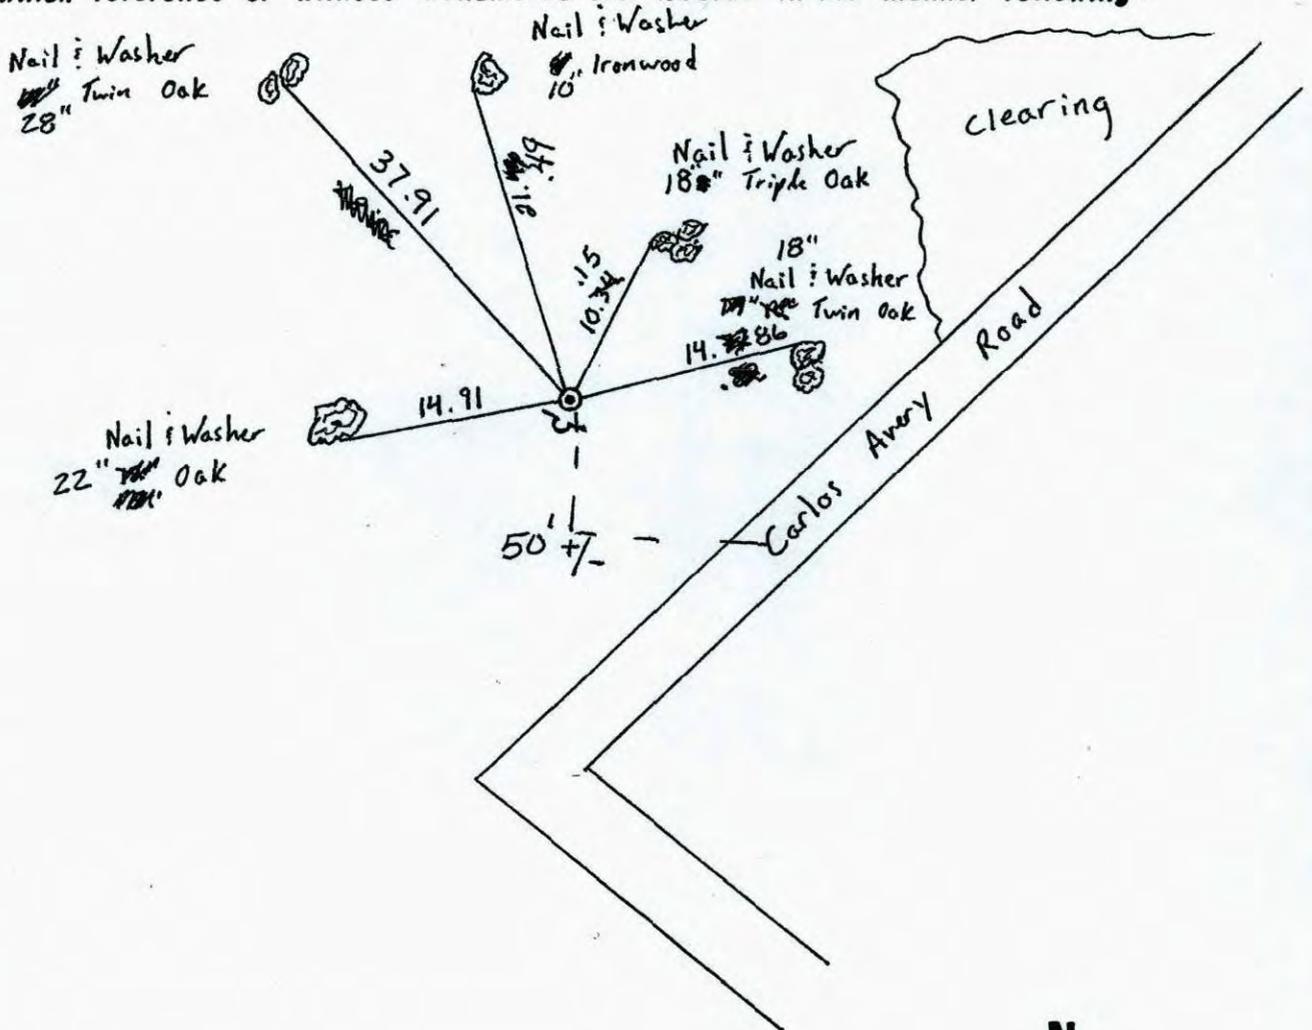

Revised date Revised date Revised date

9-20-88		
7-12-90		
9-6-95 HL		
3-4-02		

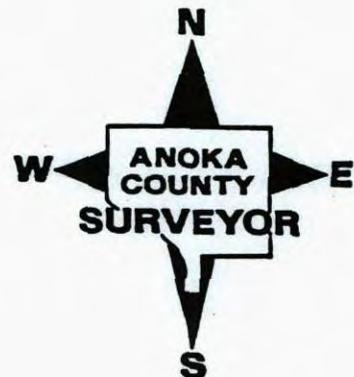

CERTIFICATE OF LOCATION OF GOVERNMENT CORNER

County of Anoka


State of Minnesota

W.C. on N. Line of NW 1/4 Corner of Sec. 19 Township 32 Range 22


I hereby certify that on the 20 day of September, 1988, I found the described corner which was evidenced by 3/4" Iron Rod Set by MN, DNR

and I further certify that to perpetuate the location of said corner, I did, at the exact location thereof, place a permanent marker consisting of Cast Iron Monument with Sign & Post on S.E. side

which reference or witness monuments are located in the manner following:

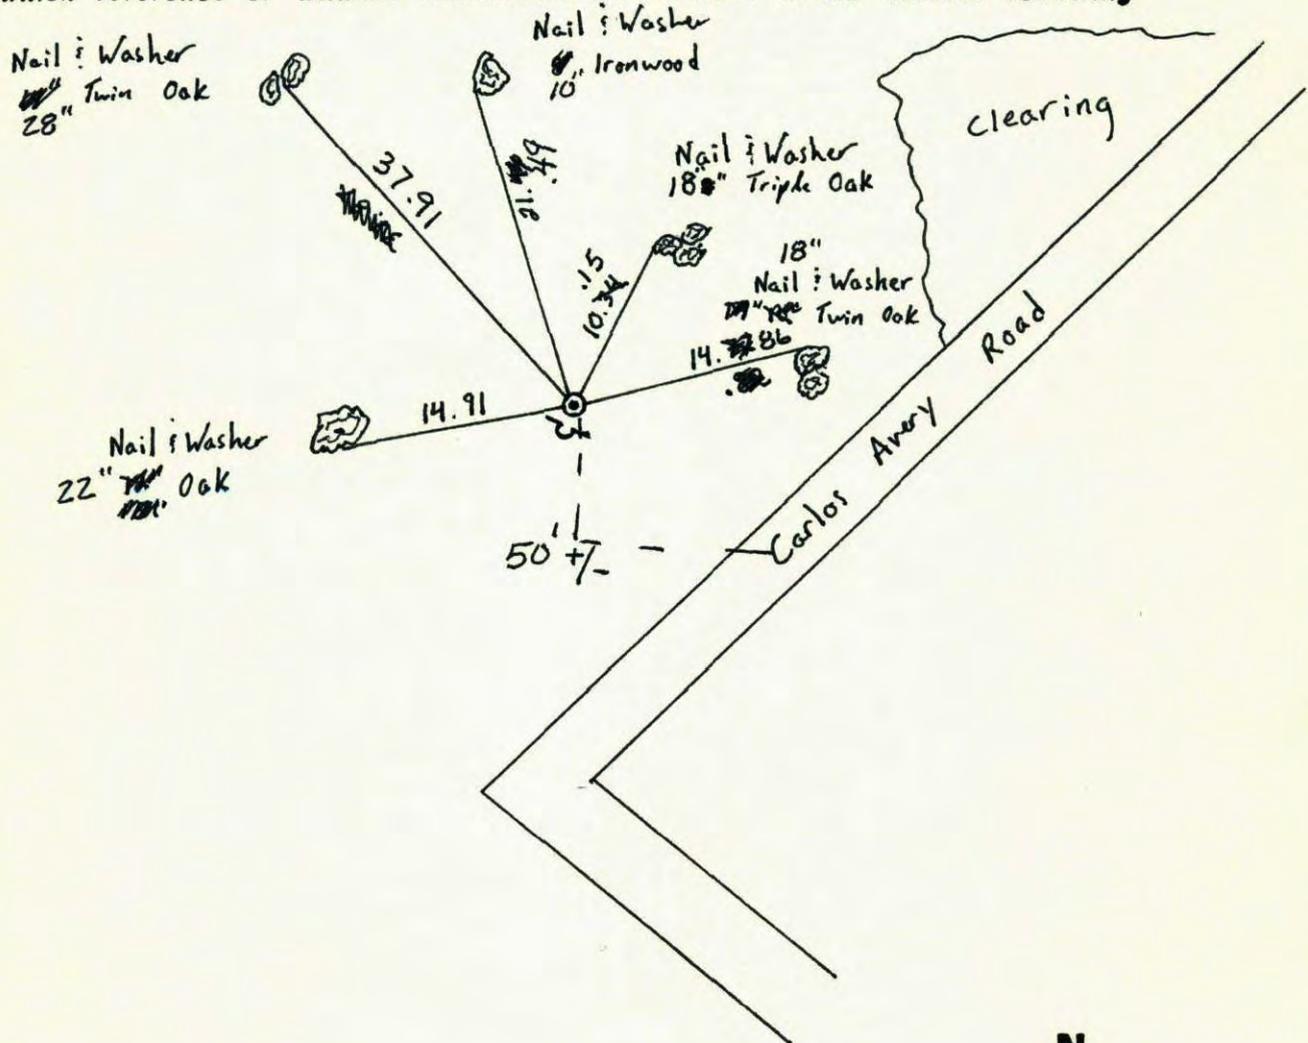


Revised date	Revised date	Revised date
9-20-88		
7-12-90		
9-6-95 HL		
3-4-02		

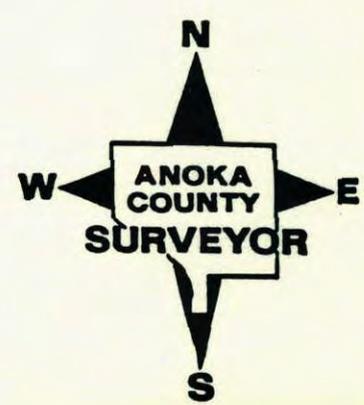

Witness Corner on North Line of NW 1/4 Sec. 19 T32 R22

Replaced 3/4" Iron Rod with Cast Iron Monument
Placed Sign Post SE Side

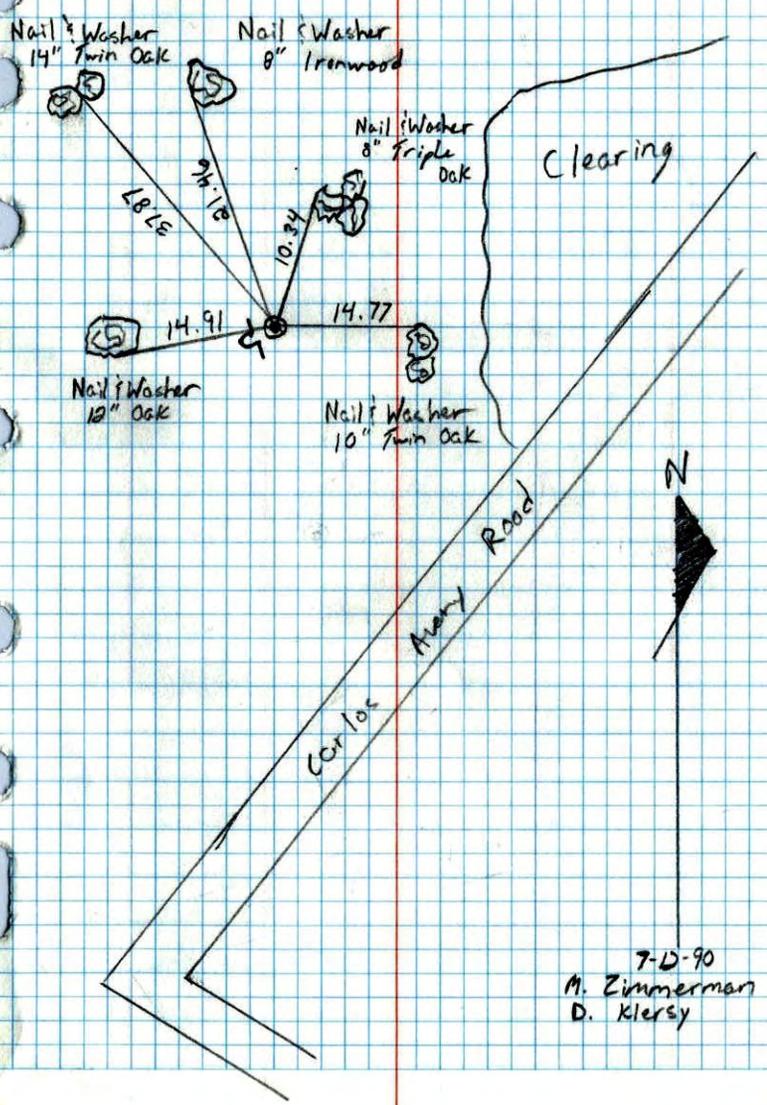

NO. 448
WTELETYPE

7-D-90
M. Zimmerman
D. Klersy