

CERTIFICATE OF LOCATION OF GOVERNMENT CORNER

County of Anoka

State of Minnesota


East 1/4 Corner of Sec. 21 Township 32 Range 22

On the 14th day of July, 1967, the described corner was evidenced by a 1/2" iron pipe

and to perpetuate the location of said corner, at the exact location thereof, a permanent marker was placed consisting of a cast iron monument

AND on the 12th day of November, 2007, said permanent marker was found and the ties were updated

Updated reference ties are as shown below.

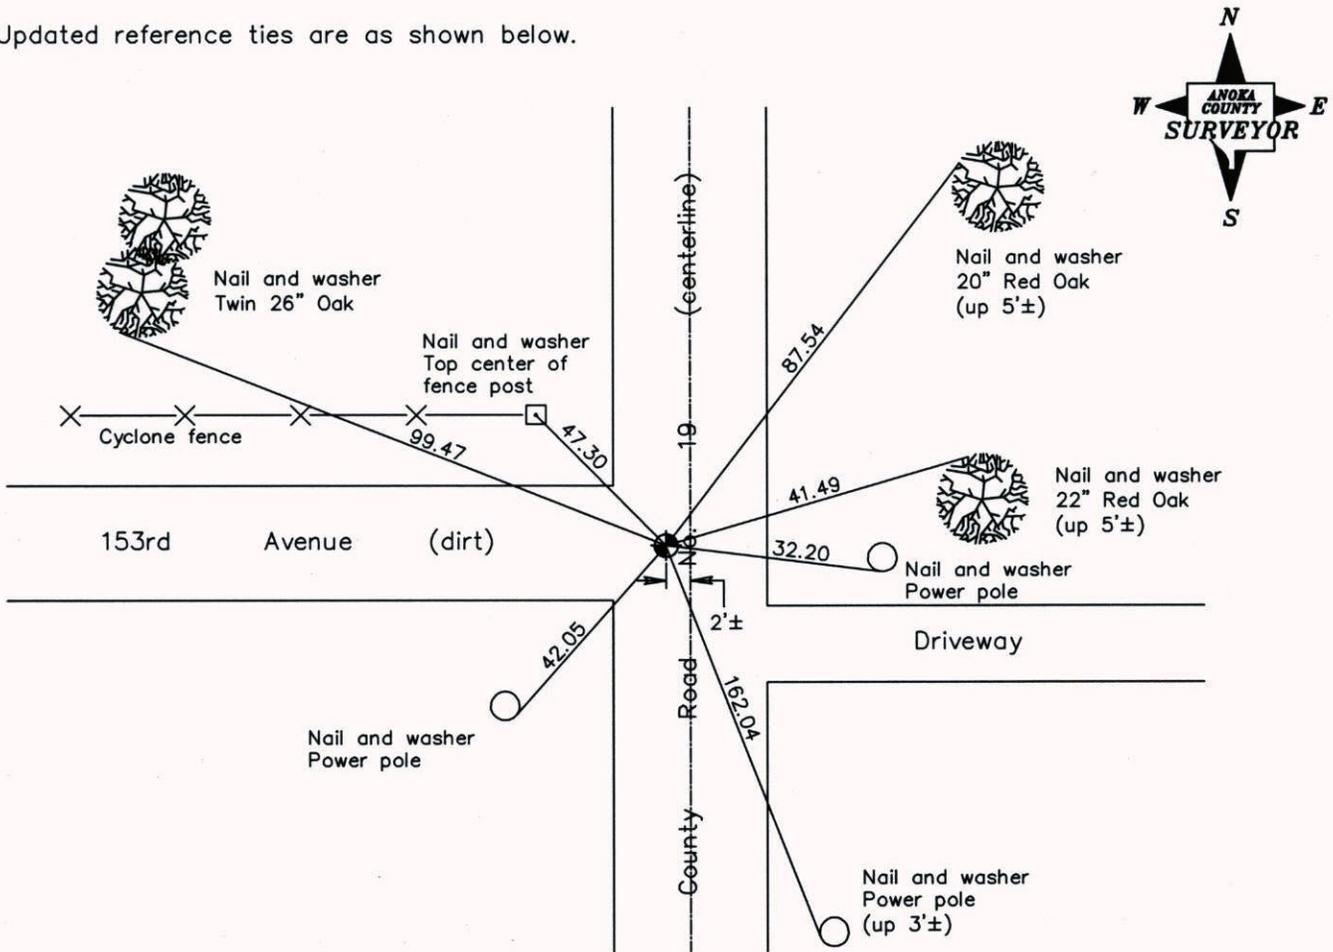

Revised date
8/26/97
6/16/03
11/12/07

N.A.D. 1983 Coordinates (1996 Adjustment)	
County Project Coordinates	
Northing	<u>177322.7981</u>
Easting	<u>547908.6110</u>
Date	<u>6/17/03</u>

I hereby certify that this United States public land survey monument record is correct and complete to the best of my knowledge and belief.

Larry D. Hoium Date 11/12/07

Larry D. Hoium, Anoka County Surveyor

Minnesota License Number 18165

CERTIFICATE OF LOCATION OF GOVERNMENT CORNER

County of Anoka


State of Minnesota

EAST 1/4 Corner of Sec. 21 Township 32 Range 22


I hereby certify that on the 14 day of JULY, 1967, I found the described corner which was evidenced by 1/2" I.P.

and I further certify that to perpetuate the location of said corner, I did, at the exact location thereof, place a permanent marker consisting of CAST IRON MON. LOCATE 2'
WEST OF &

which reference or witness monuments are located in the manner following:

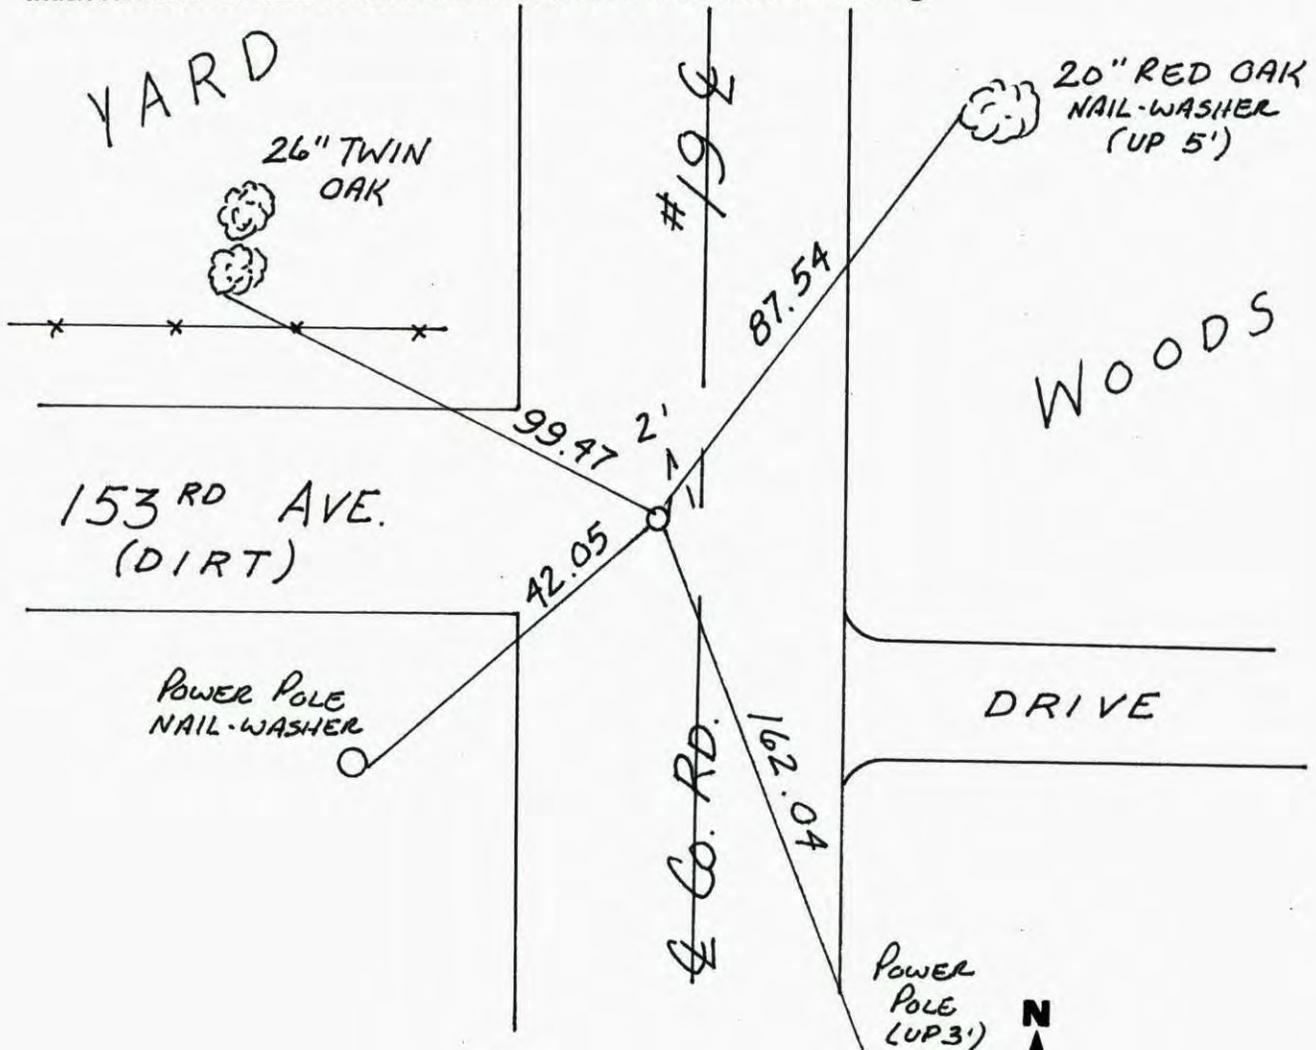

Revised date	Revised date	Revised date
8-2-85		
8-14-95		
8-26-97		
6-16-03		
11-12-07		

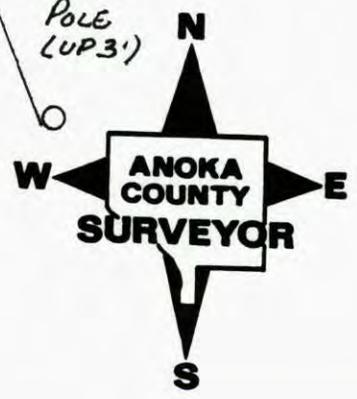

CERTIFICATE OF LOCATION OF GOVERNMENT CORNER

County of Anoka


State of Minnesota

EAST QTR. Corner of Sec. 21 Township 32 Range 22

I hereby certify that on the 14TH day of JULY, 19 67, I found the described corner which was evidenced by 1/2" IRON PIPE


and I further certify that to perpetuate the location of said corner, I did, at the exact location thereof, place a permanent marker consisting of CAST IRON MONUMENT - MON. IS 2' WEST OF E

which reference or witness monuments are located in the manner following:

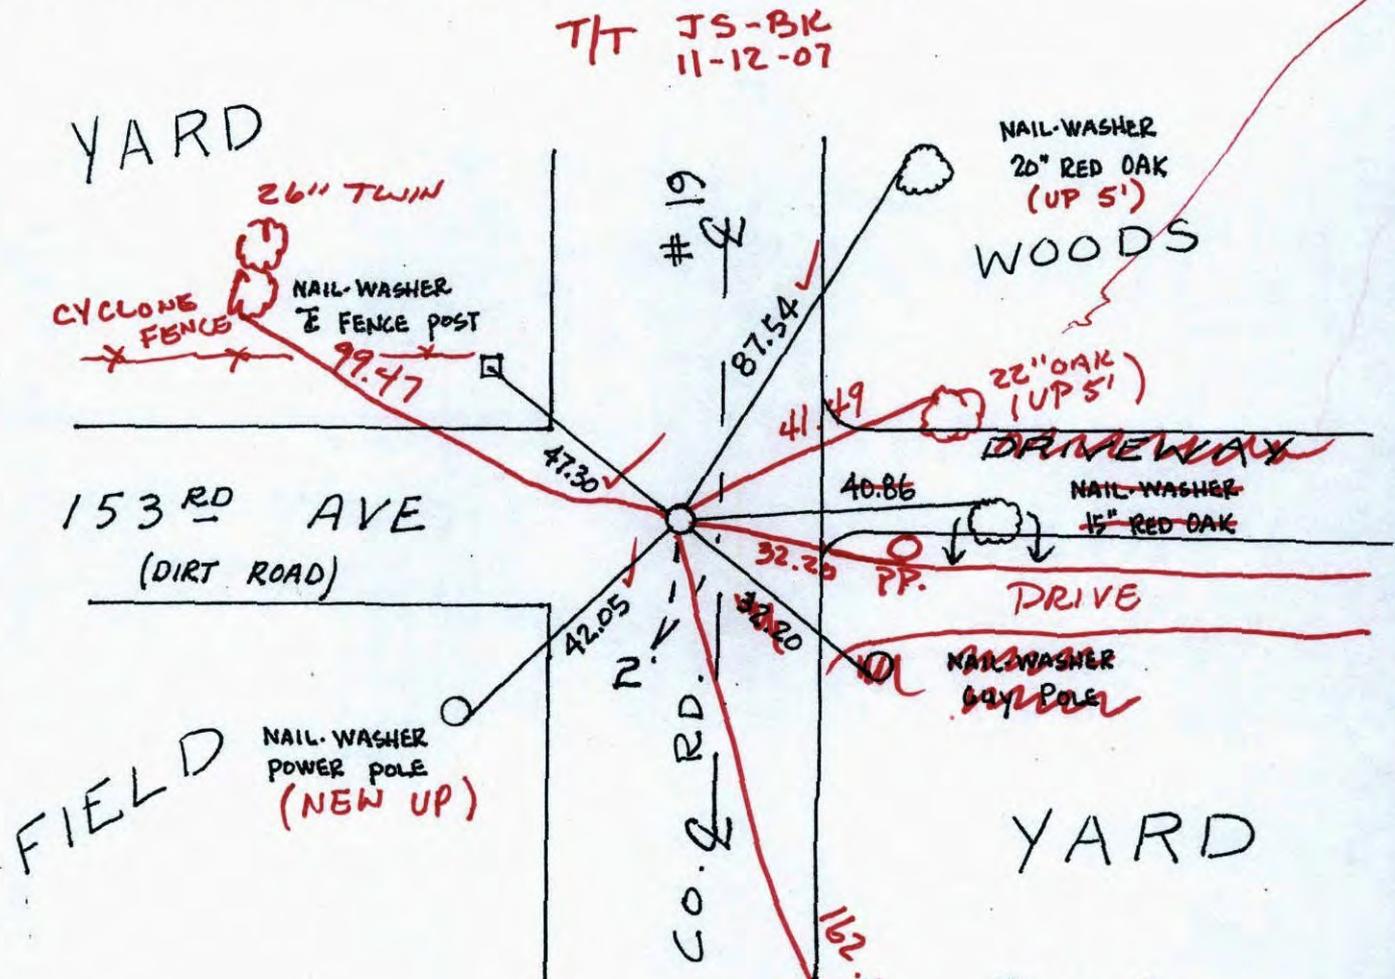


T/T JS-BK
11-12-07

Revised date	Revised date	Revised date
8-2-85		
8-14-95		
REPLACED 8-26-97		
6-16-03		

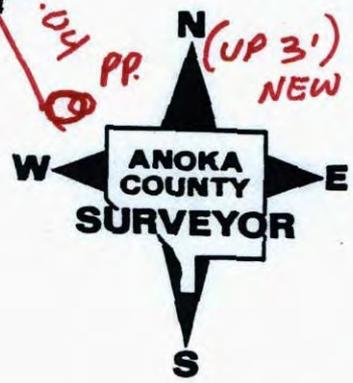

CONSTRUCTION TIES

EAST 1/4 SEC. 21 T 32 R 22

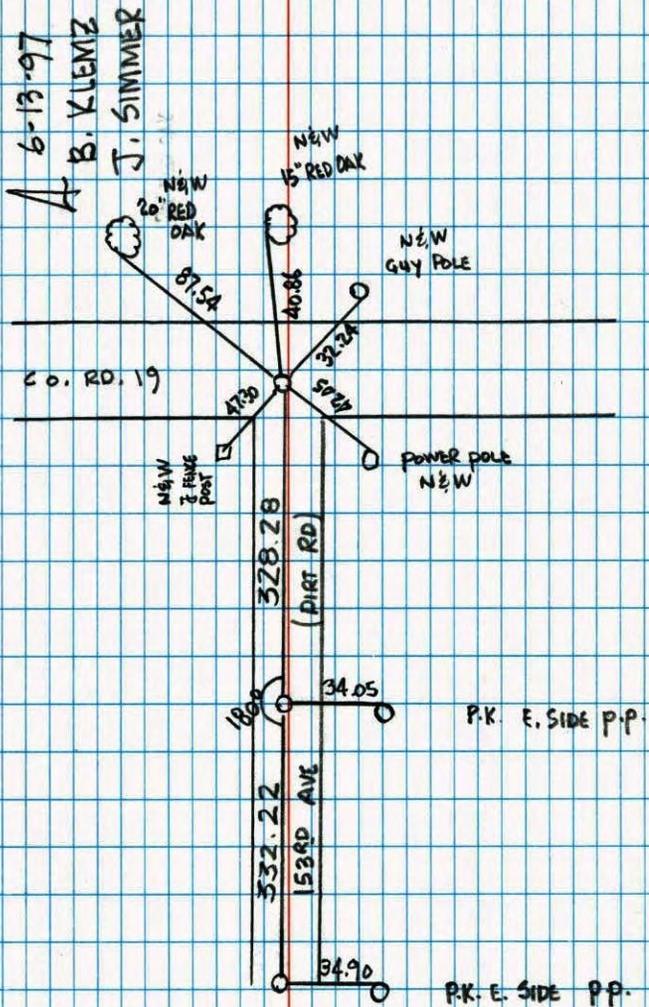


NO. 446

NATIONAL INSTRUMENT

East 1/4 Corner Sec. 21 T32 R22

Retied Cast Iron Monument

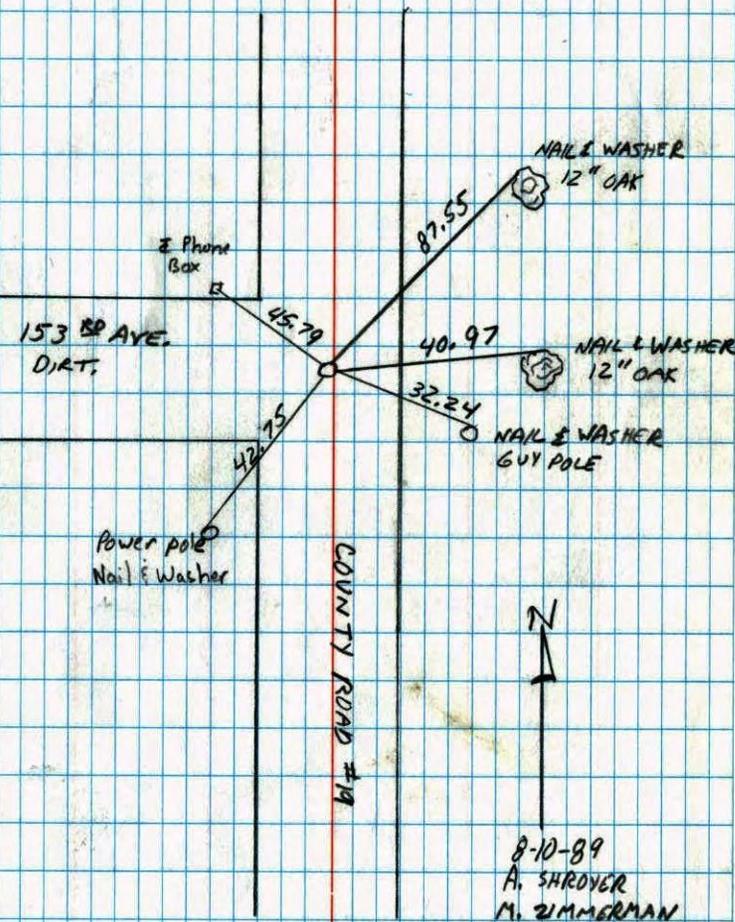

NO. 446

TELEPHONE

E $\frac{1}{4}$ Cor. Sec. 21-T32-R22

$\frac{1}{2}$ " Iron Pipe. Replaced with


Cast Iron Monument

Jim Kurth
July 14, 1967

flush. PK's 2.00'

North + East.

August 23 1968
D. Powell
R. Olson
P. Pieh

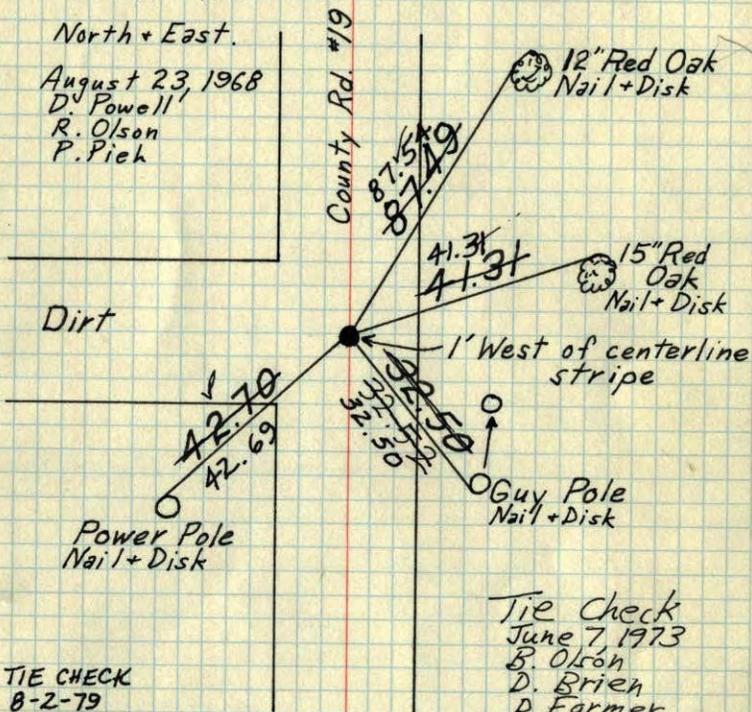

TIE CHECK
8-2-79
B. STEPHENS
D. STEPHENS
P. ROSS
TAPE #2 TEMP. 74°

Tie Check
June 7, 1973
B. Olson
D. Brien
D. Farmer

TIE CHECK
8-5-76
G. ADAMS
S. BRIEN
J. STEPHENS

TEMPERATURE CORRECTED
AND HORIZONTALLY
TAPED MEASUREMENTS


ROLAND W. ANDERSON
COUNTY SURVEYOR
ANOKA COUNTY, MINNESOTA

E $\frac{1}{4}$ Cor. Sec. 21-T32-R22

$\frac{1}{2}$ " Iron Pipe flush

PK's 2.00' N + E Jim Kurth
July 14, 1967

Replaced with
C.I. Mon. flush.

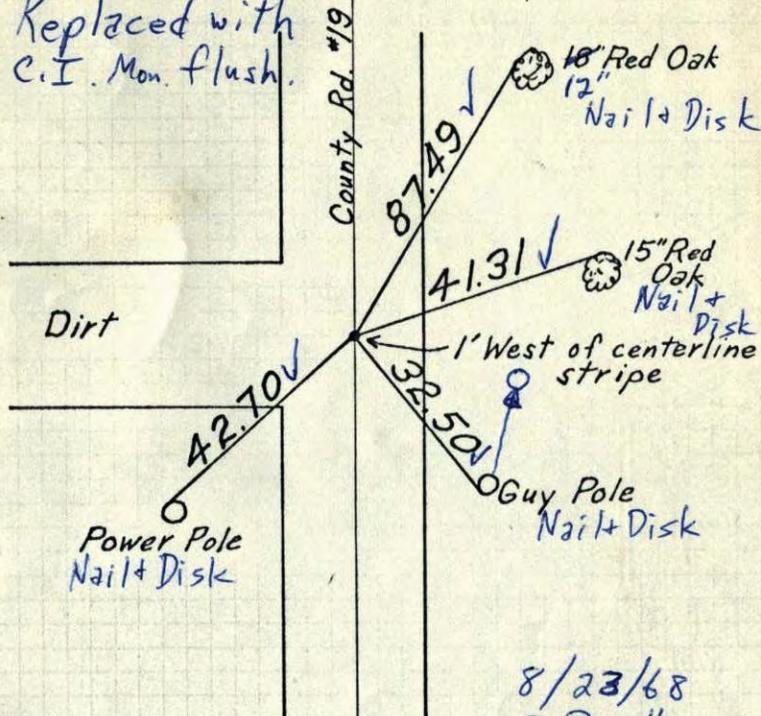

8/23/68
D. Powell
R. Olson
P. Pieh




Rocky Says...

"GREAT FOR TRAVEL • GREAT FOR FREIGHT"



E 1/4 Corn. Sec. 21

32-22

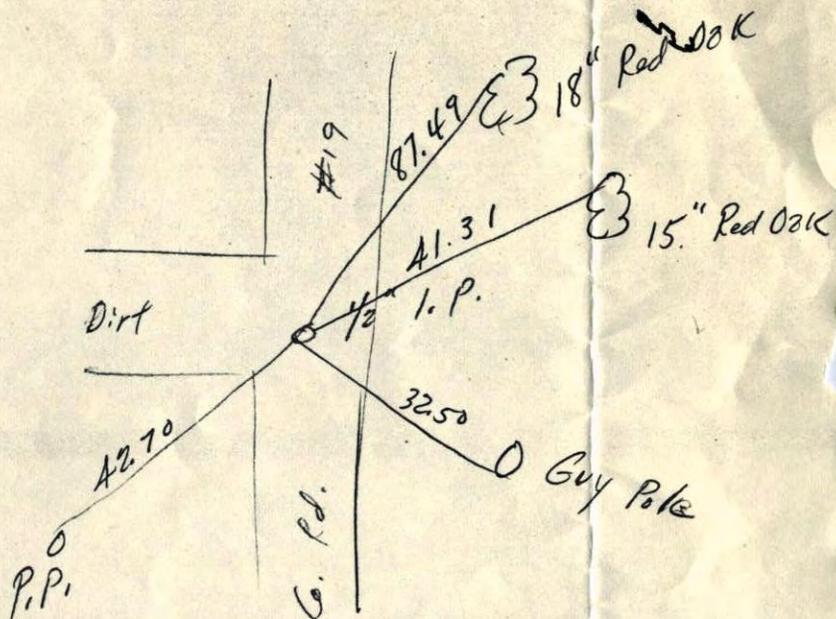

Jim Kurth
7/14/67

6075 3001066

PRINTED IN U.S.A.




Rocky Says...

"GREAT FOR TRAVEL • GREAT FOR FREIGHT"



E 1/4 Corn. Sec. 21

32-22

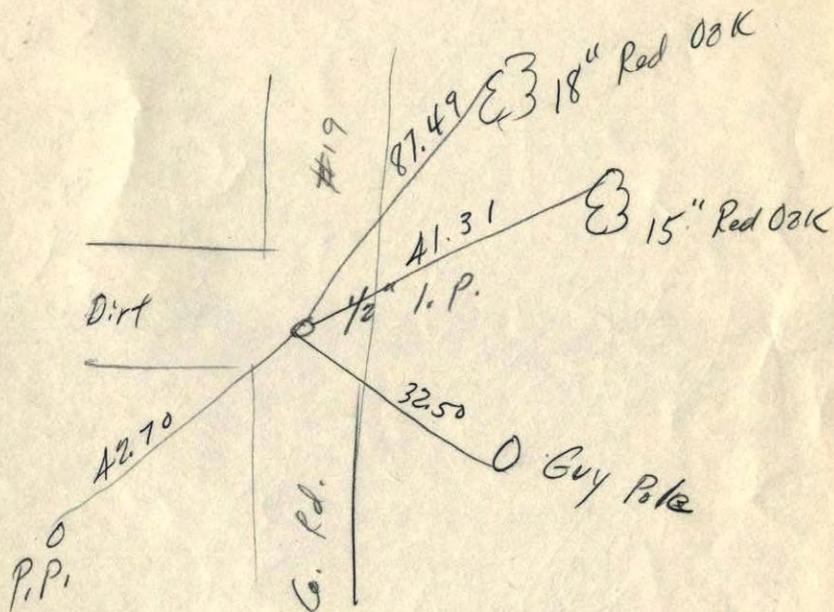

Jim Kurth
7/14/67

6075 3001066

PRINTED IN U.S.A.