

CERTIFICATE OF LOCATION OF GOVERNMENT CORNER
 County of Anoka State of Minnesota


East 1/4 Corner of Sec. 24 Township 32 Range 22

On the ___ day of July, 1967, the described corner was evidenced by a 3/4" iron pipe

and to perpetuate the location of said corner, at the exact location thereof, a permanent marker was placed consisting of a red and white iron pipe 2" PIPE (UP 3'±)
SIGN ATTACHED FACING SOUTH (800± EAST OF HORNSBY ST.)

AND on the ___ day of _____, _____, said permanent marker was _____

Updated reference ties are as shown below.

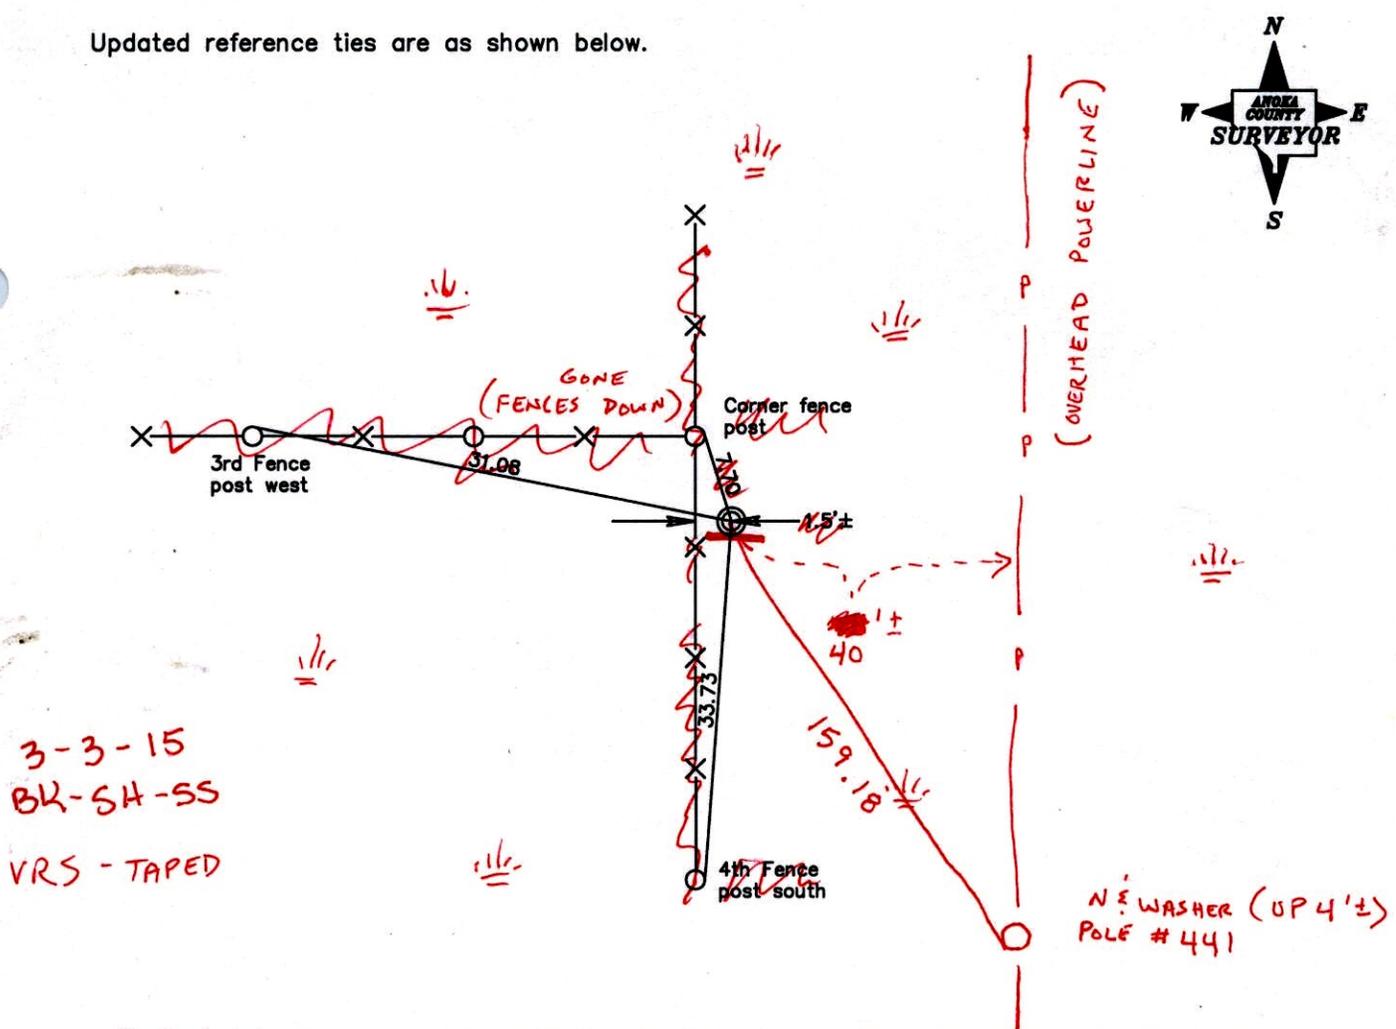

3-3-15
 BK-SH-SS
 VRS - TAPED

Revised date
1985
8/21/95

N.A.D. 1983 Coordinates (1996 Adjustment)
County Project Coordinates
Northing <u>177273.2691</u>
Easting <u>563696.6851</u>
Date <u>1/17/06</u>

I hereby certify that this United States public land survey monument record is correct and complete to the best of my knowledge and belief.

 Date _____
 Larry D. Hoium, Anoka County Surveyor
 Minnesota License Number 18165

3DQ = 0.07 N = 177273.2674 E = 563696.5809

CERTIFICATE OF LOCATION OF GOVERNMENT CORNER

County of Anoka

State of Minnesota


East 1/4 Corner of Sec. 24 Township 32 Range 22

On the ___ day of July, 1967, the described corner was evidenced by a 3/4" iron pipe

and to perpetuate the location of said corner, at the exact location thereof, a permanent marker was placed consisting of a red and white iron pipe

AND on the ___ day of _____, _____, said permanent marker was _____

Updated reference ties are as shown below.

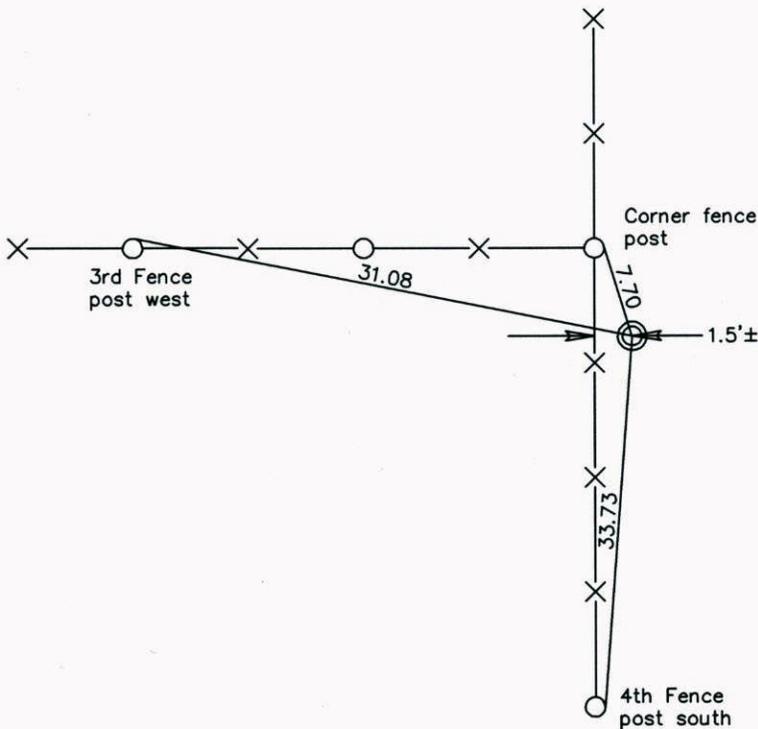

Revised date
1985
8/21/95

N.A.D. 1983 Coordinates (1996 Adjustment)	
County Project Coordinates	
Northing	<u>177273.2691</u>
Easting	<u>563696.6851</u>
Date	<u>1/17/06</u>

I hereby certify that this United States public land survey monument record is correct and complete to the best of my knowledge and belief.

Date _____

Larry D. Hoium, Anoka County Surveyor

Minnesota License Number 18165

CERTIFICATE OF LOCATION OF GOVERNMENT CORNER

County of Anoka


State of Minnesota

EAST QTR. Corner of Sec. 24 Township 32 Range 22


I hereby certify that on the day of JULY, 1967, I found the described corner which was evidenced by 3/4" I. P.

and I further certify that to perpetuate the location of said corner, I did, at the exact location thereof, place a permanent marker consisting of RED, WHITE I.P.

which reference or witness monuments are located in the manner following:

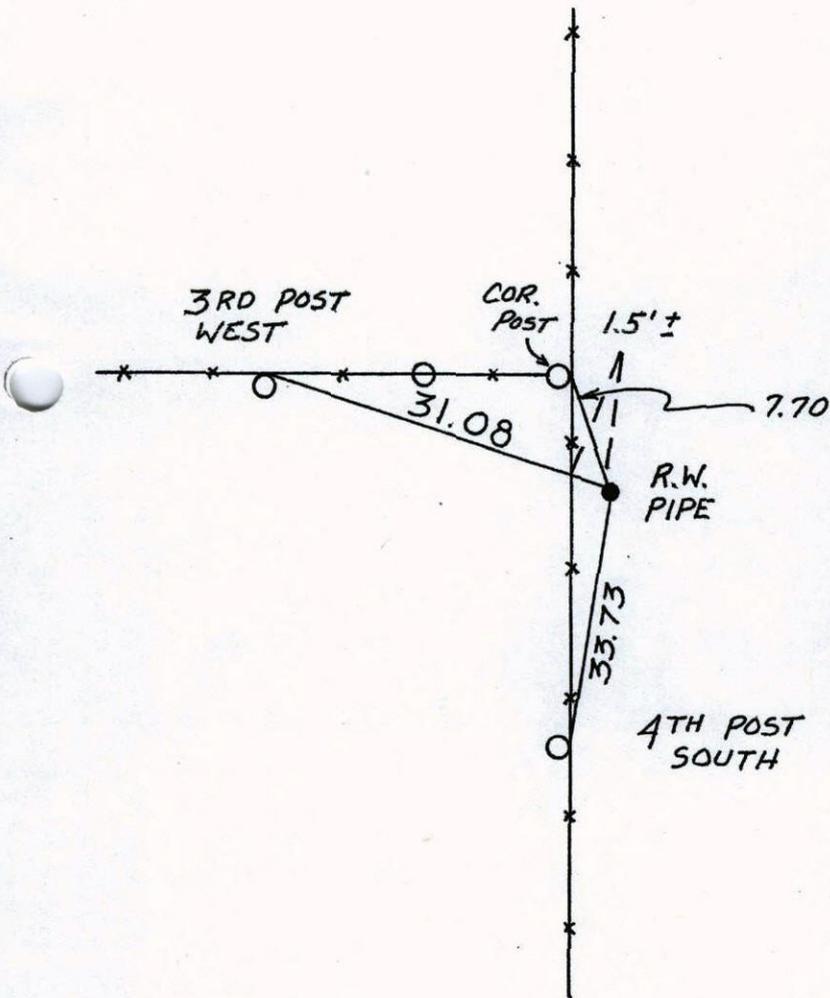

Revised date	Revised date	Revised date
WC 85		
8-21-95		

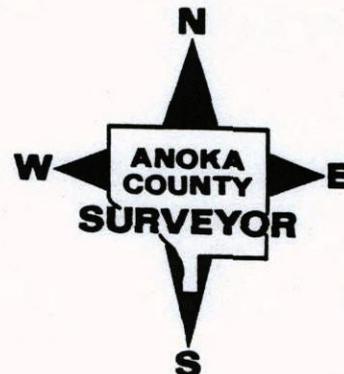

CERTIFICATE OF LOCATION OF GOVERNMENT CORNER

County of Anoka


State of Minnesota

EAST QTR. Corner of Sec. 24 Township 32 Range 22


I hereby certify that on the ___ day of JULY, 1967, I found the described corner which was evidenced by 3/4" I. P.


and I further certify that to perpetuate the location of said corner, I did, at the exact location thereof, place a permanent marker consisting of RED, WHITE I.P.

which reference or witness monuments are located in the manner following:

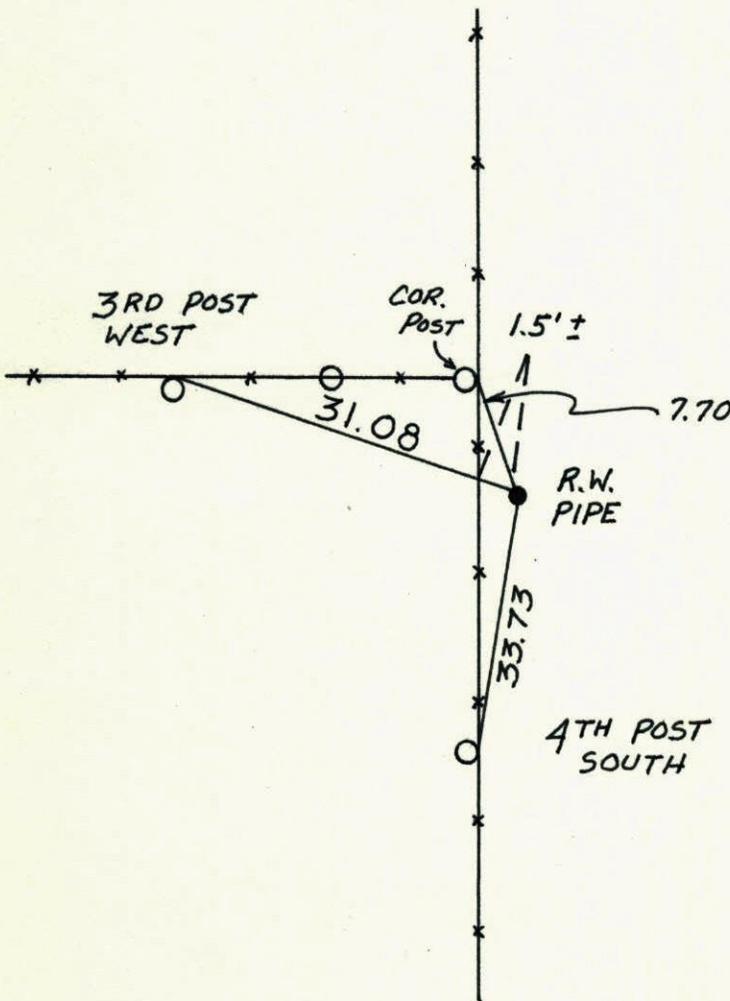


Revised date	Revised date	Revised date
WC 85		
8-21-95		

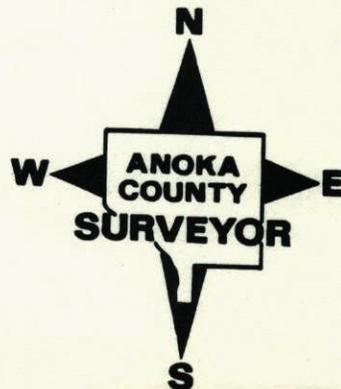

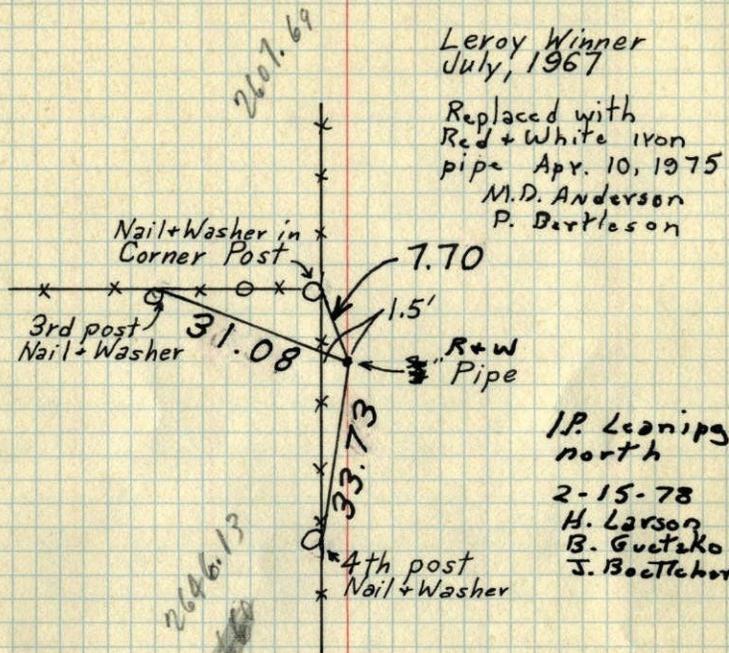E $\frac{1}{4}$ Cor. Sec. 24-T32-R22 $\frac{3}{4}$ " Pipe up 2' in swampLeroy Winner
July, 1967Replaced with
Red + White iron
pipe Apr. 10, 1975
M.D. Anderson
P. BertlesonJ.P. Leaning
north2-15-78
H. Larson
B. Gustako
J. BoettcherWet 8/23/68
Tie Check
June 29, 1970
D. Powell
R. Brien
W. Westlander

TEMPERATURE CORRECTED
AND HORIZONTALLY
TAPED MEASUREMENTS

ROLAND W. ANDERSON
COUNTY SURVEYOR
ANOKA COUNTY, MINNESOTA

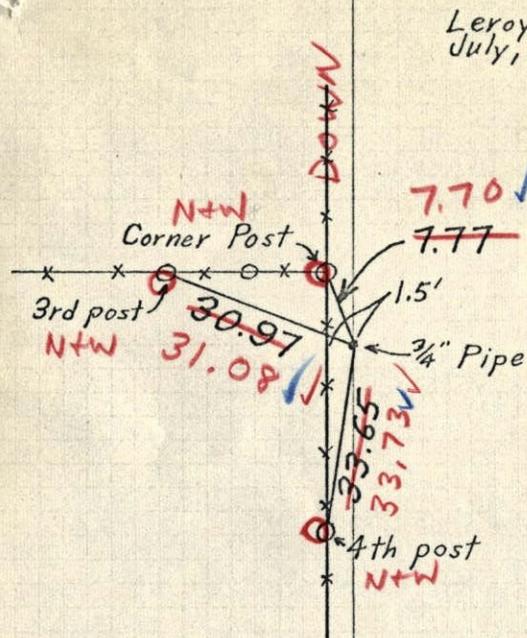
E $\frac{1}{4}$ Cor. Sec. 24-T32-R22 $\frac{3}{4}$ " Pipe up 2' in swampLeroy Winner
July, 1967

Wet 8/23/68

6/29/70
#10-908
D. Powell
R. Brien
W. Westlander

E $\frac{1}{4}$ Cor. Sec. 24-T32-R22

$\frac{3}{4}$ " Pipe up 2' in swamp

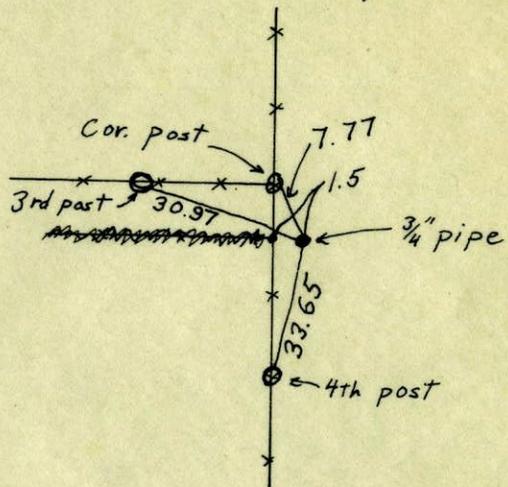

Leroy Winner
July, 1967