CERTIFICATE OF LOCATION OF GOVERNMENT CORNER

'County of Anoka State of Minnesota

North 1/4 Corner of Sec. 29 Township 33 Range 22

On the 28th day of August, 1963, the described corner was evidenced by a concrete monument

and to perpetuate the location of said corner, at the exact location thereof, a permanent marker was placed consisting of the same concrete monument with a sign and post on the north side

AND on the 13th day of May, 2004, said permanent marker was found and the ties were updated

Updated reference ties are as shown below.

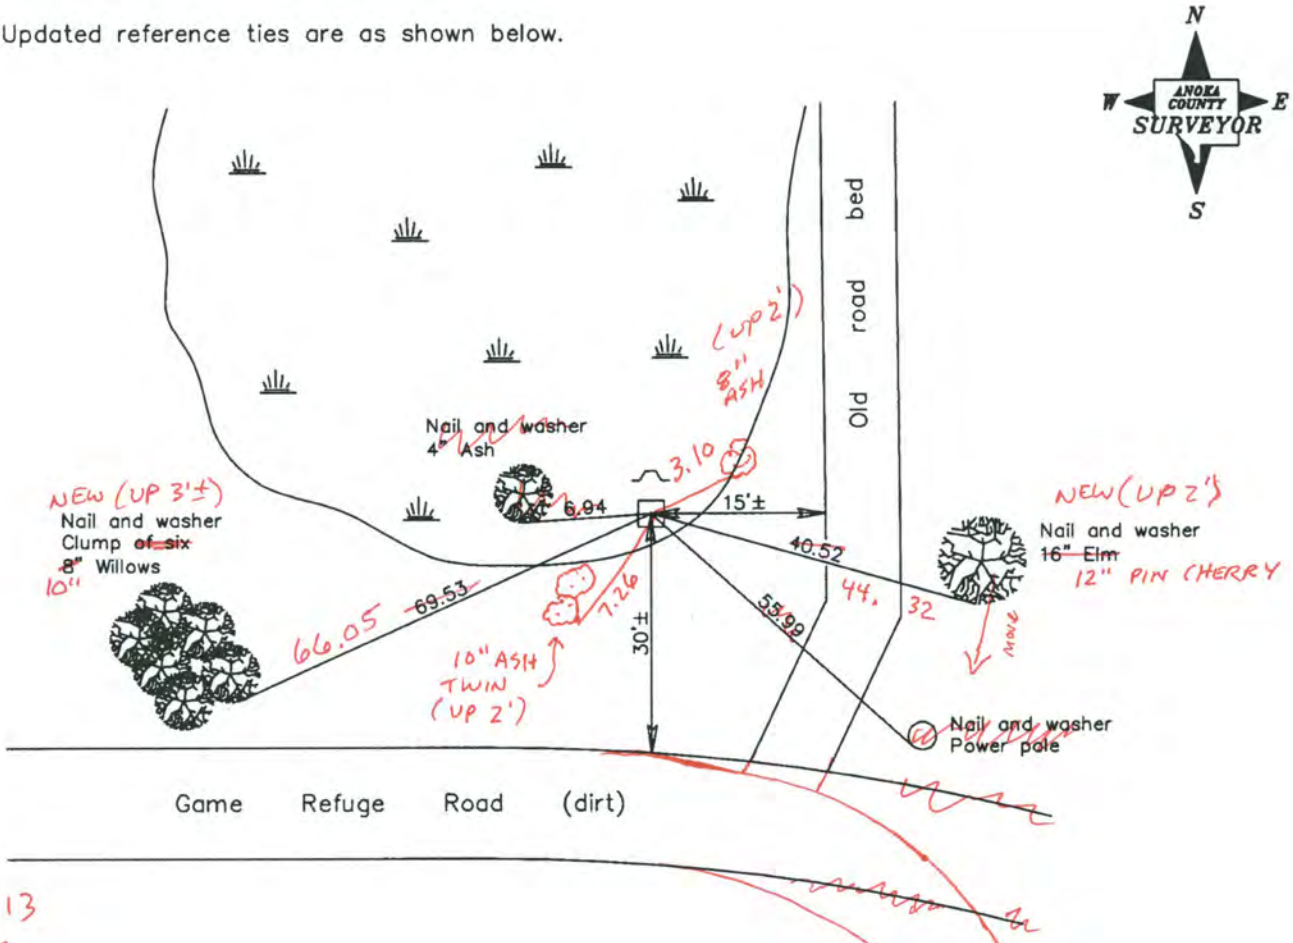

12-20-13
BK-55
T/T - TAPED

Revised date

10/23/90
6/15/93
5/13/04

3D=0.08

N.A.D. 1983 Coordinates
(1996 Adjustment)

County Project Coordinates	
Northing	206131.4676
Easting	539570.8771
Date	5/13/04

I hereby certify that this United States public land survey monument record is correct and complete to the best of my knowledge and belief.

Larry D. Hoium Date 5/13/04

Larry D. Hoium, Anoka County Surveyor

Minnesota License Number 18165

N=206131.4515 E=539570.8428

CERTIFICATE OF LOCATION OF GOVERNMENT CORNER

County of Anoka State of Minnesota

NORTH 1/4 Corner of Sec. 29 Township 33 Range 22

I hereby certify that on the 28 day of AUGUST, 19 63, I found the described corner which was evidenced by CONCRETE

and I further certify that to perpetuate the location of said corner, I did, at the exact location thereof, place a permanent marker consisting of SAME SIGN & POST ON NORTH SIDE

which reference or witness monuments are located in the manner following:

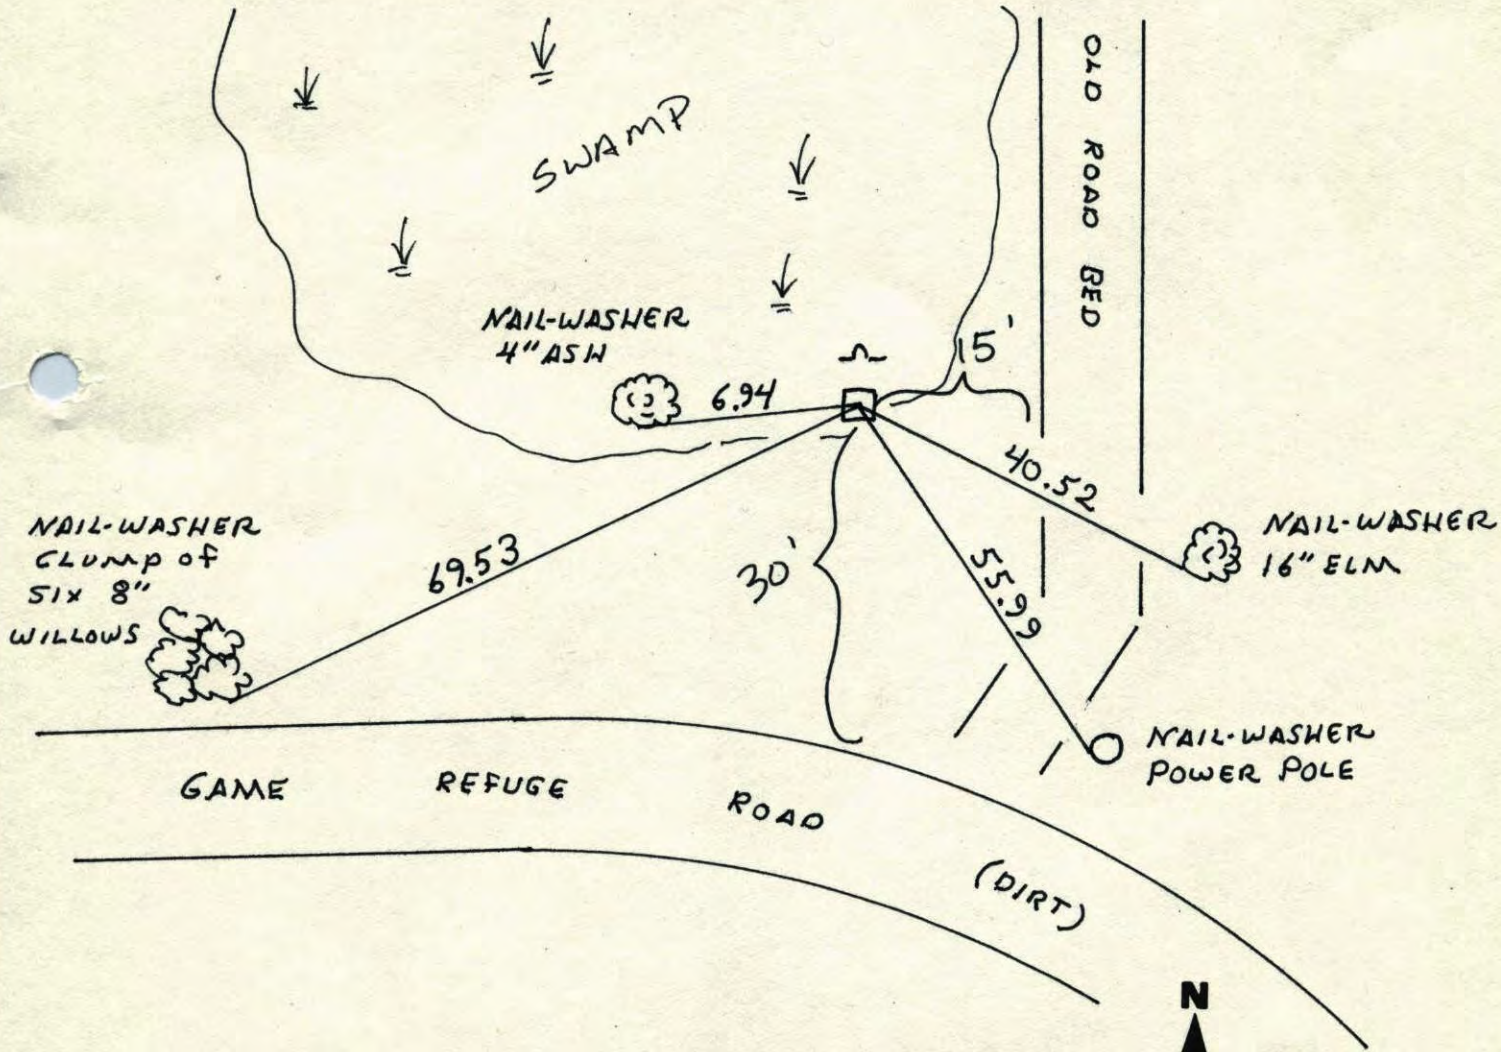

Revised date	Revised date	Revised date
10-23-90		
6-15-93		
7-4-04		

N
W ANOKA COUNTY SURVEYOR E
S

NORTH 1/4 COR. SEC. 29 T33 R22

RETIED CONCRETE MONI.
SIGN + POST ON NORTH SIDE

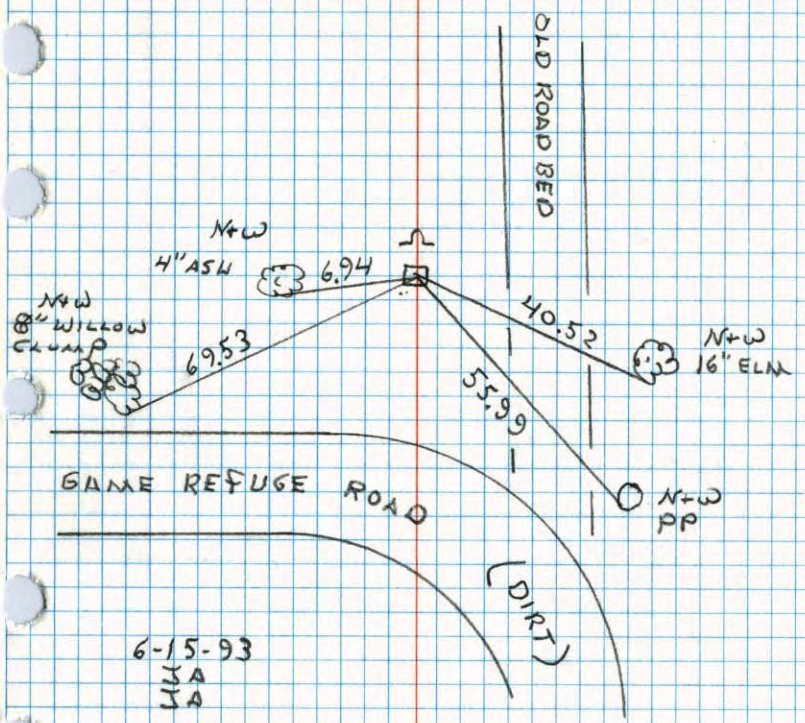

6-15-93
JA
JA

NO. 448
TELEDYNE

100

N 1/4 CORNER SECTION 29 - T33 - R22

4" SQUARE CONCRETE MONUMENT FLUSH AMID CLUSTER OF 4 STEEL FENCE POSTS. PK SPIKE IN CENTER OF CONCRETE MONUMENT.

28 AUG 63
J. OLIVER
M. O. ANDERSON
E. MADSON

Tie Check
8-12-81
P. Ross
D. Hovuby
G. Neffinger

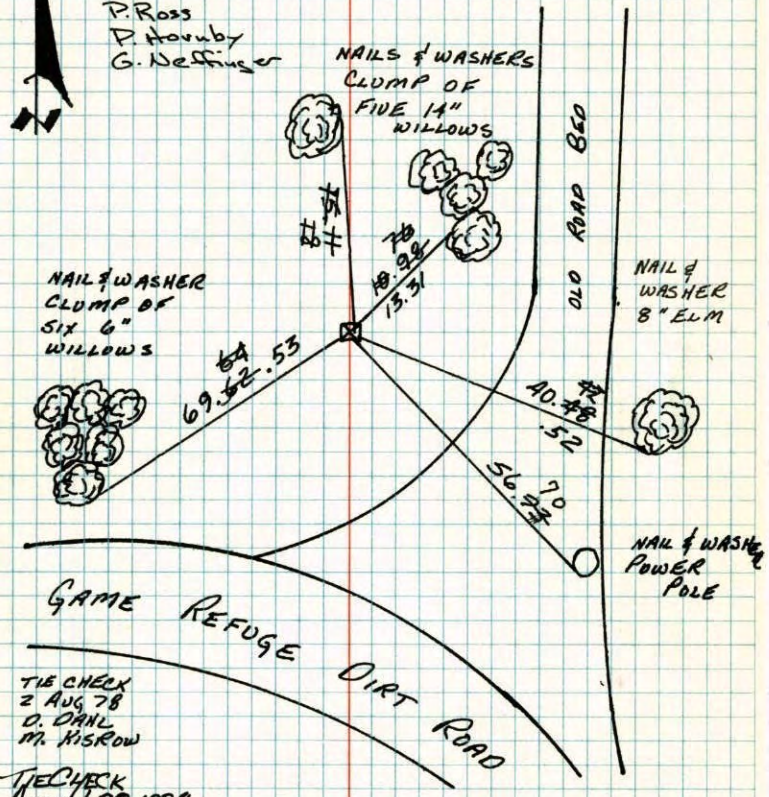

TIE CHECK
2 AUG 78
O. OHNL
M. KISROW

TIE CHECK
August 28, 1989
Q. Lips
D. Ross
D. Vogel

TEMPERATURE CORRECTED
AND HORIZONTALLY
TAPED MEASUREMENTS

ROLAND W. ANDERSON
COUNTY SURVEYOR
ANOKA COUNTY, MINNESOTA

NO. 448
TELEDYNE

N 1/4 Cor. Sec 29 T33 R22

4" Sq. Concrete Mon. Flush Amid Cluster of 4 Steel Fence Posts. PK Spike in center of Conc. Mon.

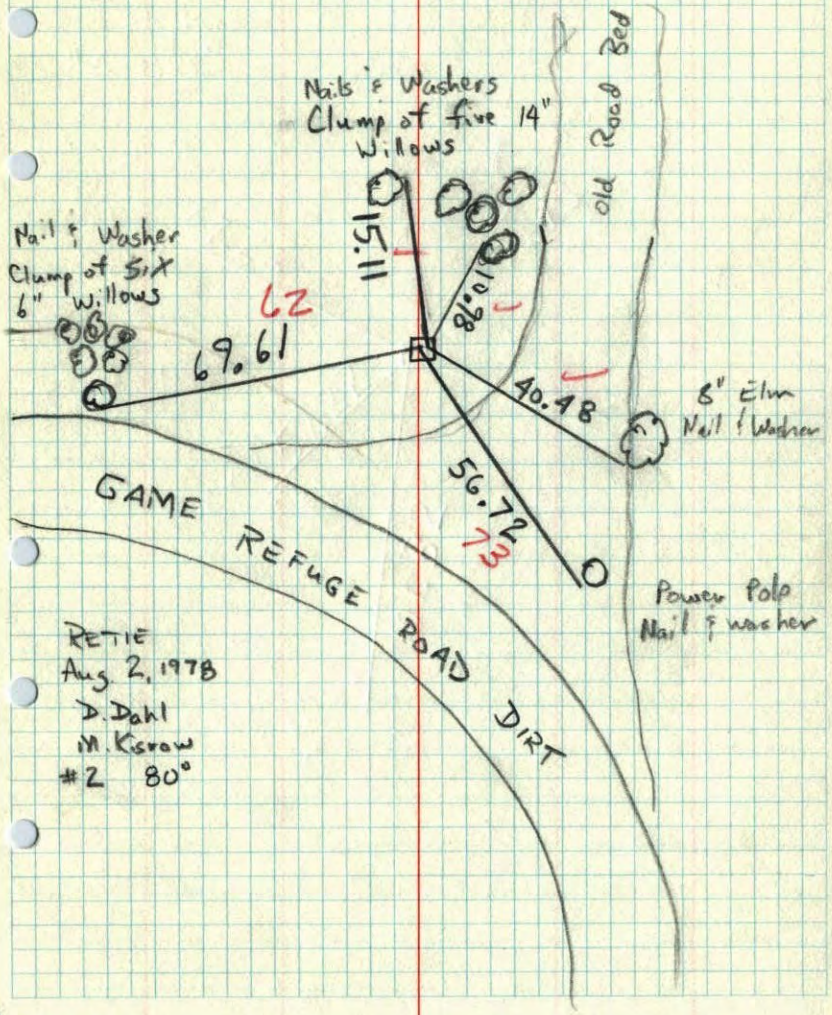

RETIE
Aug. 2, 1978
D. Dahl
M. Kisrow
#2 80°

100

N 1/4 COR. SEC. 29 T33, R22
FOUND 4" SQ. CONC. MON. FLUSH AMID CLUSTER OF 5 STEEL FENCE POSTS.
P.K. SPIKE IN CENTER OF CONC. MON.

AUG. 28, 1963
J. OLIVER
M. D. ANDERSON
E. MADSON

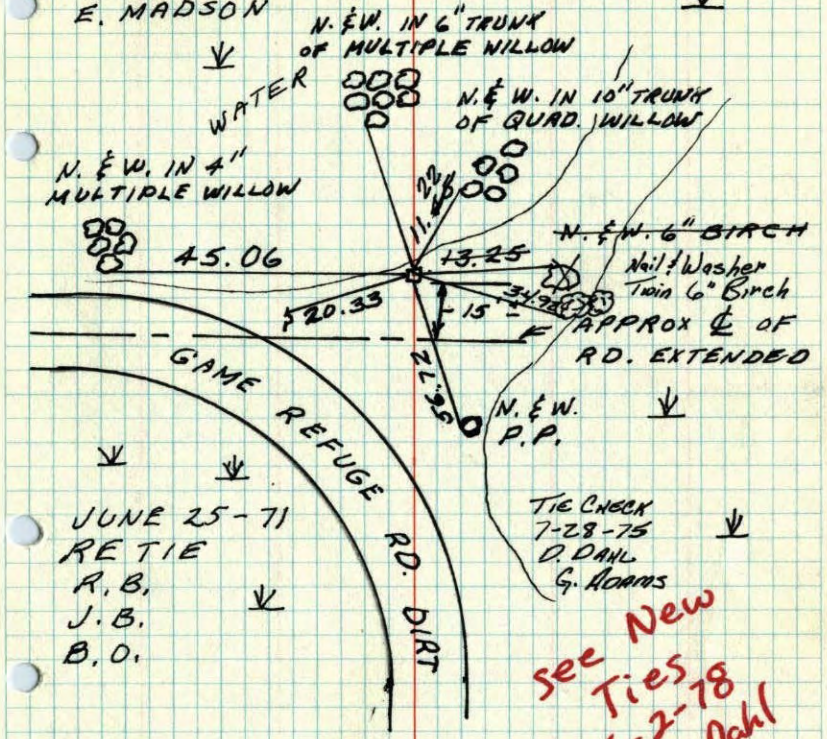

JUNE 25-71
RETIE
R. B.
J. B.
B. O.

TIE CHECK
7-28-75
D. DAHL
G. ADAMS

see New Ties 8-2-78 D. Dahl

TEMPERATURE CORRECTED AND HORIZONTALLY TAPED MEASUREMENTS

ROLAND W. ANDERSON
COUNTY SURVEYOR
ANOKA COUNTY, MINNESOTA

N1/4 Cor. Sec. 29, T. 33, R. 22

Found 4" Sq. Conc. Mon. flush amid cluster of 5 steel fence posts.

Tie Check
July 7 1967
D. Potter
D. Powell

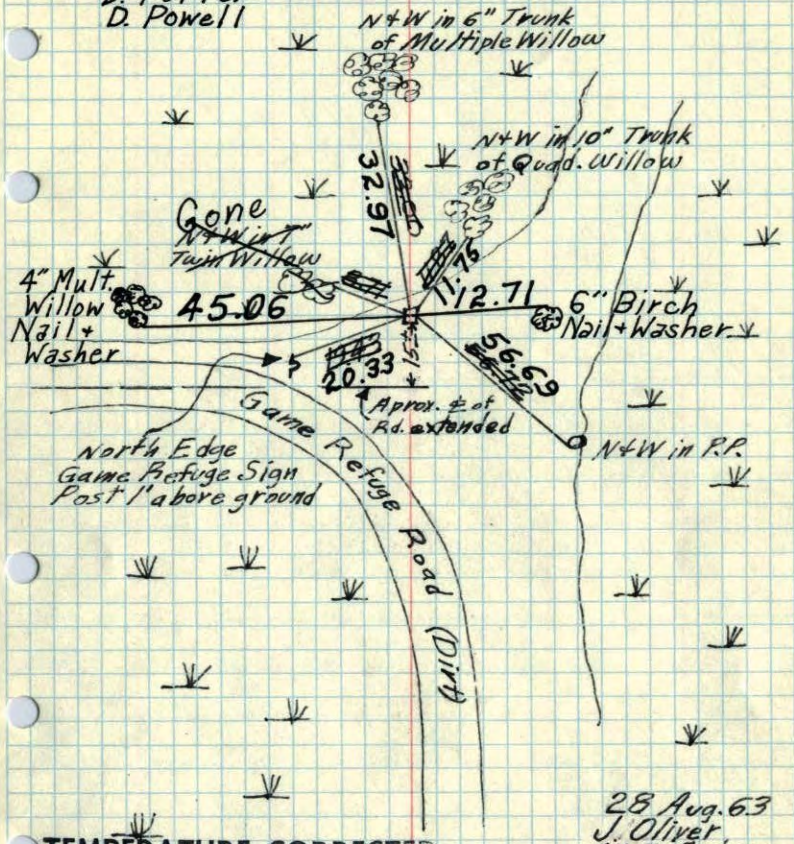

28 Aug. 63
J. Oliver
M. D. Anderson
E. Madson

TEMPERATURE CORRECTED AND HORIZONTALLY TAPED MEASUREMENTS

ROLAND W. ANDERSON
COUNTY SURVEYOR
ANOKA COUNTY, MINNESOTA

X

N1/4 Cor. Sec. 29, T. 33, R. 22

Found 4" Sq. Conc. Mon. flush amid cluster of 5 steel fence posts.

7/7/67
D. POTTER
D. POWELL
#7-72

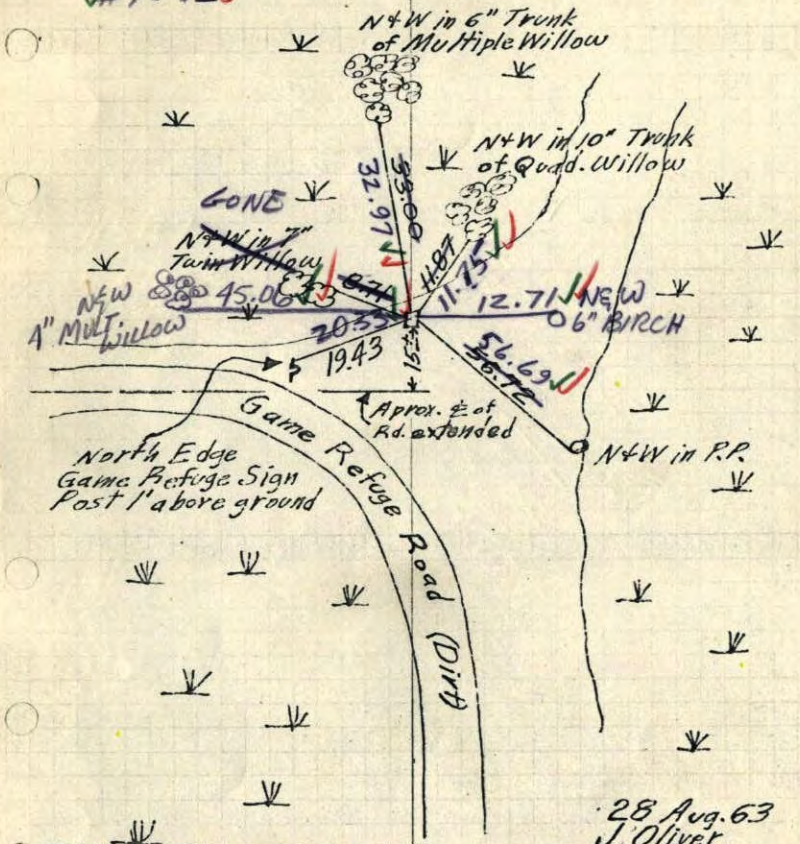

28 Aug. 63
J. Oliver
M. D. Anderson
E. Madson

TEMPERATURE CORRECTED AND HORIZONTALLY TAPED MEASUREMENTS

ROLAND W. ANDERSON
COUNTY SURVEYOR
ANOKA COUNTY, MINNESOTA

N 1/4 Cor. Sec. 29, T 33, R 22
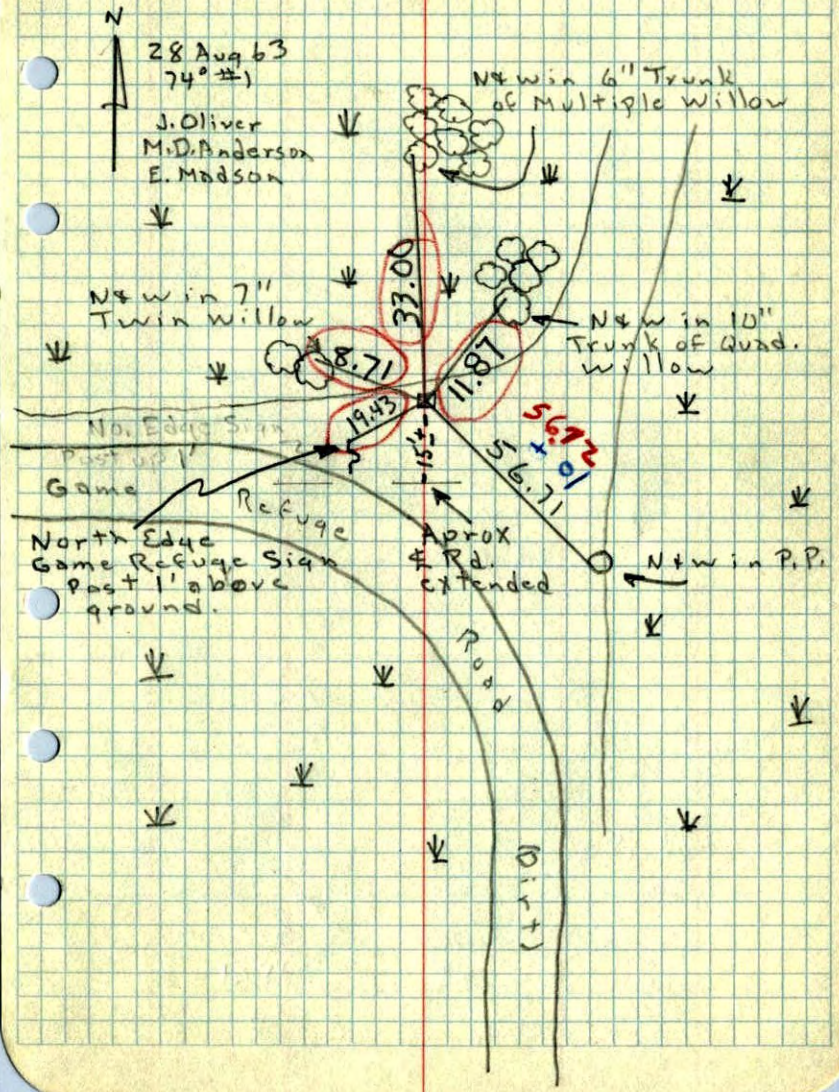
Found 4" Sq. Conc. Mon. Flush amid cluster of 5 Steel Fence Posts.