CERTIFICATE OF LOCATION OF GOVERNMENT CORNER

County of Anoka State of Minnesota

SOUTH 1/16 OF THE SOUTHWEST 1/4 Corner of Sec. 27 Township 31 Range 23

I hereby certify that on the 25 day of JULY, 1968, I found the described corner which was evidenced by A 1" IRON PIPE

and I further certify that to perpetuate the location of said corner, I did, at the exact location thereof, place a permanent marker consisting of A 1" IRON PIPE

which reference or witness monuments are located in the manner following:

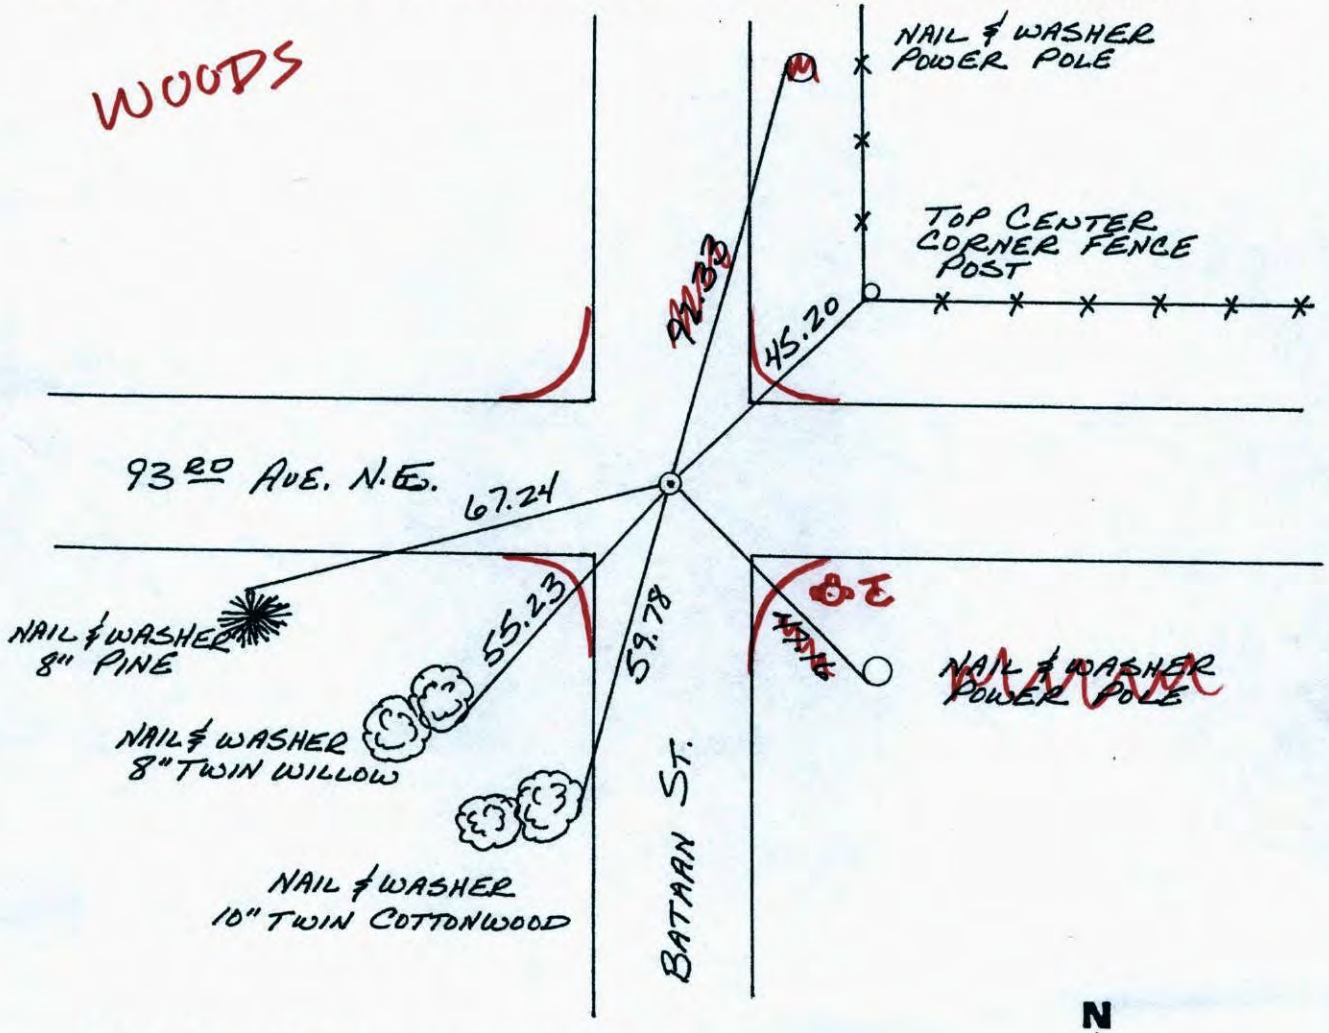

Revised date	Revised date	Revised date

South 1/16 of Southwest 1/4 Corner Sec. 27 T31 R23

Refied 1" Iron Pipe

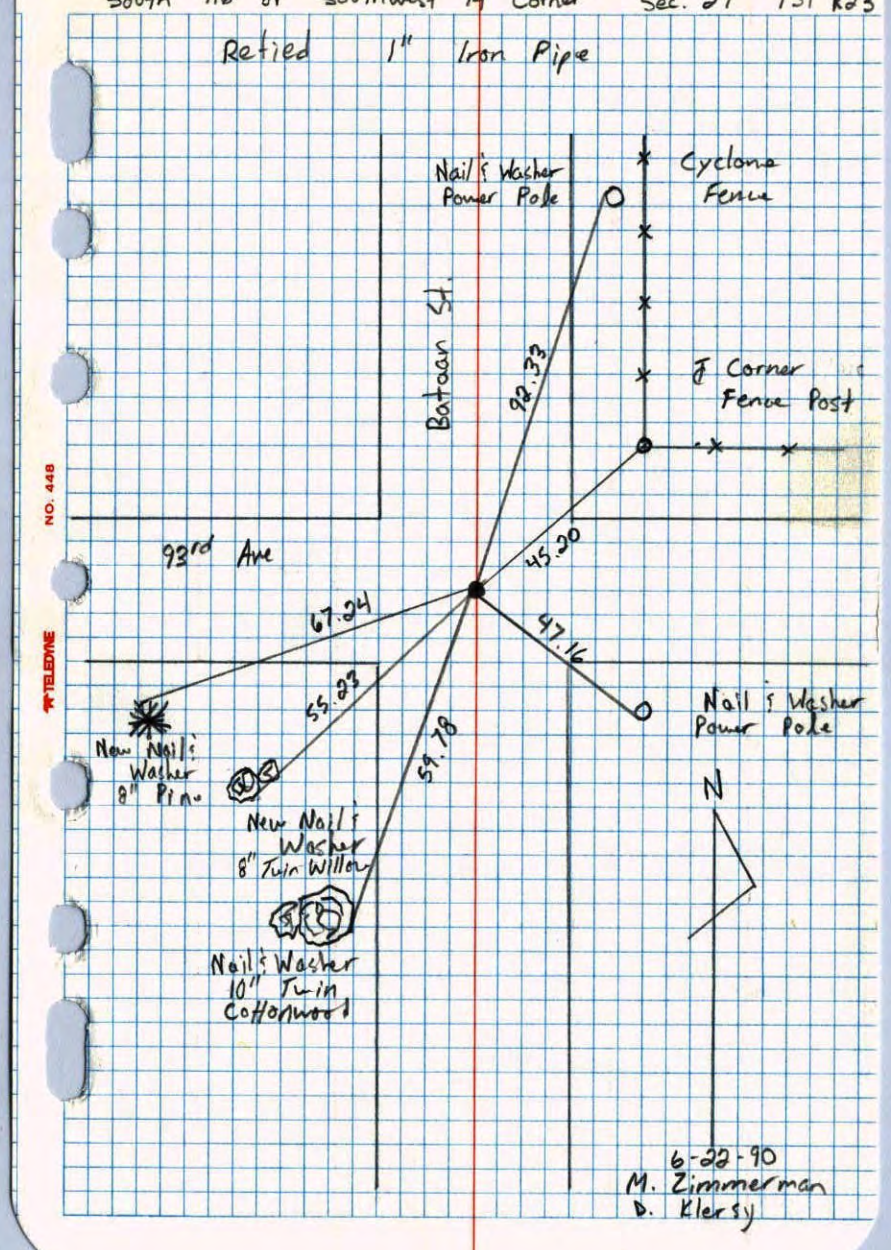

NO. 448 TELEDYNE

101

S 1/16 Cor. Of SW 1/4 Of Sec. 27 T31-R.23

FOUND AND TIED 1" IRON PIPE DOWN .5'±.

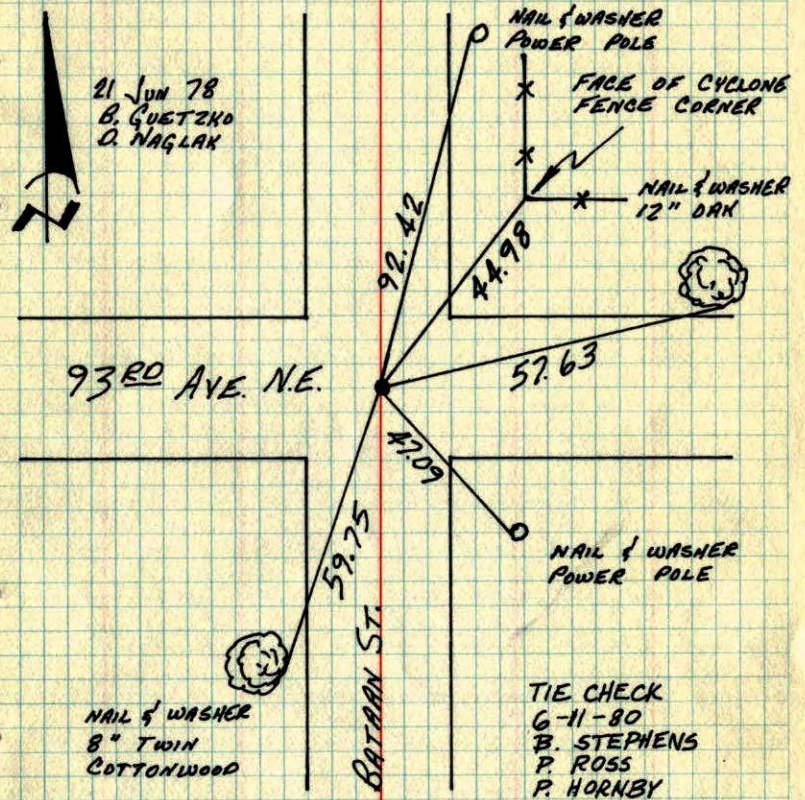

TEMPERATURE CORRECTED AND HORIZONTALLY TAPED MEASUREMENTS

ROLAND W. ANDERSON
COUNTY SURVEYOR
ANOKA COUNTY, MINNESOTA

S 1/16 CORNER OF SW 1/4 OF SEC. 27 T31 R23

FOUND AND TIED 1" IRON PIPE DOWN .5'±

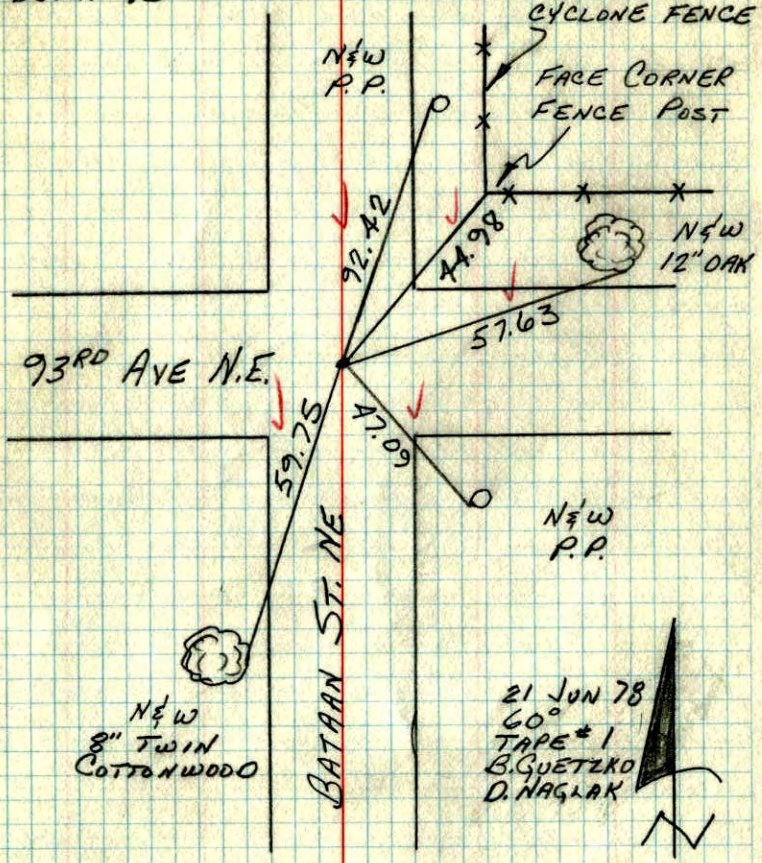

S 1/16 CORN of SW 1/4 COR N. of SEC 27, T31, R23

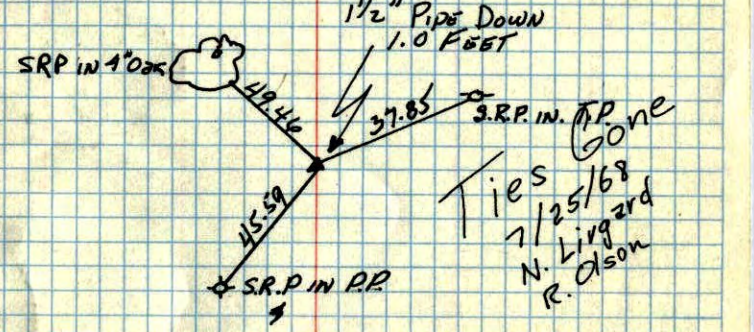

Ties Gone
7/25/68
N. Livgard
R. Olson