NW COR. OF NE¼ OF NE¼ SEC 30 T33 R22

RETTE CAST IRON MONUMENT

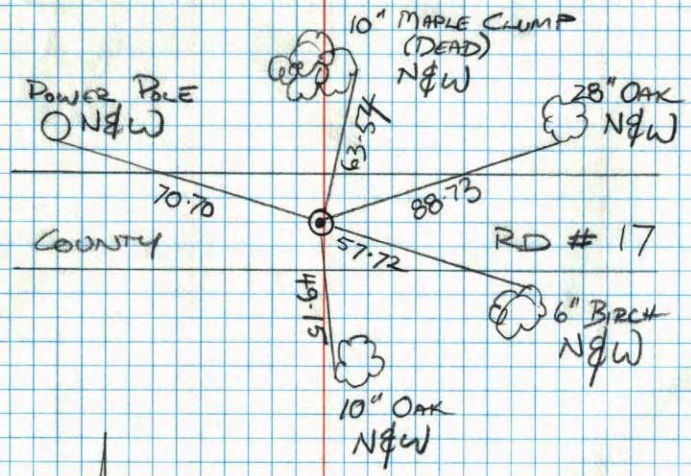

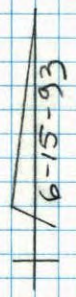

JAMIE ANDERSON

JOSH ANDERSON

N.W. Cor. of N.E. ¼ of N.E. ¼ of Sec. 30-T.33-R22

Set Cast Iron Monument from survey

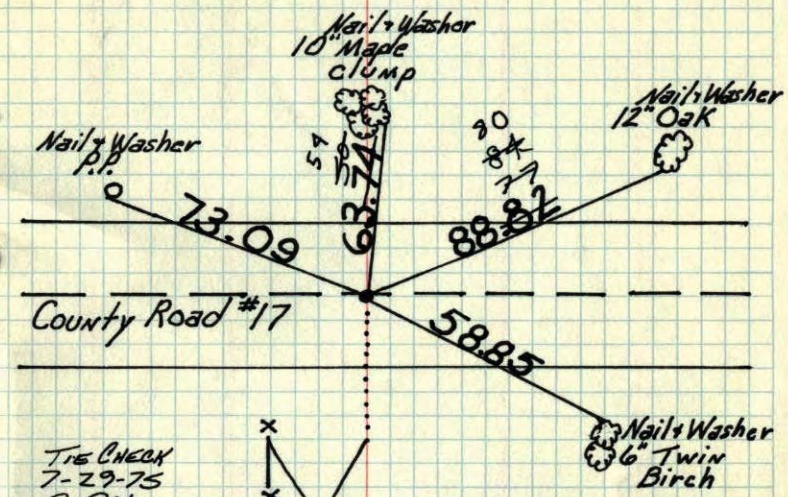

TIE CHECK
7-29-75
O. OAHL
B. SANNERUD
G. ADAMS

Tie Check
8-12-81
T. Ross
P. Hoeub
G. Neffinger

TIE CHECK
August 27, 1984
G. Lips
D. Ross
D. Vogel

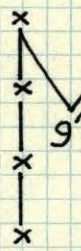

4/16/73
H. Larson
P. Bertleson
J. Boectcher
Tape #13
Temp. 40°

Tie Check
7-28-78
M. Kisrow
B. Stephens

TEMPERATURE CORRECTED AND HORIZONTALLY TAPED MEASUREMENTS

ROLAND W. ANDERSON
COUNTY SURVEYOR
ANOKA COUNTY, MINNESOTA

NW Cor. of NE 1/4 of NE 1/4 of Sec. 30 T33 R22

Set cast iron monument from survey

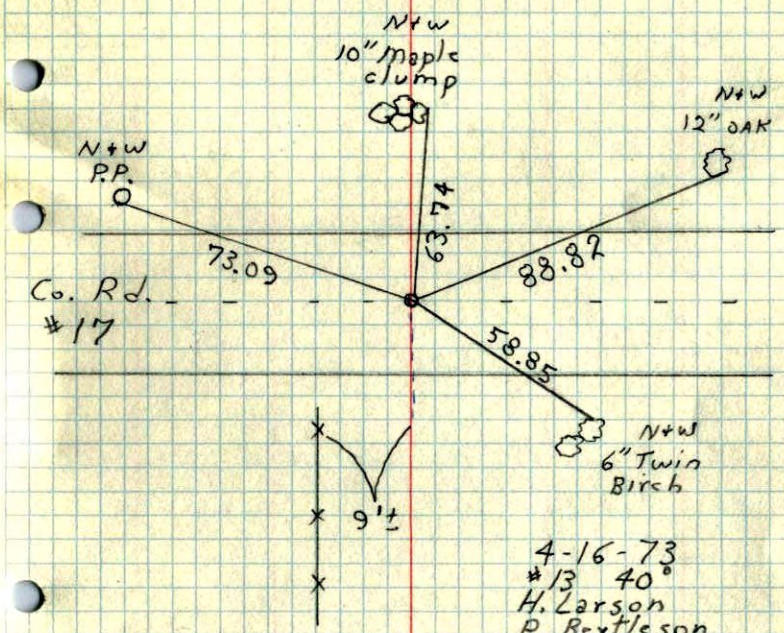

4-16-73
#13 40°
H. Larson
P. Bertleson
J. Boetcher

O.K.