N.W. Cor. of N.E. ¼ of S.E. ¼ of Sec. 30-T33-R22

Set Cast Iron Monument from survey

4/16/73
H. Larson
P. Bartleson
J. Boecher

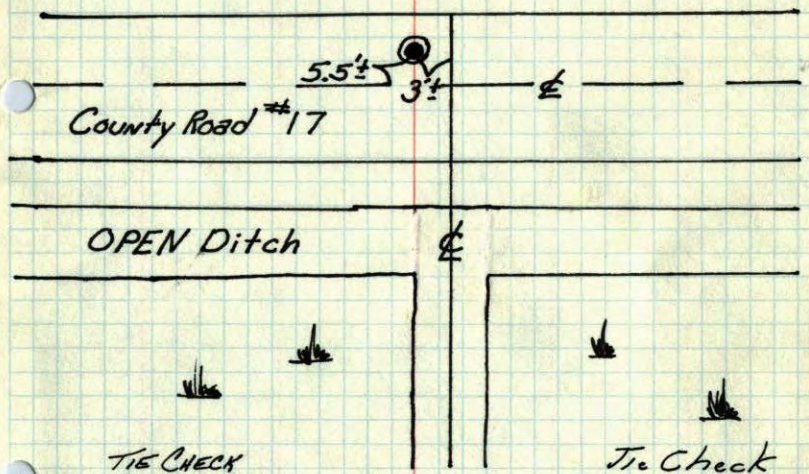

TIE CHECK
7-29-75
O. OANC

Tie Check
7-28-78
M. Kisrow
B. Stephens

Reset Cast Iron flush to blacktop
SET P.K.'s 2.00' NORTH & EAST
JULY 20, 1977
R. SAUNERUD
S. BRIEN
J. STEPHENS

Tie Check
8-14-81
P. Ross
P. Hornby
G. Deffinger

TIE CHECK
August 27, 1984
D. Ross
D. Vogel

TEMPERATURE CORRECTED
AND HORIZONTALLY
TAPED MEASUREMENTS

ROLAND W. ANDERSON
COUNTY SURVEYOR
ANOKA COUNTY, MINNESOTA

N.W. Cor. of N.E. ¼ of S.E. ¼ of Sec.
30-T33-R22 Set Cast Iron
From Survey

4-16-73
H. Larson
P. Bartleson
J. Boecher

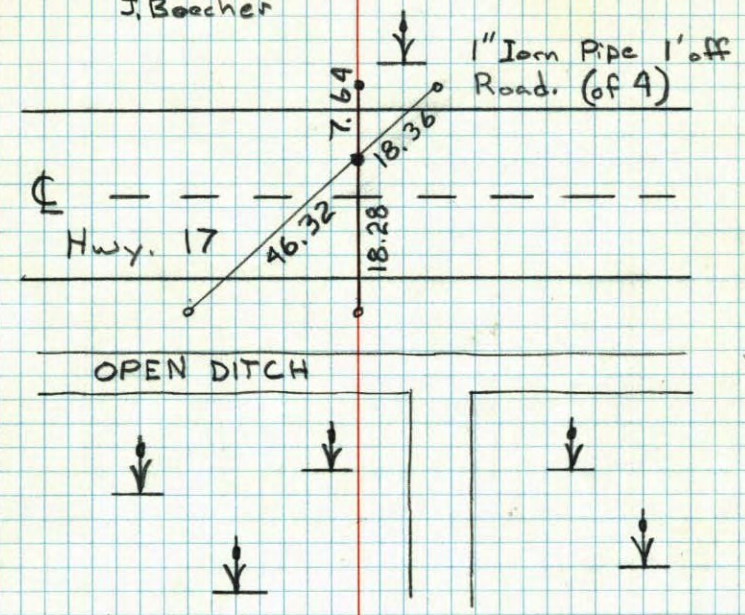

Reset + Retied
7-27-82
P. Ross
P. Hornby
M. Lick

NO. 448
TELEDYNE

NW Cor. of NE 1/4 of SE 1/4 of Sec. 30 T33 R22

Set cast iron monument from survey.

4-16-73
#13 40°
H. Larson
P. Bertleson
J. Beochter

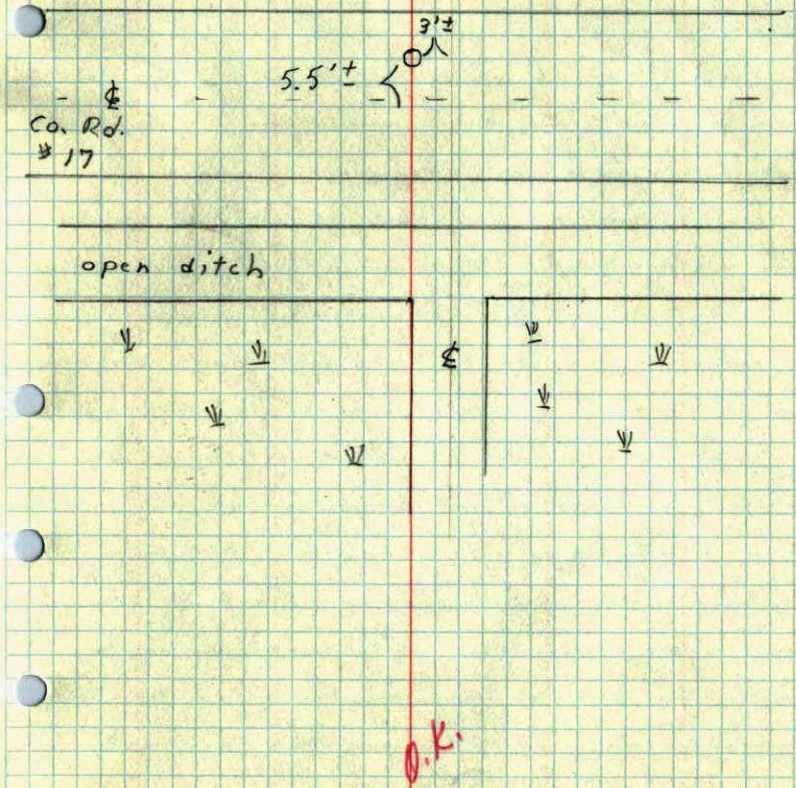

O.K.