Page No. 108

CERTIFICATE OF LOCATION OF GOVERNMENT CORNER

County of Anoka State of Minnesota

East 1/4 Corner of Sec. 30 Township 33 Range 22

On the 16th day of April, 1973, the described corner was evidenced by area resurvey

and to perpetuate the location of said corner, at the exact location thereof, a permanent marker was placed consisting of a cast iron monument (DOWN 0.5'±) * ADDED SIGN & POST ON E. SIDE OF MON. FACING WEST

AND on the ___ day of _____, ____, said permanent marker was _____

Updated reference ties are as shown below.

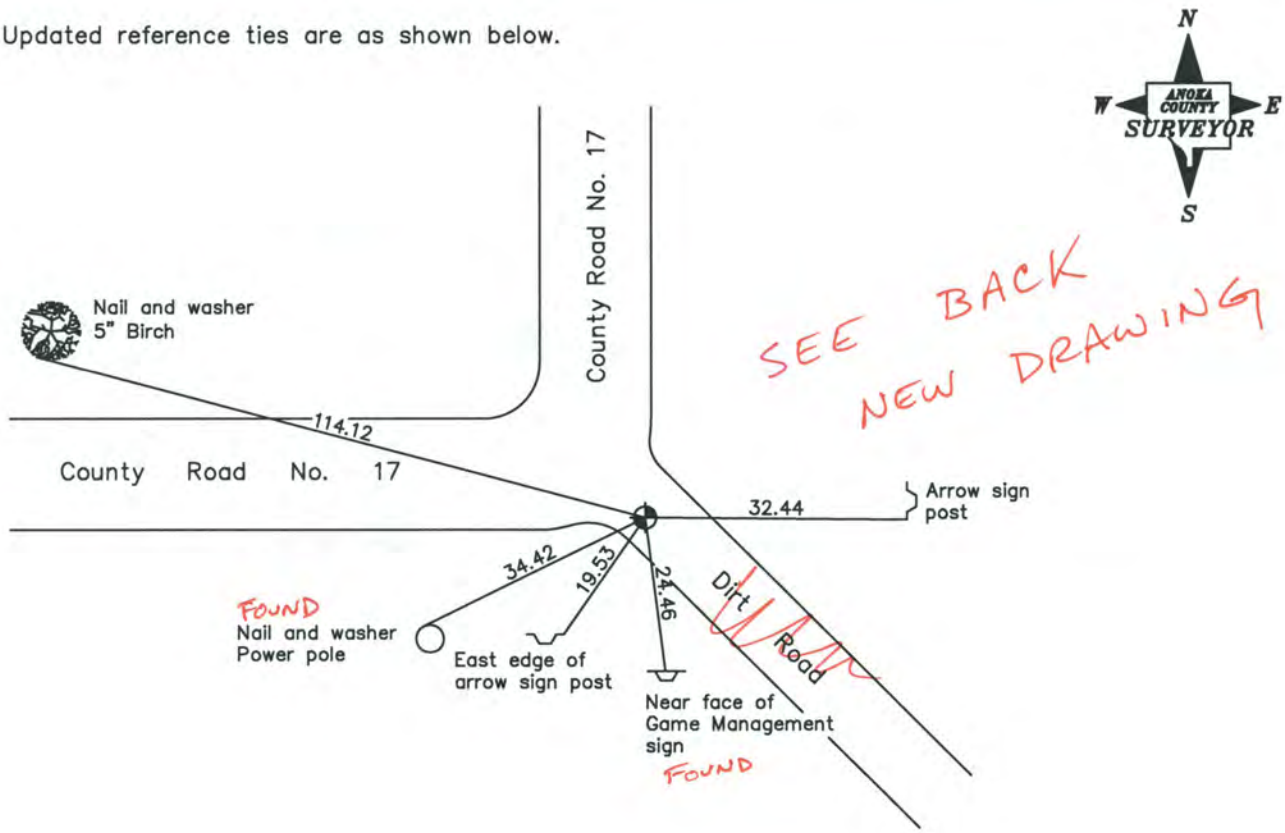

5-8-14
BK-55
T/T

Revised date
8/12/81
8/28/84
8/05/87

N.A.D. 1983 Coordinates (1996 Adjustment)

County Project Coordinates	
Northing	203492.3677
Easting	537026.8575
Date	7/01/03

I hereby certify that this United States public land survey monument record is correct and complete to the best of my knowledge and belief.

_____ Date _____

_____, Anoka County Surveyor

Minnesota License Number _____

VRS
3DQ=0.05 N=203492.3243 E=537026.8134

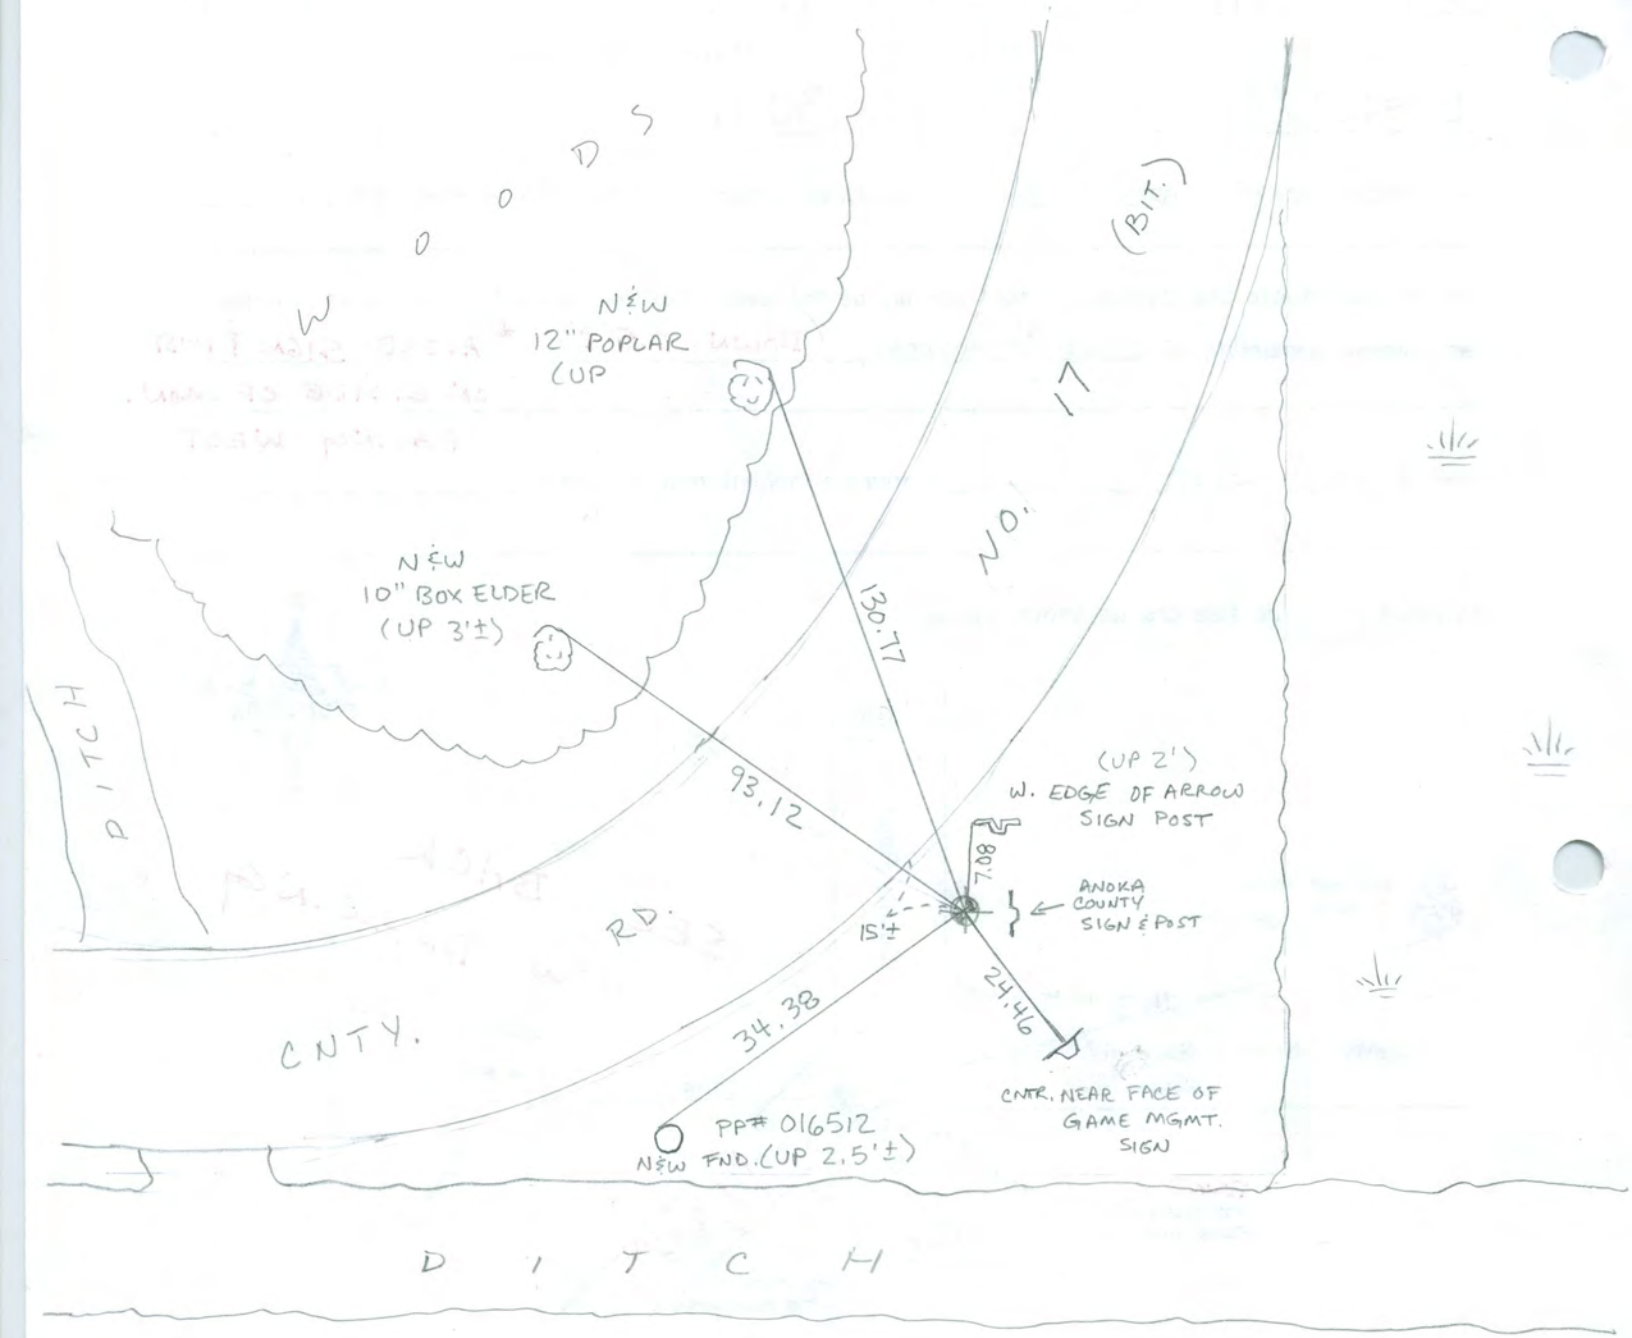
W O O D S
N&W
12" POPLAR
(UP
NO. 17
(BIT.
N&W
10" BOX ELDER
(UP 3'±)
130.77
93.12
(UP 2')
W. EDGE OF ARROW
SIGN POST
ANOKA
COUNTY
SIGN & POST
15'±
24.46
34.38
CNTY.
RD.
DITCH
CNTR. NEAR FACE OF
GAME MGMT.
SIGN
PP# 016512
N&W FND. (UP 2.5'±)
D I T C H

SHOT GPS 7-1-03

Page No. 108

CERTIFICATE OF LOCATION OF GOVERNMENT CORNER

County of Anoka *State of Minnesota*

East One Quarter Corner of Sec. 30 Township 33 Range 22

I hereby certify that on the 16 *day of* April, 1973, *I found the described corner which was evidenced by* area resurvey

and I further certify that to perpetuate the location of said corner, I did, at the exact location thereof, place a permanent marker consisting of cast iron monument

which reference or witness monuments are located in the manner following:

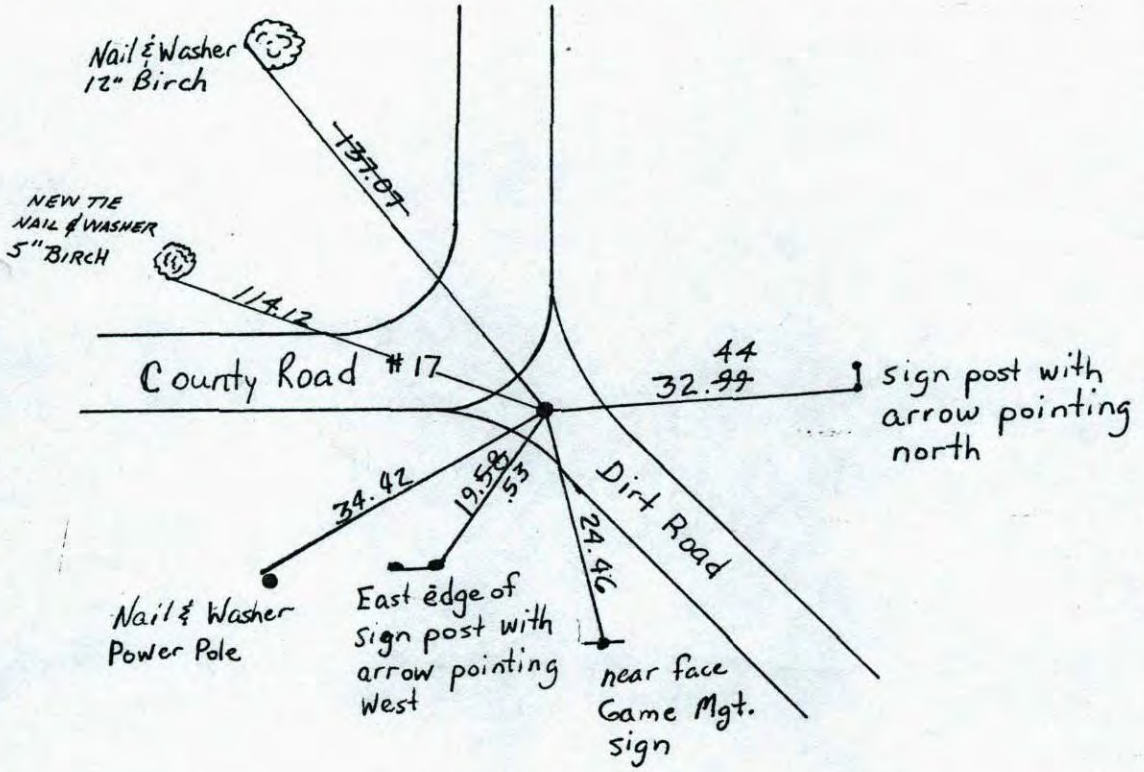

Revised date	By
8-15-75	D. Dahl
7-28-78	B. Stephens
8-12-81	P. Ross
8-28-84	G. Lips
8-5-87	D Ross

Minnesota State Plane Coordinates
South Zone

Y _____ X _____

_____, _____

County Surveyor *Date*

Registered Land Surveyor No. _____

1/83

CERTIFICATE OF LOCATION OF GOVERNMENT CORNER

County of Anoka *State of Minnesota*

East One Quarter Corner of Sec. 30 Township 33 Range 22

I hereby certify that on the 16 *day of* April, 1973, *I found the described corner which was evidenced by* area resurvey

and I further certify that to perpetuate the location of said corner, I did, at the exact location thereof, place a permanent marker consisting of cast iron monument

which reference or witness monuments are located in the manner following:

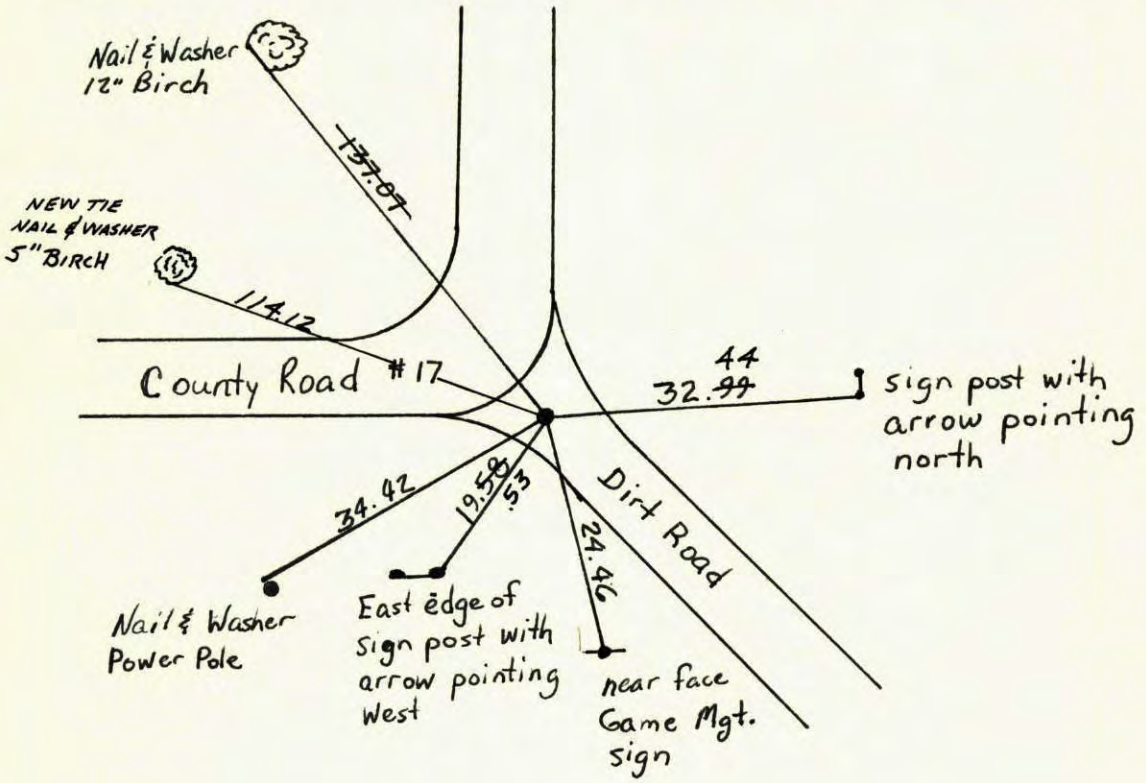

Revised date	By
8-15-75	D. Dahl
7-28-78	B. Stephens
8-12-81	P. Ross
8-28-84	G. Lips
8-5-87	D Ross

Minnesota State Plane Coordinates
South Zone

Y _____ X _____

_____ , _____

County Surveyor *Date*

Registered Land Surveyor No. _____

1/83

8-28-84

REDRAW Boss

108

E¼ Corner Sec. 30-T33-R22

Set Cast Iron Monument from Survey

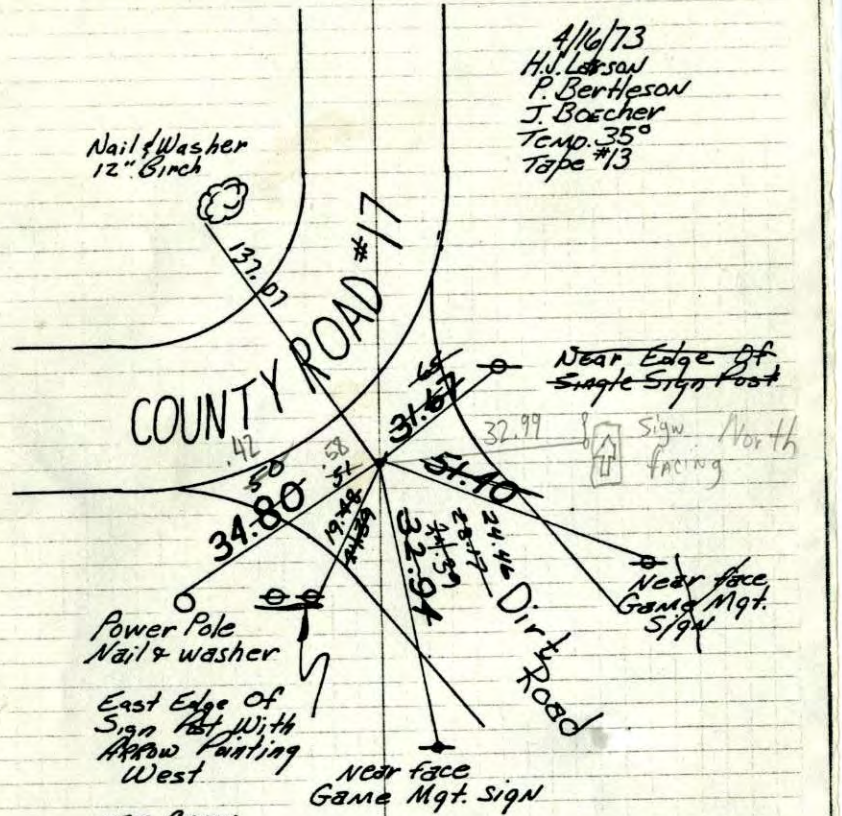

Tie Check
8-15-75
O. Dahl
B. Sannerud
G. Adams

Tie Check
7-28-78
B. Stephens
M. Kisirow

Tie Check
8-12-81
P. Ross
P. Hornby
G. Neffinger

Tie Check
8-28-84
G. Lips
D. Ross
D. Vogel

#100 927

TEMPERATURE CORRECTED AND HORIZONTALLY TAPED MEASUREMENTS

ROLAND W. ANDERSON
COUNTY SURVEYOR
ANOKA COUNTY, MINNESOTA

108

E¼ Corner Sec. 30-T33-R22

Set Cast Iron Monument from Survey

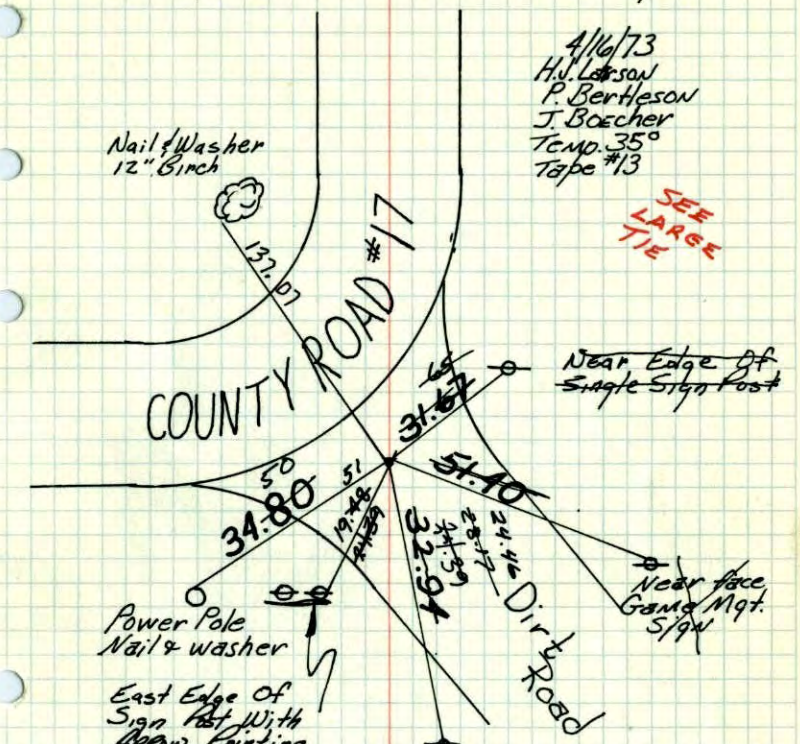

Tie Check
8-15-75
O. Dahl
B. Sannerud
G. Adams

Tie Check
7-28-78
B. Stephens
M. Kisirow

Tie Check
8-12-81
P. Ross
P. Hornby
G. Neffinger

TEMPERATURE CORRECTED AND HORIZONTALLY TAPED MEASUREMENTS

ROLAND W. ANDERSON
COUNTY SURVEYOR
ANOKA COUNTY, MINNESOTA

E 1/4 Cor. Sec. 30 T33 R22

set Cast iron monument from survey.

4-16-73
#13 35°
H. Larson
P. Bertleson
J. Beotcher

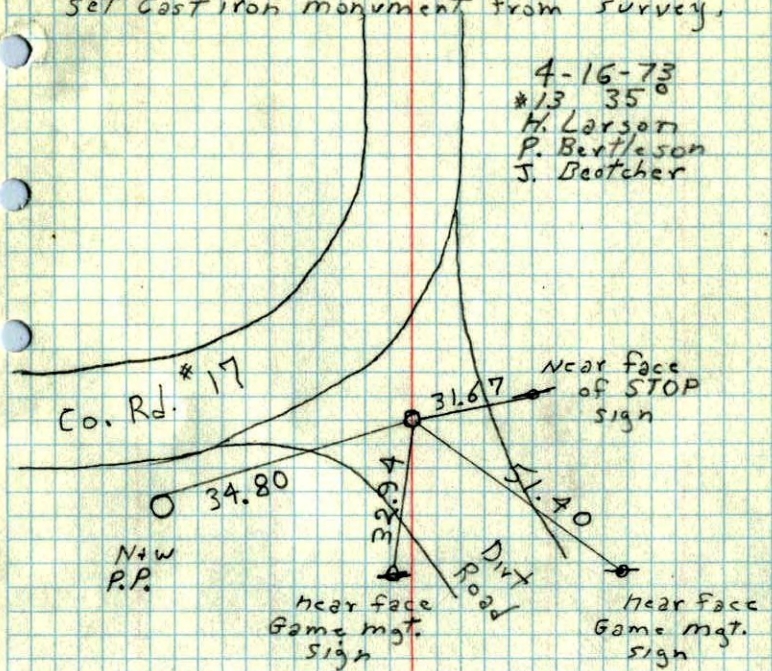

D.K.