Page No. 113

CERTIFICATE OF LOCATION OF GOVERNMENT CORNER

County of Anoka State of Minnesota

East 1/4 Corner of Sec. 25 Township 33 Range 22

On the 22nd day of February, 1977, the described corner was evidenced by a cast iron monument

and to perpetuate the location of said corner, at the exact location thereof, a permanent marker was placed consisting of the same cast iron monument with a sign and post on the ~~north~~ EAST side (FACING E.) "CHISAGO COUNTY" (UP 0.5'±) LEANING SW'LY SLIGHTLY

AND on the ___ day of _____, ____, said permanent marker was _____

Updated reference ties are as shown below.

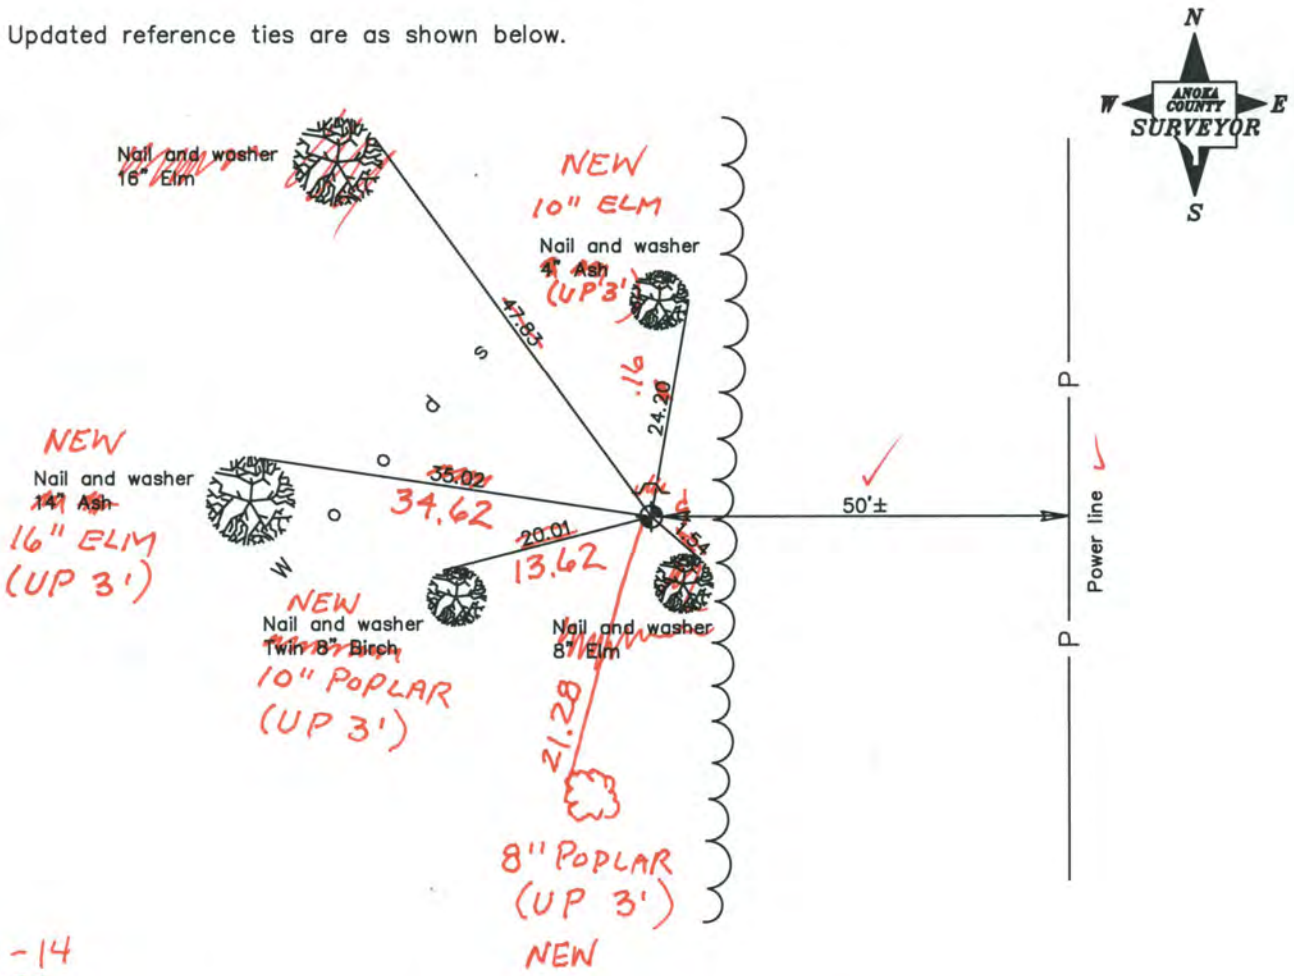

9-8-14
BK-55
TAPED Revised date

6/25/85
8/26/87

N.A.D. 1983 Coordinates
(1996 Adjustment)

County Project Coordinates	
Northing	203342.2972
Easting	563508.2744
Date	5/25/04

I hereby certify that this United States public land survey monument record is correct and complete to the best of my knowledge and belief.

_____ Date _____

_____, Anoka County Surveyor

Minnesota License Number _____

CERTIFICATE OF LOCATION OF GOVERNMENT CORNER

County of Anoka State of Minnesota

EAST QTR Corner of Sec. 25 Township 33 Range 22

I hereby certify that on the 22 day of FEB., 19 77, I found the described corner which was evidenced by CAST IRON

and I further certify that to perpetuate the location of said corner, I did, at the exact location thereof, place a permanent marker consisting of SAME, SIGN, POST NORTH SIDE

which reference or witness monuments are located in the manner following:

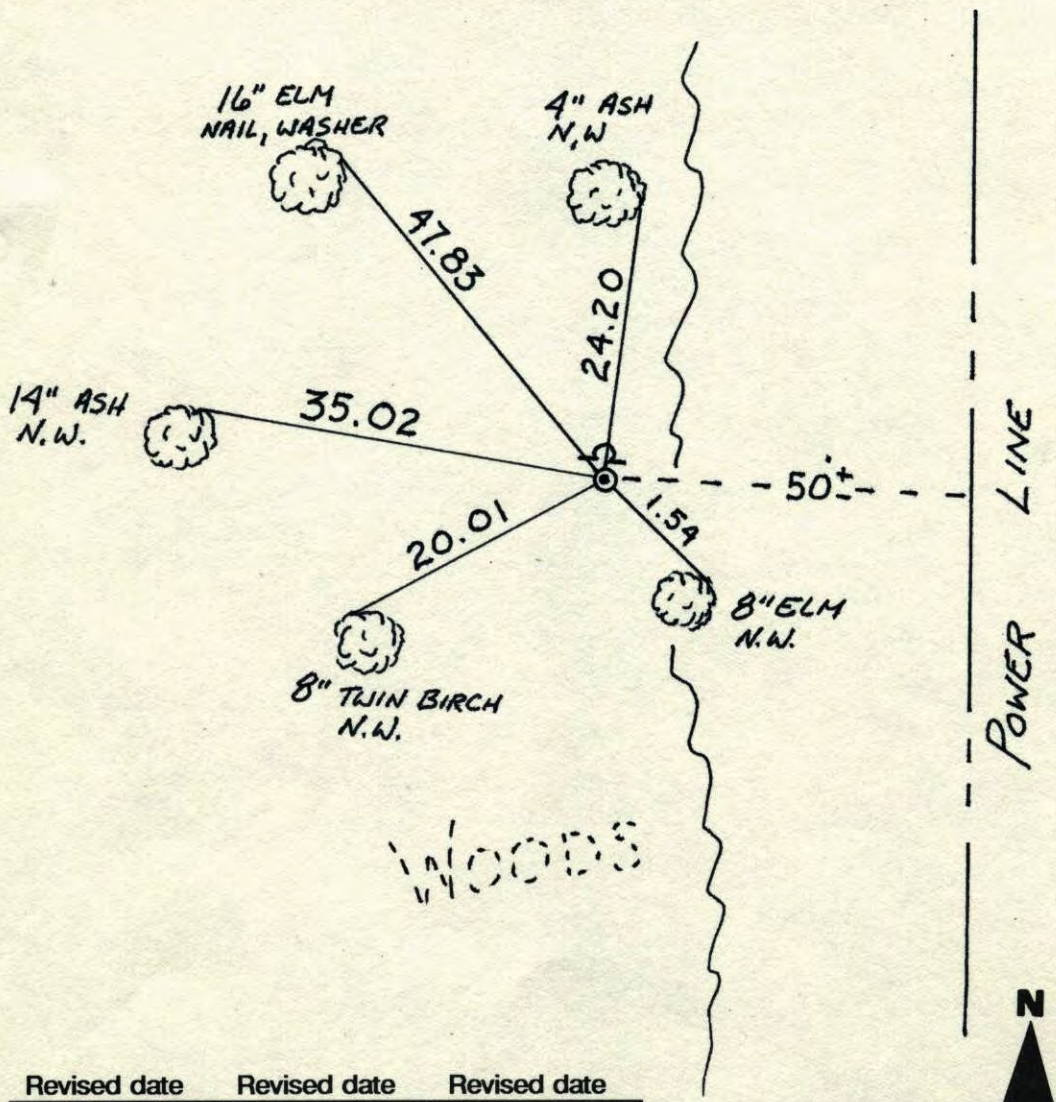

Revised date	Revised date	Revised date
6-25-85		
8-26-87		

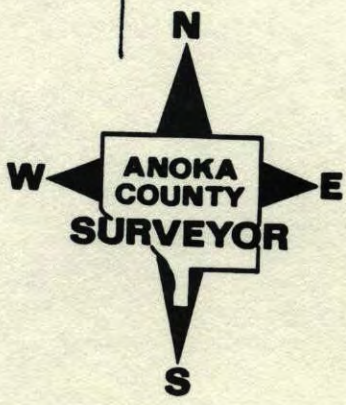

E 1/4 COR. SEC. 25, T33, R22

FOUND AND TIED CAST IRON MONUMENT. CAST IRON SET BY DON HULT. CAST IRON UP .2'±. STEEL FENCE POST ON NORTH SIDE.

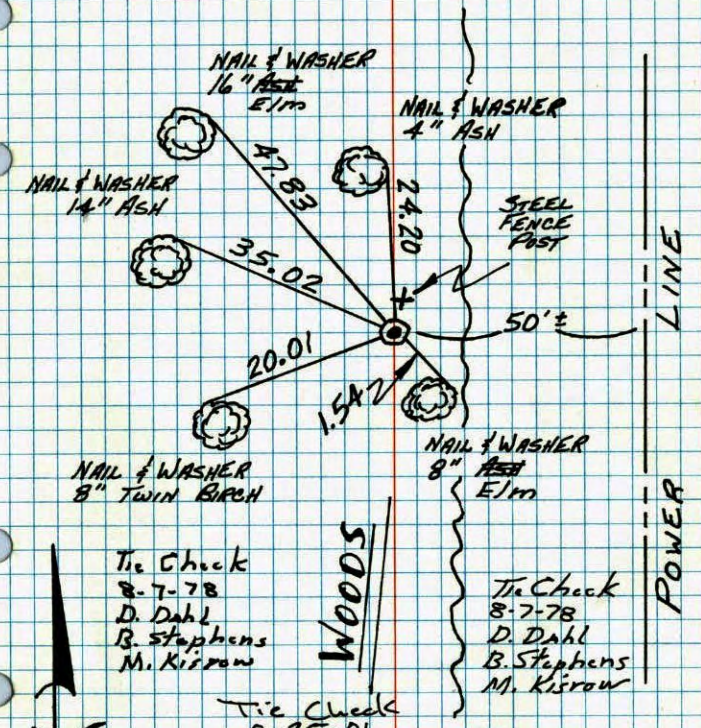

22 FEB 77
H. LARSON
B. GUETZKO
J. BOETTCHER

TEMPERATURE CORRECTED AND HORIZONTALLY TAPED MEASUREMENTS

ROLAND W. ANDERSON
COUNTY SURVEYOR
ANOKA COUNTY, MINNESOTA

E 1/4 Cor. Sec. 25 T33 R22

Found & tied cast iron monument Set by D. Hult C.I. up .2± steel F.P. on N. side

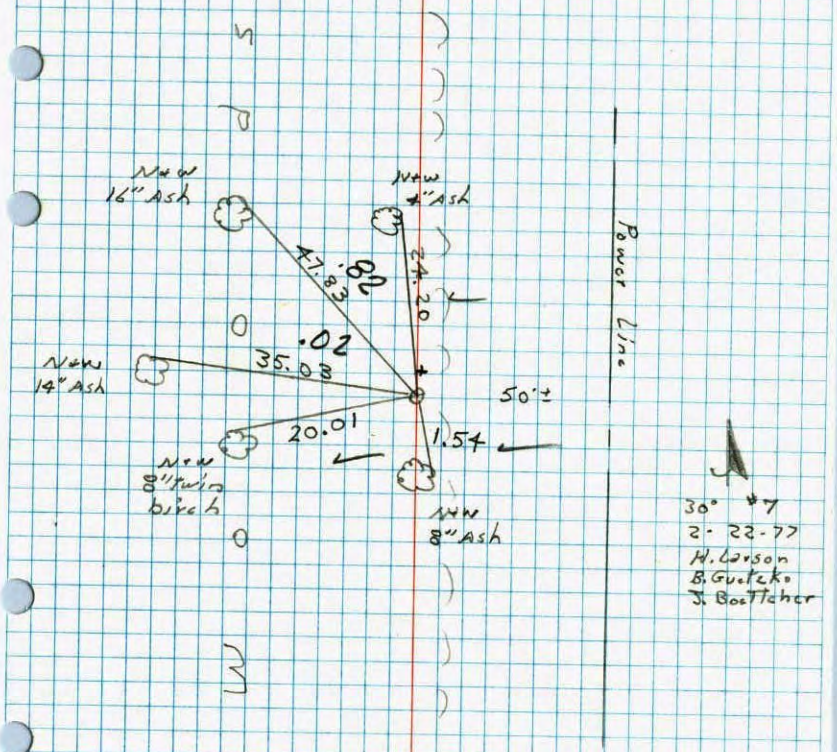

E 1/4 Cor Sec 25

3321-30

TIES TO WEST 1/4 COR SEC 30
33-21

GJK
GDW
LEA 1/20/71

CLDY & 20°

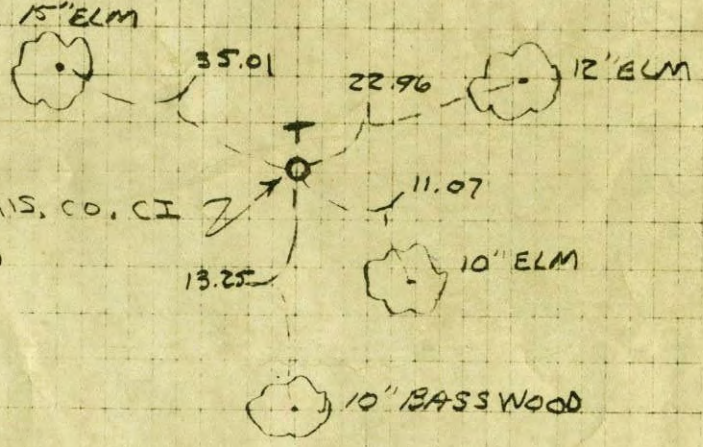

HOLD

SET ON STRAIGHT LINE BETWEEN NW & SW SEC. CORNERS & ON THE EXTENSION OF THE E-W 1/8 LINE, E 1/8 SEC. CORNER THRU THE CENTERS OF SECTION.

RECEIVED JAN 12 1975

From: Don C. Hut

DIETZGEN NO. 384 3
DIETZGEN NO. 384 3