CERTIFICATE OF LOCATION OF GOVERNMENT CORNER

County of Anoka State of Minnesota

Southeast Corner of Sec. 25 Township 33 Range 22

On the 6th day of July, 1967, the described corner was evidenced by a Chisago County cast iron monument

and to perpetuate the location of said corner, at the exact location thereof, a permanent marker was placed consisting of the same Chisago County cast iron monument

AND on the 2nd day of July, 2003, said permanent marker was found and the ties were updated

Updated reference ties are as shown below.

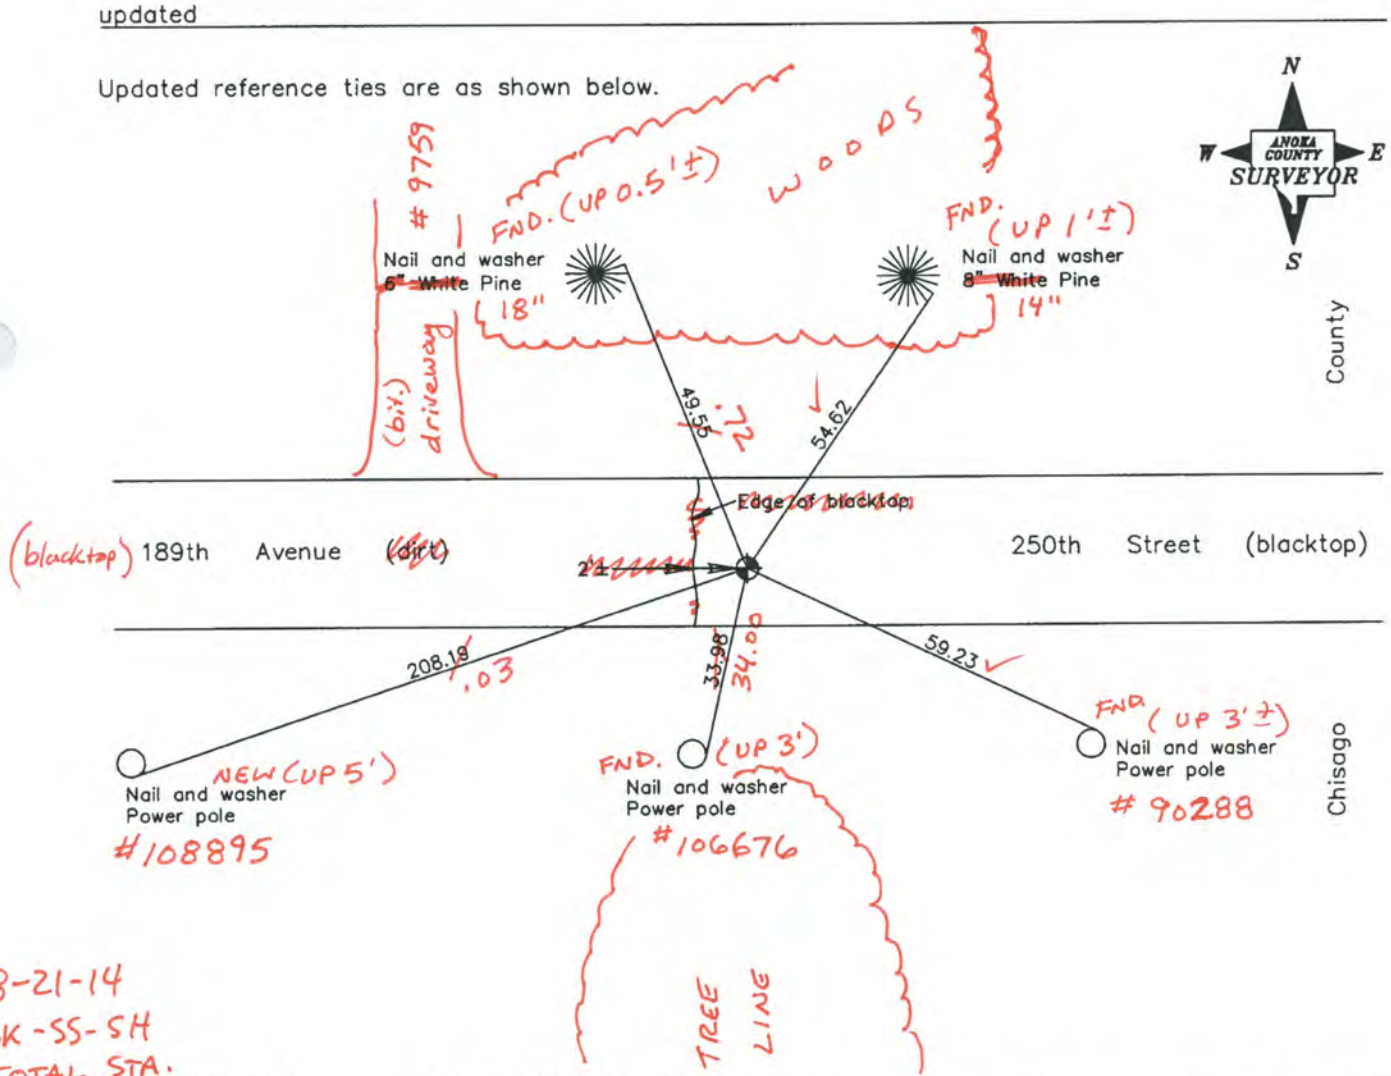

8-21-14
BK-SS-SH
TOTAL STA.
VRS

Revised date
12/26/90
3/12/01
7/02/03

N.A.D. 1983 Coordinates
(1996 Adjustment)

County Project Coordinates	
Northing	200710.8855
Easting	563555.6617
Date	7/02/03

I hereby certify that this United States public land survey monument record is correct and complete to the best of my knowledge and belief.

Larry D. Hoium Date 7/02/03

Larry D. Hoium, Anoka County Surveyor

Minnesota License Number 18165

3DQ = 0.05 N = 200710.8472 E = 563555.6428

SHOT GPS 7.2.03

Page No. 114

CERTIFICATE OF LOCATION OF GOVERNMENT CORNER

County of Anoka State of Minnesota

SOUTHEAST Corner of Sec. 25 Township 33 Range 22

I hereby certify that on the 6TH day of JULY, 1967, I found the described corner which was evidenced by CHISAGO COUNTY CAST IRON MONUMENT

and I further certify that to perpetuate the location of said corner, I did, at the exact location thereof, place a permanent marker consisting of CHISAGO COUNTY CAST IRON MONUMENT

which reference or witness monuments are located in the manner following:

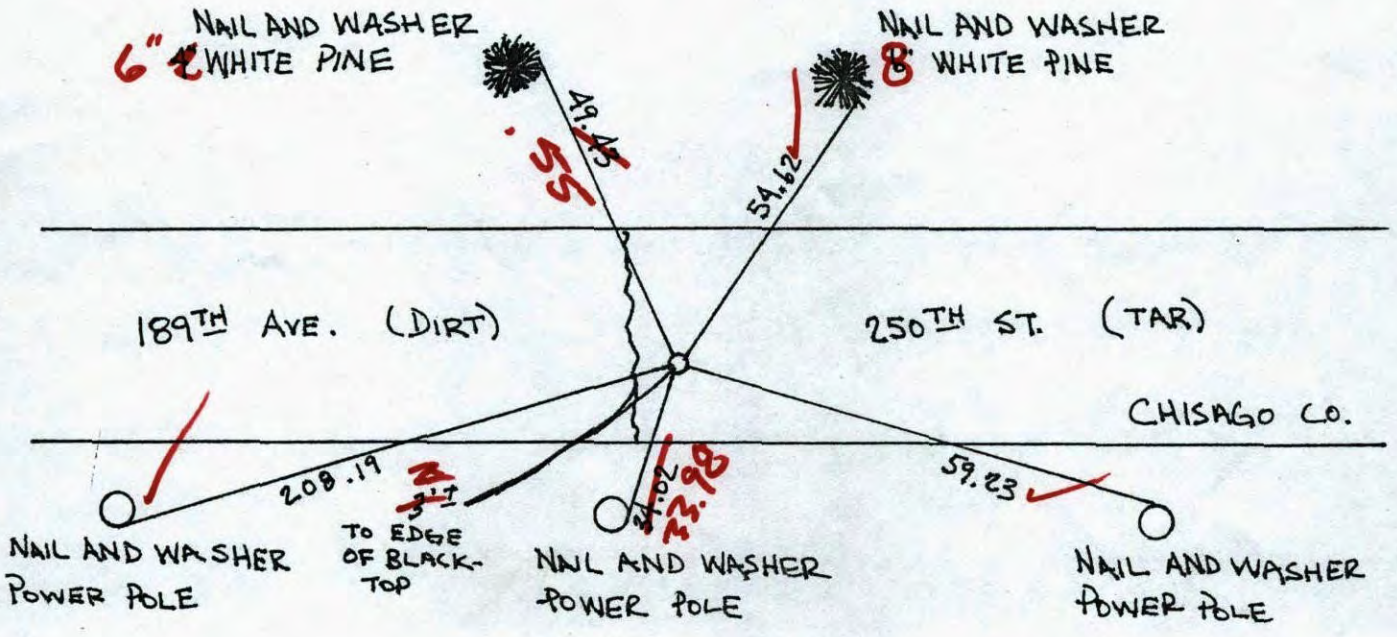

Revised date	Revised date	Revised date
12/26/90		
3/12/01		

N
W ANOKA COUNTY SURVEYOR E
S

CERTIFICATE OF LOCATION OF GOVERNMENT CORNER

County of Anoka State of Minnesota

SOUTHEAST Corner of Sec. 25 Township 33 Range 22

I hereby certify that on the 6TH day of JULY, 1967, I found the described corner which was evidenced by CHISAGO COUNTY CAST IRON MONUMENT

and I further certify that to perpetuate the location of said corner, I did, at the exact location thereof, place a permanent marker consisting of CHISAGO COUNTY CAST IRON MONUMENT

which reference or witness monuments are located in the manner following:

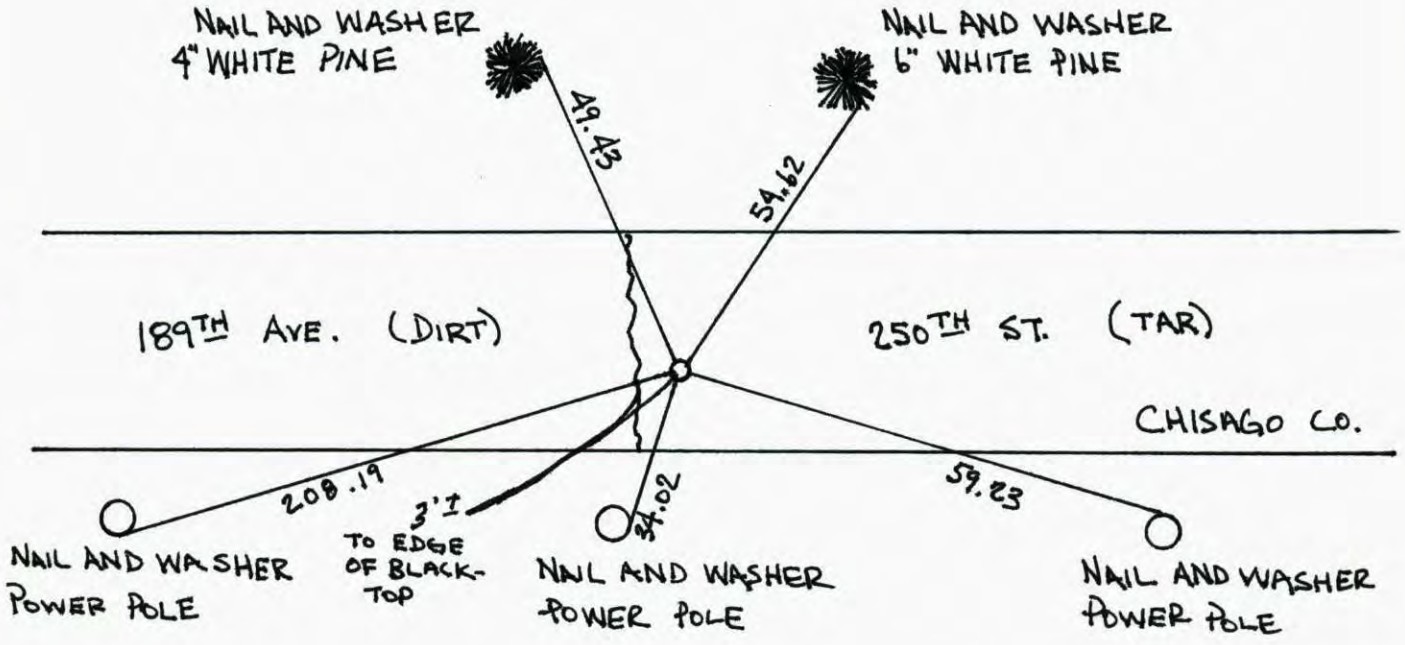

Revised date	Revised date	Revised date
12/26/90		
3/12/01		

N
W ANOKA COUNTY SURVEYOR E
S

SOUTHEAST SEC 25 T 33 R 22

RAISED & RESET CHISAGO CO. C.I.M.

RETIED

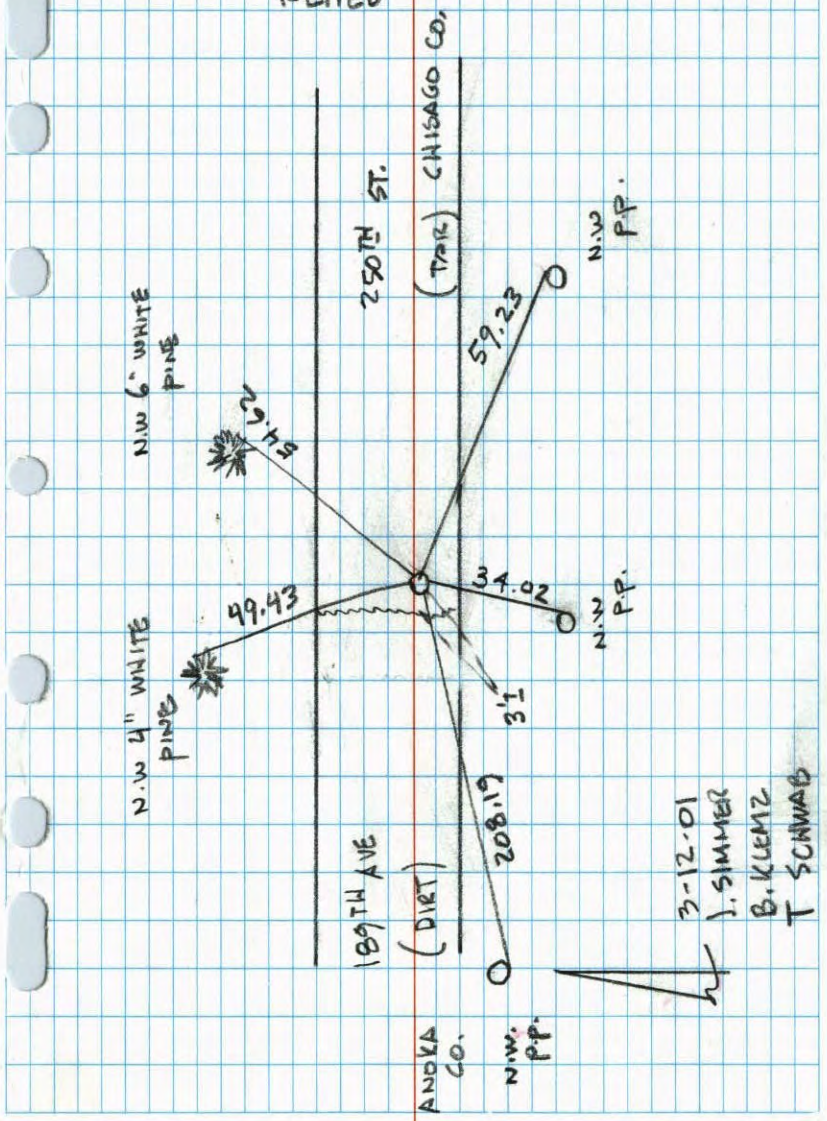

NO. 446

NATIONAL PRINTFAST

SE 25

N.E. CORNER SECTION ~~36~~ - T33 - R22

CHISAGO COUNTY CAST IRON MONUMENT DOWN 0.8'±

6 JUL 67
O. POTTER
O. POWELL

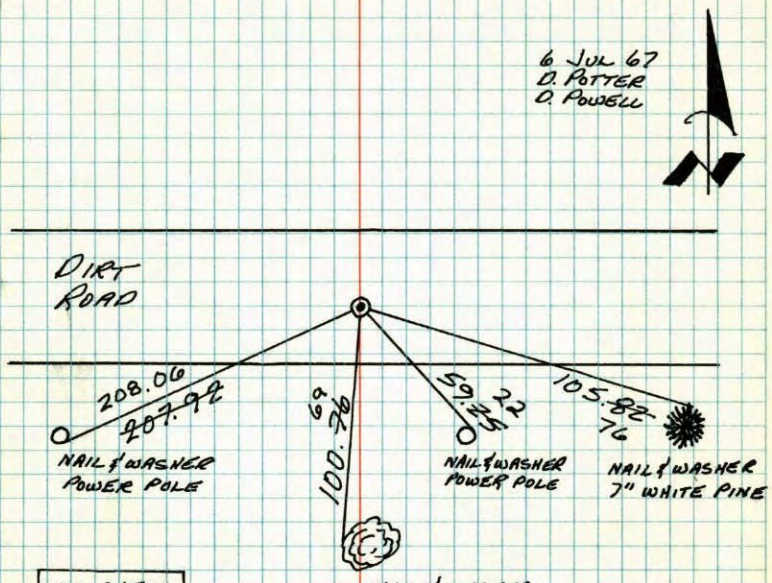

TIE CHECK 28 JUN 71 R. BRIEN J. BOETTCHER B. OLSON
TIE CHECK 30 JUL 75 D. OAHL B. SANNERUD G. ADAMS
TIE CHECK D. OAHL 8-3-78 M. KISROW B. STEPHENS

Tie Check
8-10-81
P. Ross
P. Horuby
G. Neffinger

TEMPERATURE CORRECTED AND HORIZONTALLY TAPED MEASUREMENTS

ROLAND W. ANDERSON
COUNTY SURVEYOR
ANOKA COUNTY, MINNESOTA

NO. 448

TELEDYNE

SE NE Cor. Sec. 25 ~~36~~ T33 R22

Chisago County Cast Iron down 0.8' ±

Retie
August 3, 1978
D. Dahl
B. Stephens M. Kisrow
Tape #2 Temp. 73°

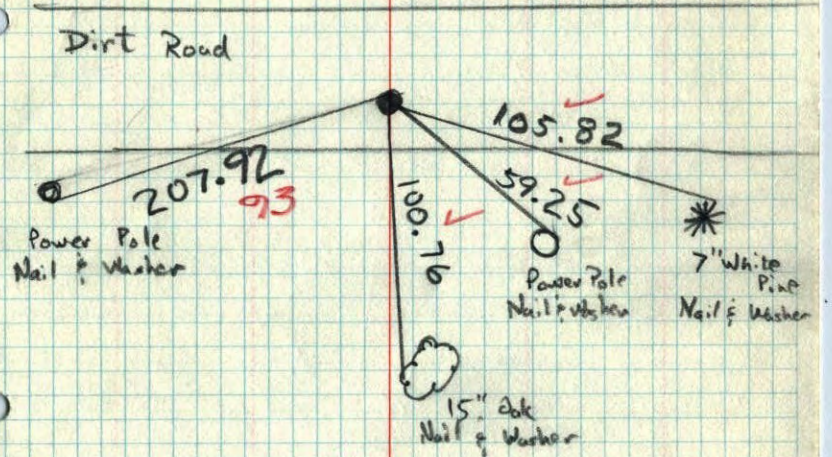

SE NE 25
NE Cor. Sec. ~~36~~ - T33 - R22

Chisago County Cast Iron down 0.8' ±

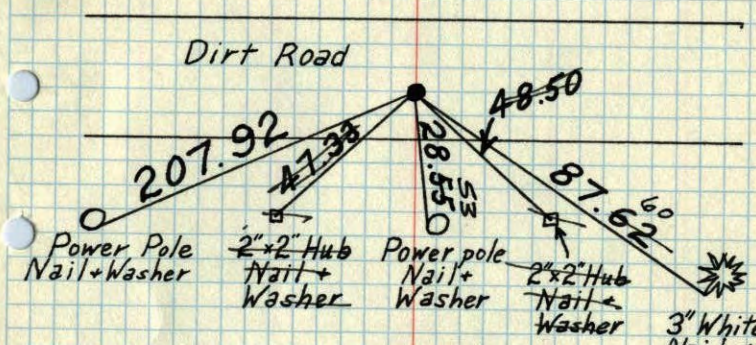

July 6, 1967
D. Potter
D. Powell

Tie Check
June 28, 1971
R. Brien
J. Boettcher
B. Olson

Tie Check
7-30-75
D. Dahl
B. Sonnerud
G. Adams

See New Ties 8-3-78 D. Dahl

TEMPERATURE CORRECTED AND HORIZONTALLY TAPED MEASUREMENTS

ROLAND W. ANDERSON
COUNTY SURVEYOR
ANOKA COUNTY, MINNESOTA

SE
~~NE~~ COR. SEC. ~~36~~ 25, T33, R22

CHISAGO COUNTY CAST IRON

DOWN 0.8' ±

7/6/67

D. POTTER
D. POWELL
#7 68°

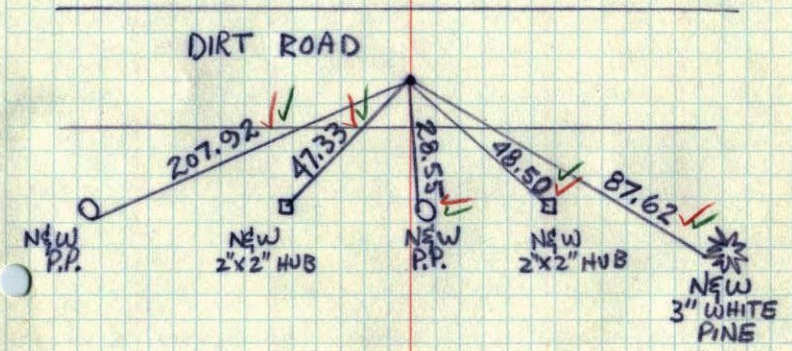

CERTIFICATE OF LOCATION OF GOVERNMENT CORNER

SE NE ~~NW~~ Corner to Section ~~31~~ 25 Township ~~33 N~~ 33 Range ~~21 W~~ 22 No. 113

STATE OF MINNESOTA,

County of Chisago S.S.

I hereby certify that on the 28th day of October 1964, that I, Don C. Hult, a Registered Land Surveyor, County Surveyor, ~~County Highway Engineer,~~ found the Northwest corner of Section 31, T 33 N, R 21 W which was evidenced by a rotted post with an iron rod in center - buried in road bed - verified with measurements and I further certify that to perpetuate the location of such corner I did, at the exact location thereof, place a permanent marker consisting of a standard Chisago County cast iron monument set 0.8 ft. in road.

I further certify that I established 5 references or witness monuments consisting of 2 power poles, 2 hubs and a tree which reference or witness monuments are located in the manner following.

ESE 87.61 ft. 3" white pine
~~SE~~ 48.50 ft. disk on top 2"x2" hub
~~South 28.65 ft. Power pole~~
SW 47.34 ft. disk in top 2"x 2" hub
WSW 207.97 ft. Power pole

Measurements are from "6617" ties to center of C.I. monument.

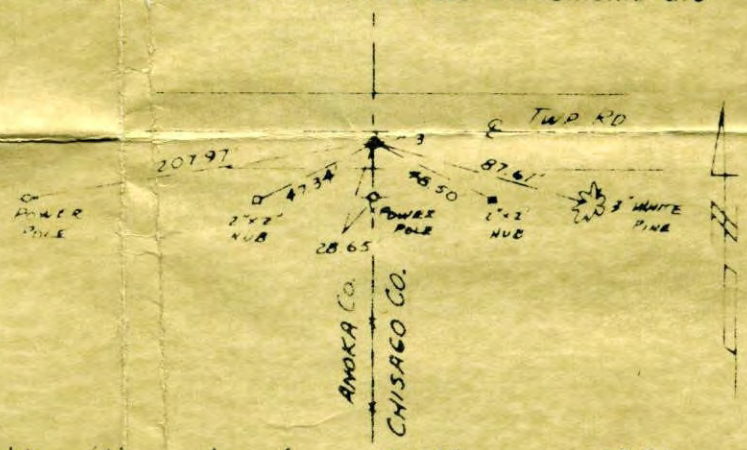

Dated at Forest Lake Minnesota, this 6th day of April, 1965.

Don C. Hult

County Surveyor, ~~County Highway Engineer,~~

Registered Land Surveyor No. 6617

OFFICE OF THE REGISTER OF DEEDS

115053

County of Chisago

I hereby certify that the within instrument was filed in this office for record on the 9th day of April A.D. 19 65.

Register of Deeds