Page No. 132

CERTIFICATE OF LOCATION OF GOVERNMENT CORNER

County of Anoka State of Minnesota

East 1/4 Corner of Sec. 31 Township 33 Range 22

On the 3rd day of May, 1965, the described corner was evidenced by a concrete monument

and to perpetuate the location of said corner, at the exact location thereof, a permanent marker was placed consisting of ~~a red and white iron pipe~~ TELSPAR (UP 3'+) SIGN ATTACHED

AND on the 26th day of June, 2004, said permanent marker was found and the ties were updated

Updated reference ties are as shown below.

SEE BACK FOR DRAWING

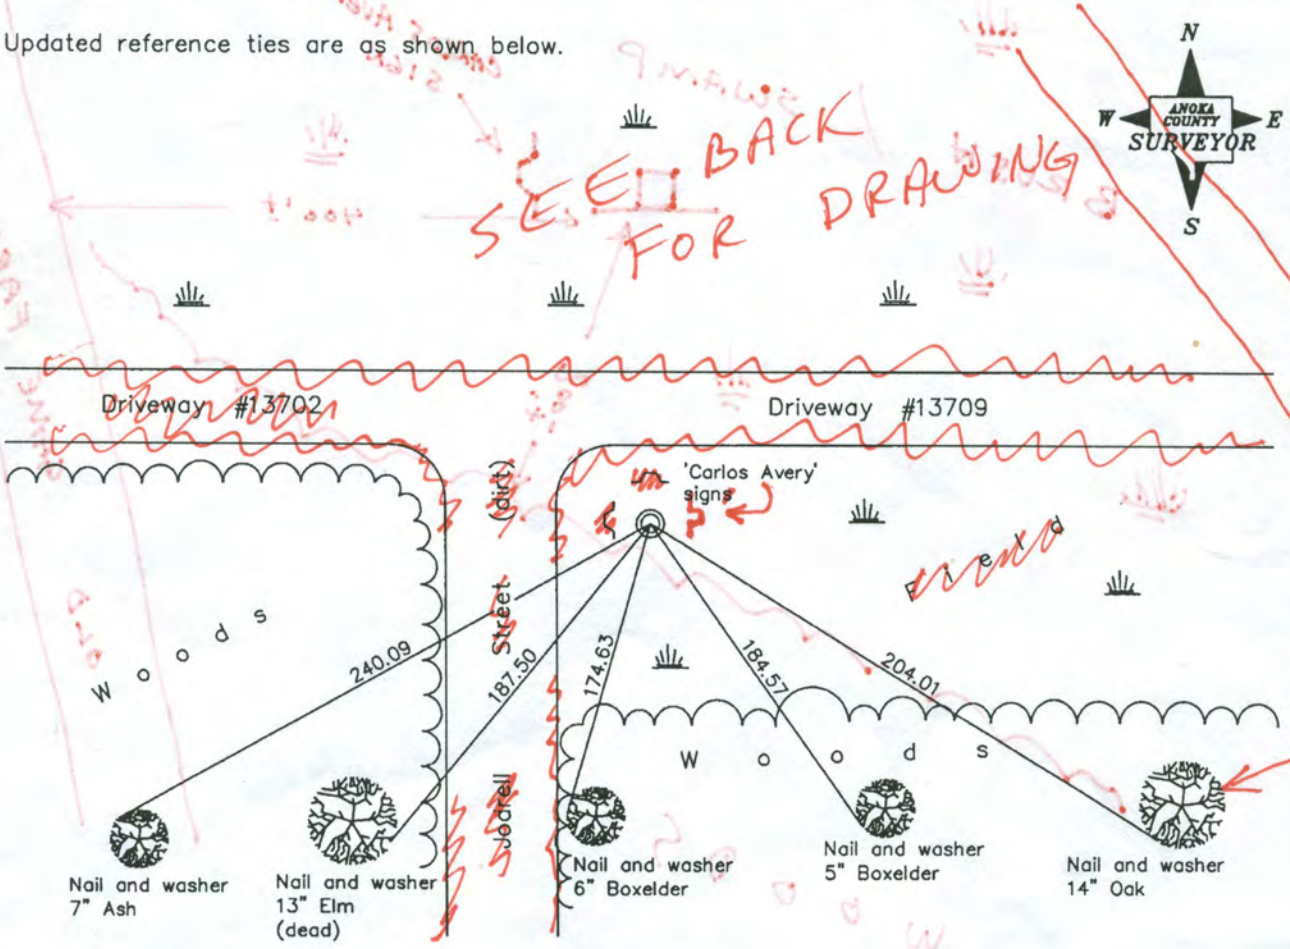

9-30-14 BK-55 VRS

Revised date

11/18/87
6/26/04

N.A.D. 1983 Coordinates (1996 Adjustment)

County Project Coordinates	
Northing	198195.5714
Easting	537308.5041
Date	5/10/05

I hereby certify that this United States public land survey monument record is correct and complete to the best of my knowledge and belief.

Larry D. Hoium Date 6/26/04

Larry D. Hoium, Anoka County Surveyor

Minnesota License Number 18165

3DQ = 0. N = 198195.4729 E = 537308.4807

TELSPAR UP 3'± W/SIGN ATTACHED FACING S.

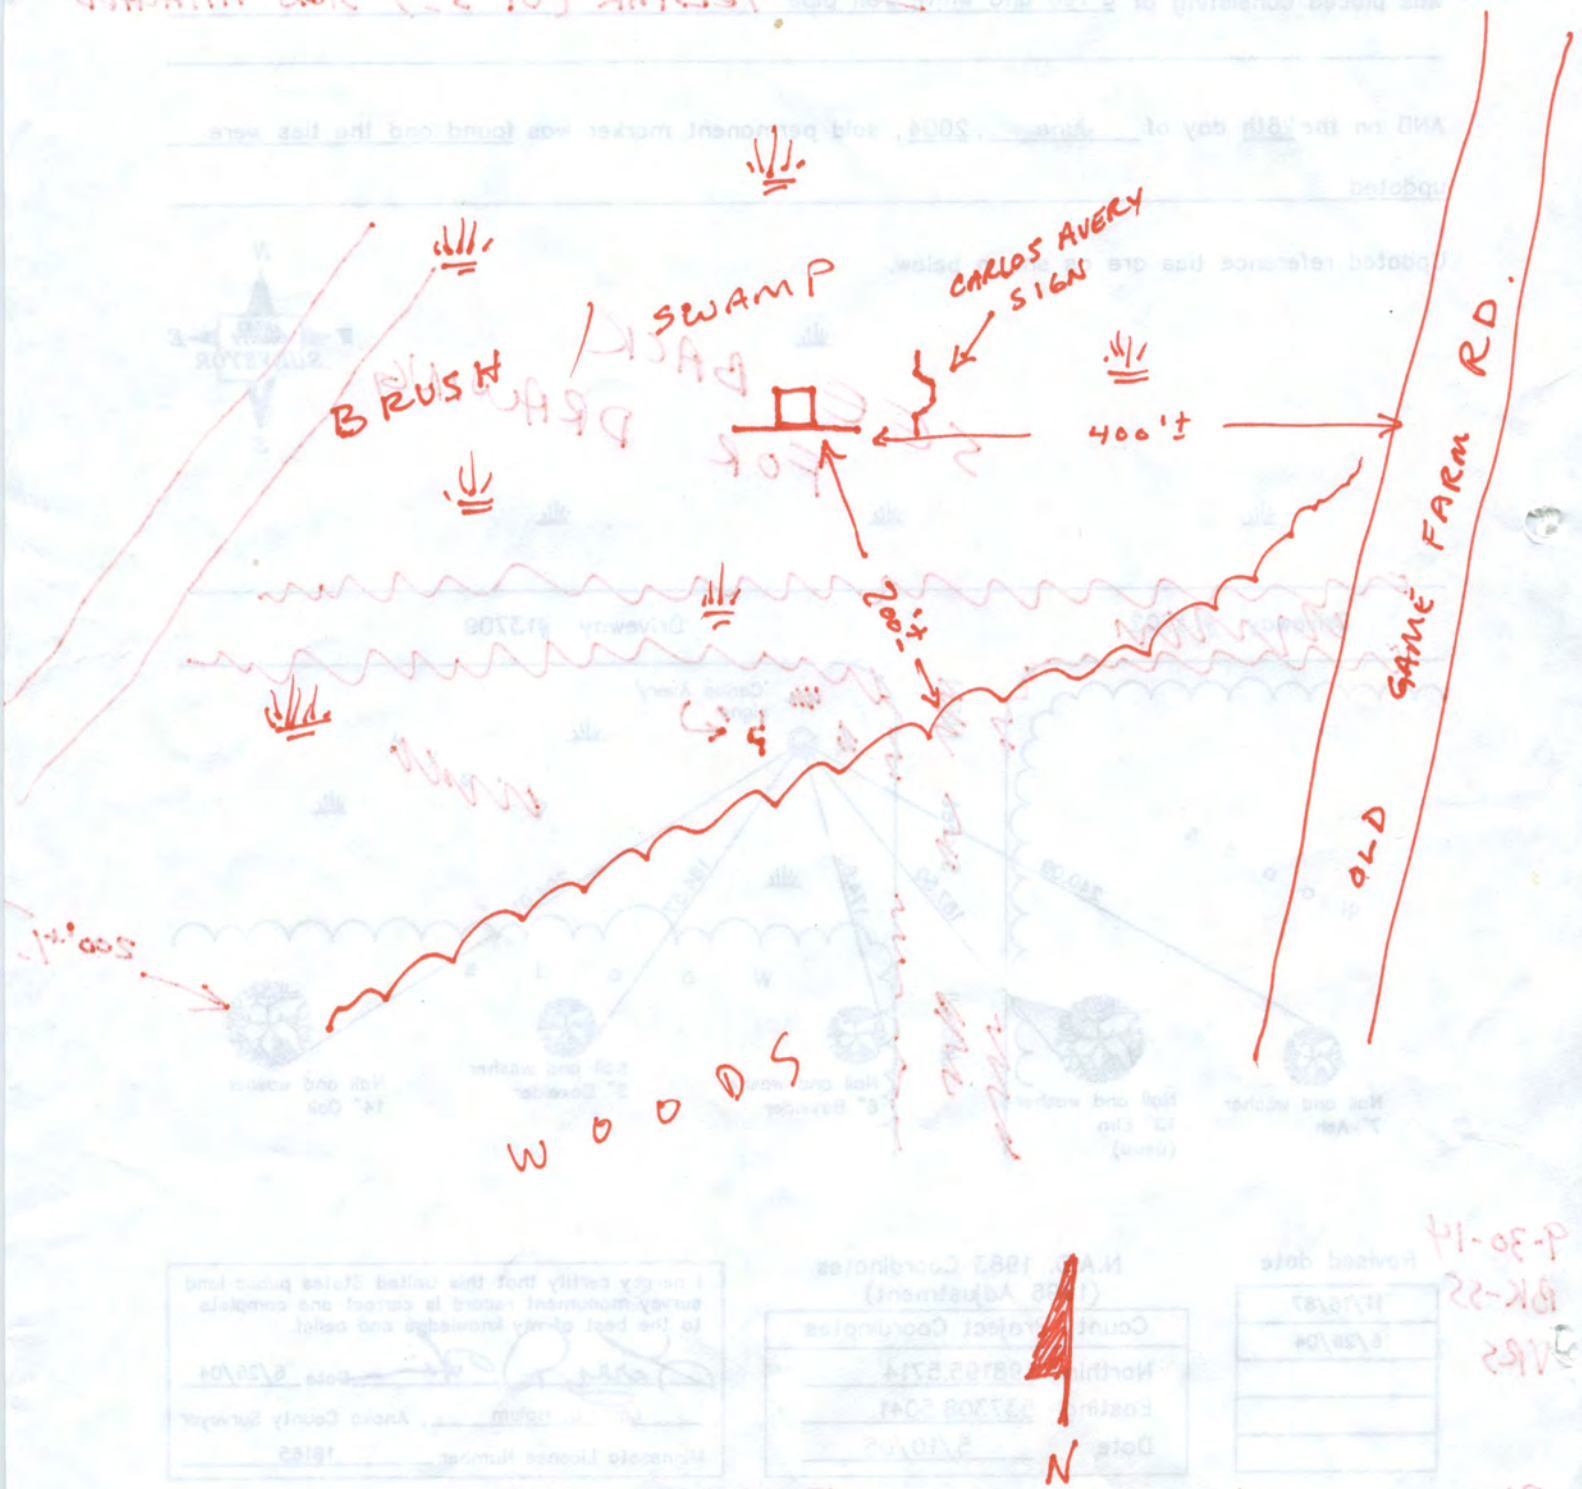

5-10-05 SHOT GPS

Page No. 132

CERTIFICATE OF LOCATION OF GOVERNMENT CORNER

County of Anoka State of Minnesota

EAST 1/4 Corner of Sec. 31 Township 33 Range 22

I hereby certify that on the 3rd day of MAY, 1965, I found the described corner which was evidenced by CONCRETE MON.

and I further certify that to perpetuate the location of said corner, I did, at the exact location thereof, place a permanent marker consisting of RED AND WHITE IRON PIPE

which reference or witness monuments are located in the manner following:

RETIE RED & WHITE IRON PIPE. CORNER STILL GOOD, ONE OLD TIE LEFT (ELM)

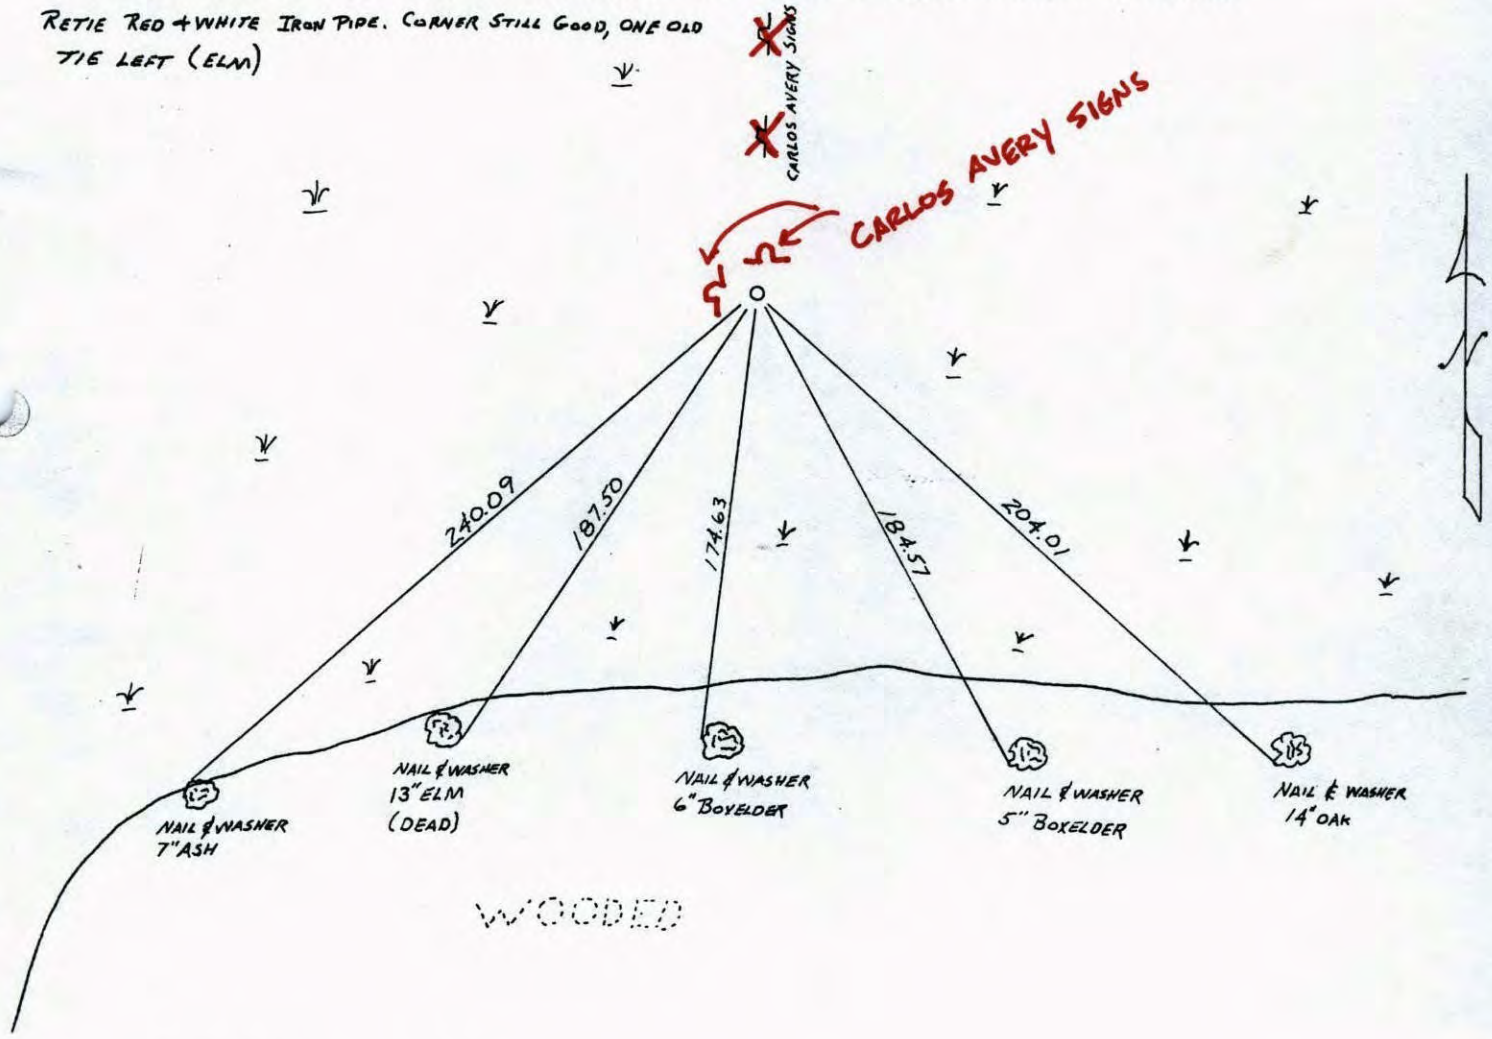

Revised date	By
11-18-87	H. LARSON

Minnesota State Plane Coordinates
South Zone

Y _____ X _____

_____, _____

County Surveyor Date

Registered Land Surveyor No. _____

Page No. 132

CERTIFICATE OF LOCATION OF GOVERNMENT CORNER

County of Anoka *State of Minnesota*

EAST 1/4 Corner of Sec. 31 Township 33 Range 22

I hereby certify that on the 3rd *day of* MAY, 1965, *I found the described corner which was evidenced by* CONCRETE MON.

and I further certify that to perpetuate the location of said corner, I did, at the exact location thereof, place a permanent marker consisting of RED AND WHITE IRON PIPE

which reference or witness monuments are located in the manner following:

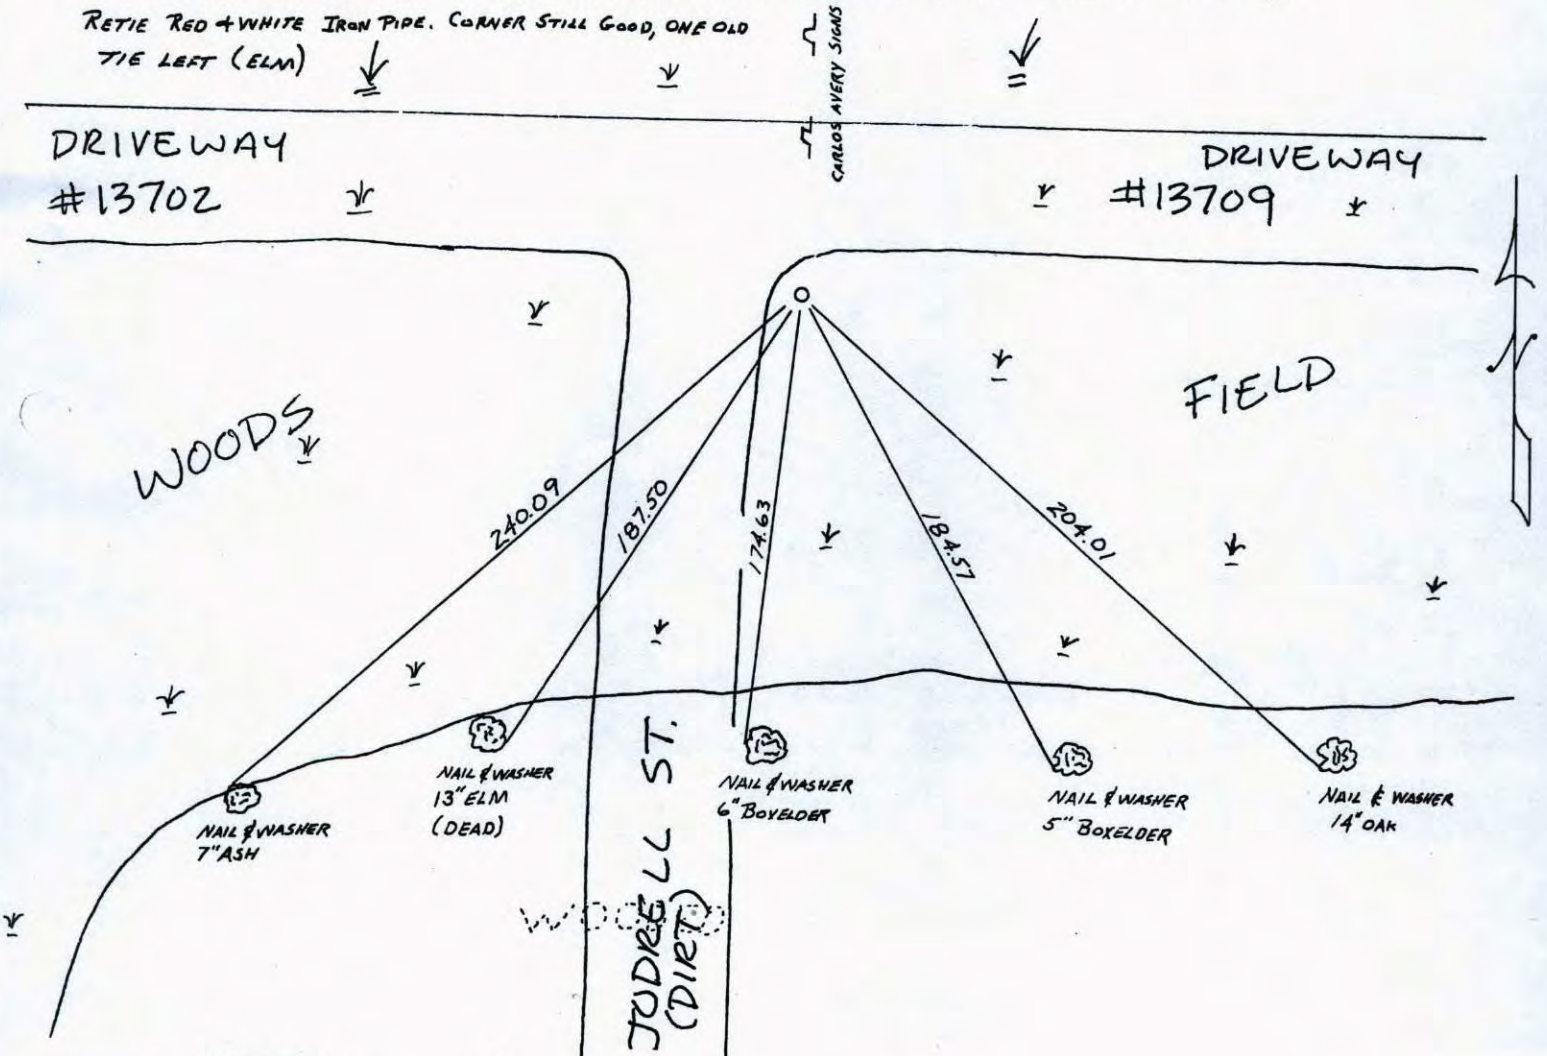

Revised date	By
11-18-87	H. LARSON
6-26-04	

REDRAWN B... T. STEVENSON

Minnesota State Plane Coordinates
South Zone

Y _____ X _____

_____, _____

County Surveyor *Date*

Registered Land Surveyor No. _____

Page No. 132

CERTIFICATE OF LOCATION OF GOVERNMENT CORNER

County of Anoka *State of Minnesota*

EAST 1/4 Corner of Sec. 31 Township 33 Range 22

I hereby certify that on the 3rd *day of* MAY, 1965, *I found the described corner which was evidenced by* CONCRETE MON.

and I further certify that to perpetuate the location of said corner, I did, at the exact location thereof, place a permanent marker consisting of RED AND WHITE IRON PIPE

which reference or witness monuments are located in the manner following:

RETIE RED & WHITE IRON PIPE. CORNER STILL GOOD, ONE OLD TIE LEFT (ELM)

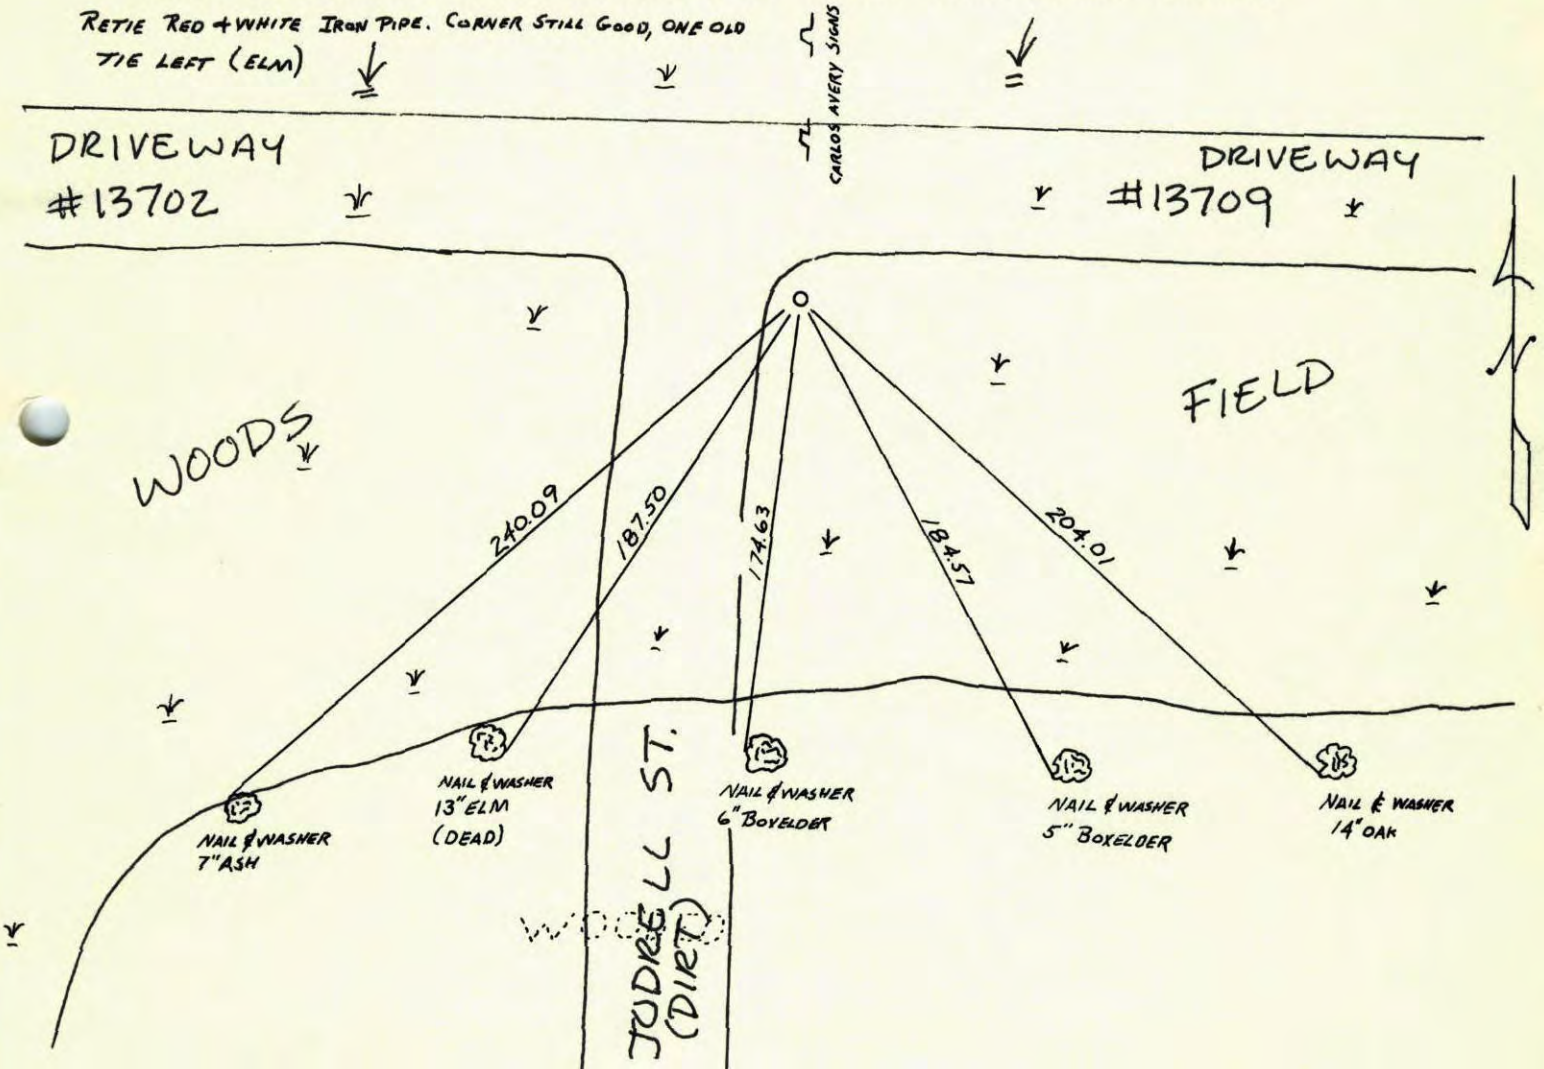

Revised date	By
11-18-87	H. LARSON
6-26-04	

RE DRAWN By J. STEVENSON

Minnesota State Plane Coordinates
South Zone

Y _____ X _____

_____ , _____

County Surveyor *Date*

Registered Land Surveyor No. _____

1/83

EAST 1/4 CORNER SECTION 31 T33 R22

RETIED RED AND WHITE IRON PIPE
CORNER STILL GOOD, ONE TIE LEFT (ELM)

200' 32°
11-18-87
W. LARSON
B. GUETZKO
H. STEVENSON

CARLOS AVERY SIGNS

NO. 448

TELEDYNE

240.09
187.50
174.63
181.57
204.01

N+W 7" ASH
N+W 13" ELM (DEAD)
N+W 6" BOXELDER
N+W 5" BOXELDER
N+W 14" OAK

WOODED

E 1/4 CORNER SECTION 31 T33 R22

REPLACED RED AND WHITE IRON PIPE
WITH NEW RED AND WHITE IRON PIPE.
RETIED. ALL OLD TIES GONE.
CORNER PROVED BY RESURVEY.

200' 55°
11-1-82
W. LARSON
B. GUETZKO
D. NAGLAK

WET
CARLOS AVERY SIGNS
SWAMP

NO. 448

TELEDYNE

215.53
187.52
194.34
204.04

51
50
52

N+W 10" CHERRY
N+W 13" ELM
N+W 15" OAK
N+W 12" OAK

WOODS

132

E 1/4 Cor. Sec. 31, T33, R22

Replaced broken concrete mon.
with 1¼"x7' red+white pipe up 2.5'

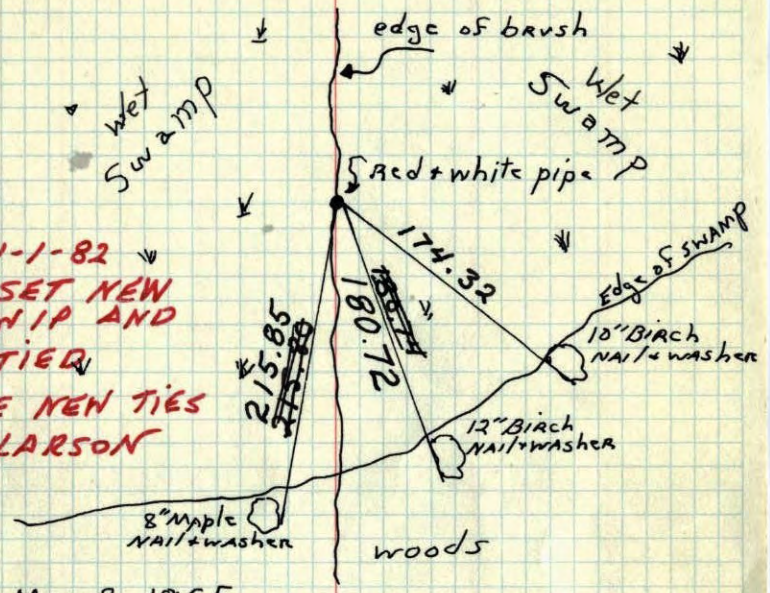

11-1-82
RESET NEW R/W IP AND RETIED
SEE NEW TIES
H. LARSON

MAY 3. 1965
J. Oliver
M.D. Anderson
H. Larson
63° #5

Tie Check
July 5 1967
D. Potter
D. Powell

Tie Check
June 28, 1971
R. Brien
J. Boettcher
B. Olson

TIE CHECK
7-30-75
O. OAHL
G. SANNERUD
G. ADAMS

TEMPERATURE CORRECTED AND HORIZONTALLY TAPED MEASUREMENTS

ROLAND W. ANDERSON
COUNTY SURVEYOR
ANOKA COUNTY, MINNESOTA

X

~~32~~

E 1/4 Cor. Sec. 31, T33, R22

Replaced broken concrete mon.
with 1¼"x7' red+white pipe up 2.5'

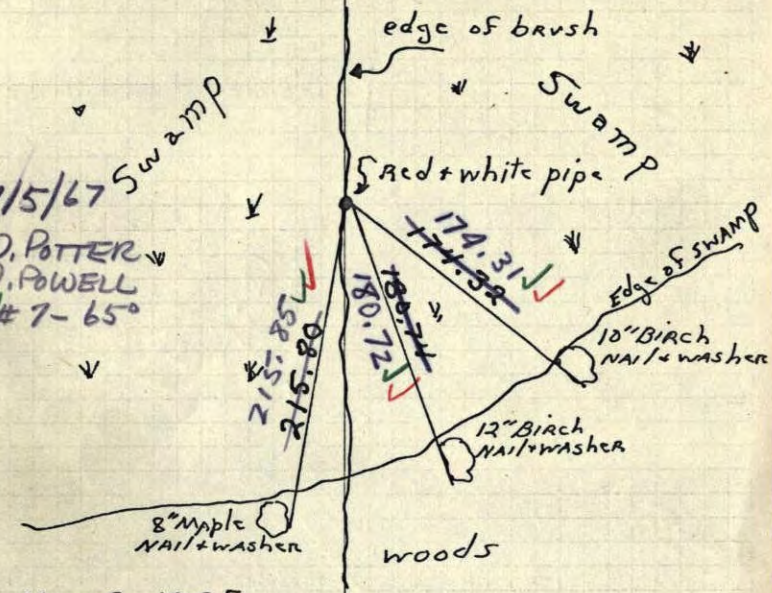

MAY 3. 1965
J. Oliver
M.D. Anderson
H. Larson
63° #5

TEMPERATURE CORRECTED AND HORIZONTALLY TAPED MEASUREMENTS

ROLAND W. ANDERSON
COUNTY SURVEYOR
ANOKA COUNTY, MINNESOTA

E 1/4. Cor Sec. 31, T 33, R 22
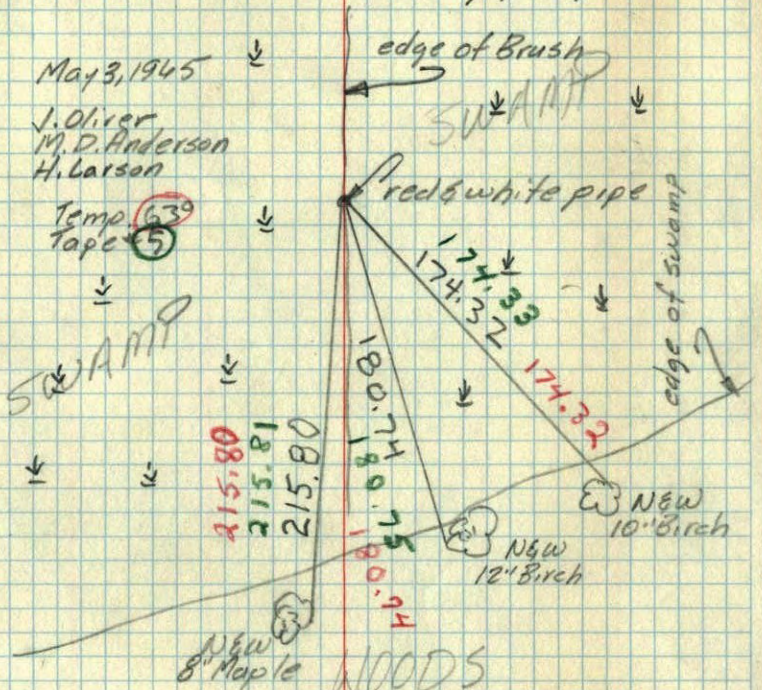
Replaced broken Concrete Mon.
with 1¼" x 1' red & white pipe up 2.5'