1/16 CORNER ON N. LINE OF SW 1/4
SECTION 35 T33 R22

FOUND CONCRETE LEANING. STRAGHTENED AND TIED CARLOS AVERY SIGNS BY CONC.

1-8-85
H. LARSON
B. GUETZKO
T. RIEMENSNIDE
100

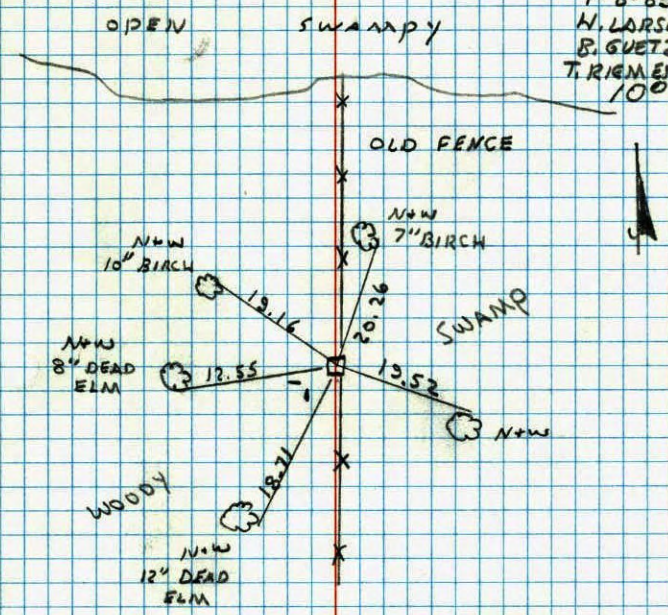

NO. 448
TELEDYNE