Page No. 137

CERTIFICATE OF LOCATION OF GOVERNMENT CORNER

County of Anoka State of Minnesota

West 1/4 Corner of Sec. 36 Township 33 Range 22

On the ___ day of April, 1968, the described corner was evidenced by a spike

and to perpetuate the location of said corner, at the exact location thereof, a permanent marker was placed consisting of a cast iron monument

AND on the 10th day of May, 2005, said permanent marker was found down 3'± and the ties were updated

Updated reference ties are as shown below.

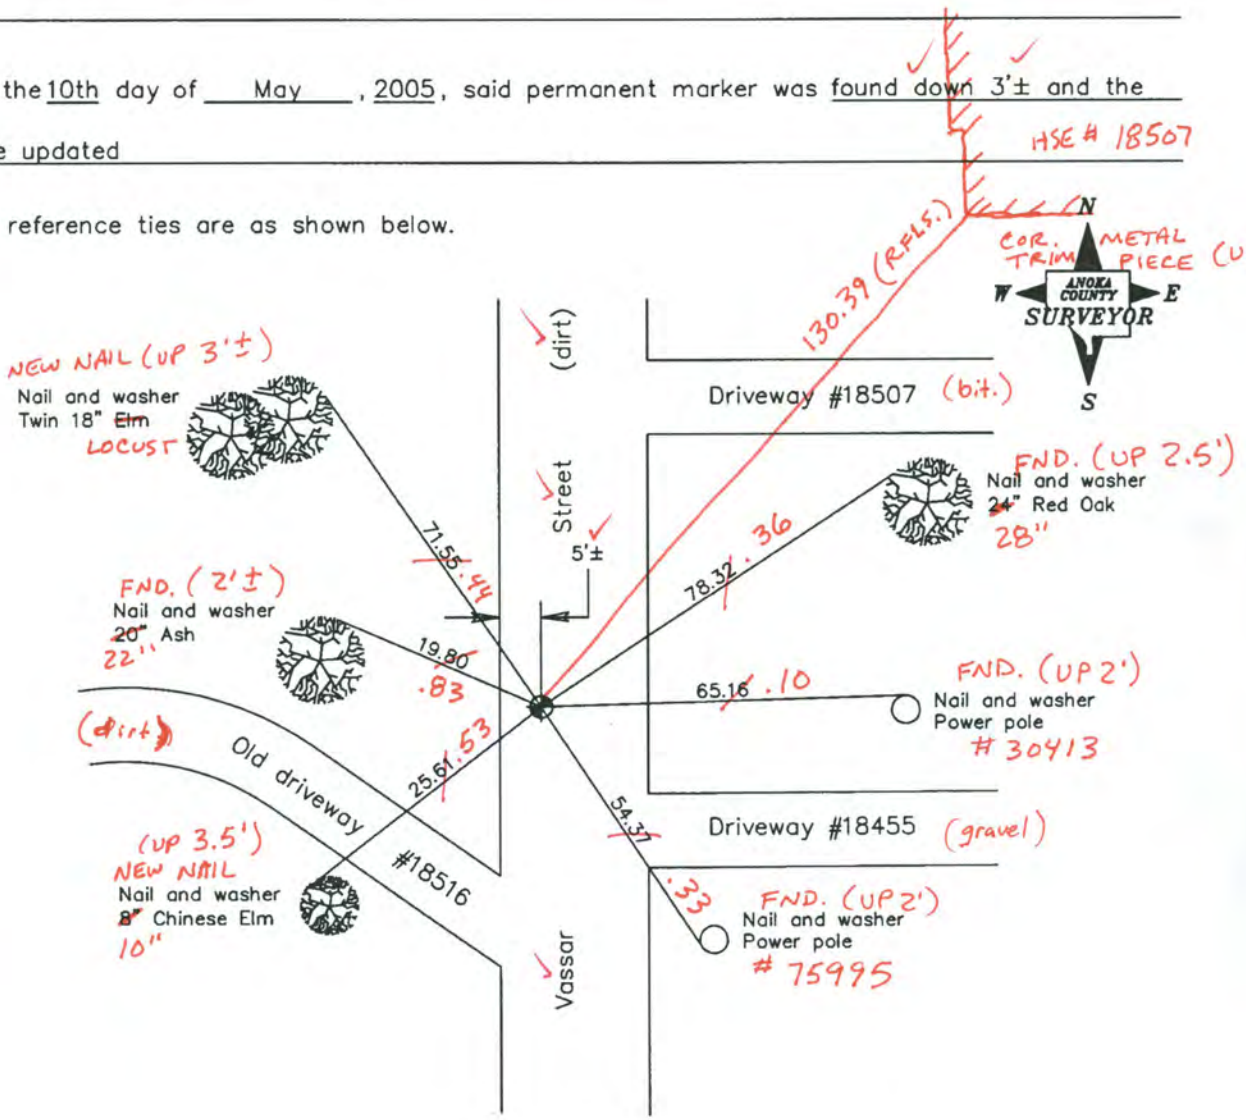

BK. SS
9-5-14
TOTAL STA.

Revised date
12/26/90
5/10/05

3D=0.15

N.A.D. 1983 Coordinates (1996 Adjustment)

County Project Coordinates	
Northing	198159.6370
Easting	558338.3559
Date	5/10/05

I hereby certify that this United States public land survey monument record is correct and complete to the best of my knowledge and belief.

Date 5/10/05

Larry D. Hoium, Anoka County Surveyor

Minnesota License Number 18165

N=198159.6795 E=558338.2974

SHOT GPS 7.3.03

Page No. 137

CERTIFICATE OF LOCATION OF GOVERNMENT CORNER

County of Anoka *State of Minnesota*

WEST QUARTER Corner of Sec. 36 Township 33 Range 22

I hereby certify that on the ____ *day of* APRIL, *19*68, *I found the described corner which was evidenced by* A SPIKE.

and I further certify that to perpetuate the location of said corner, I did, at the exact location thereof, place a permanent marker consisting of CAST IRON MONUMENT. DOWN 3'±

which reference or witness monuments are located in the manner following:

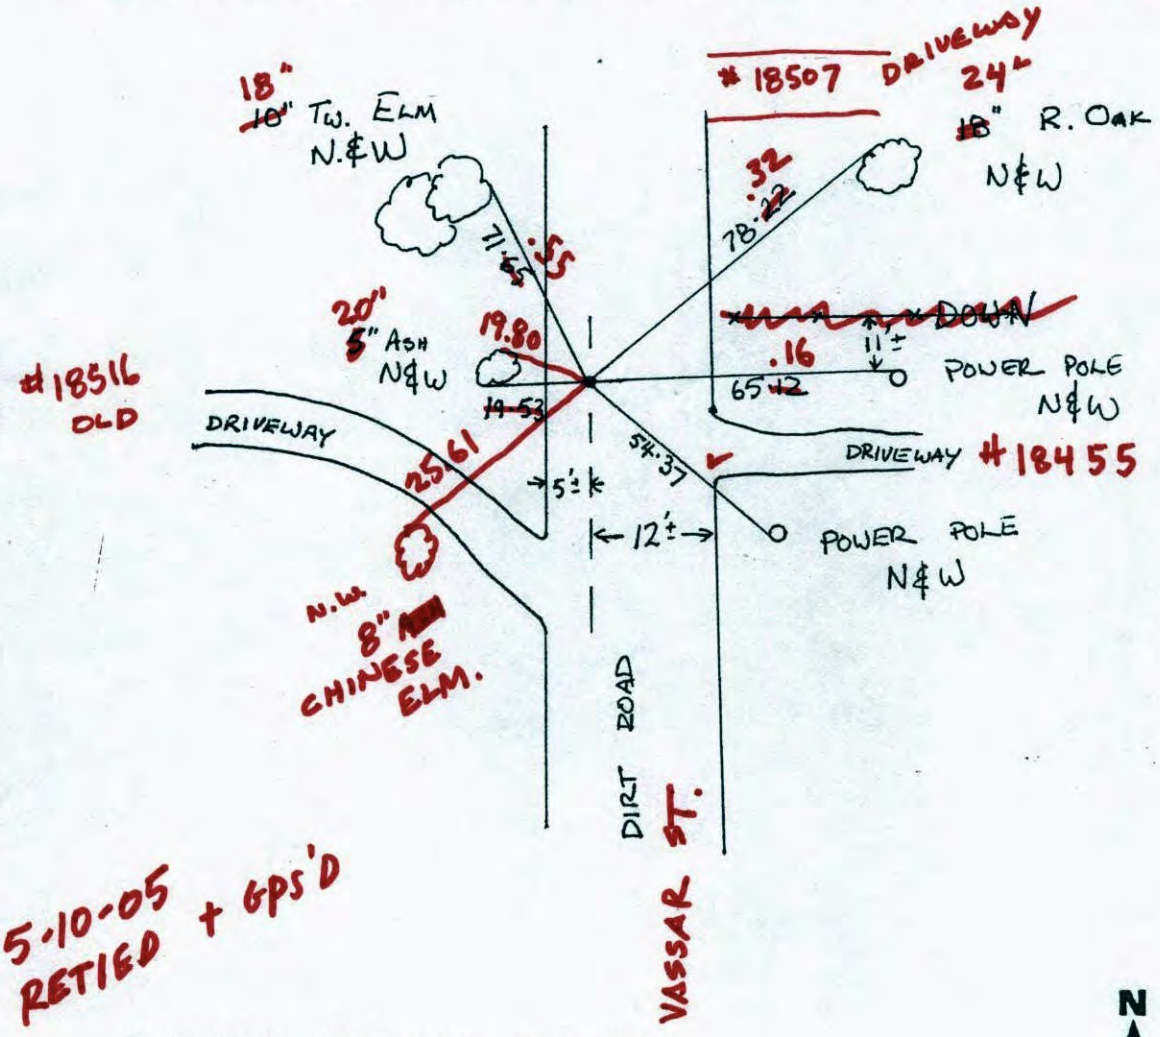

5-10-05 RETIED + GPS'D

Revised date	Revised date	Revised date
12-26-90		

N
W ANOKA COUNTY SURVEYOR E
S

CERTIFICATE OF LOCATION OF GOVERNMENT CORNER

County of Anoka *State of Minnesota*

WEST QUARTER Corner of Sec. 36 Township 33 Range 22

I hereby certify that on the ____ *day of* APRIL, *19*68, *I found the described corner which was evidenced by* A SPIKE.

and I further certify that to perpetuate the location of said corner, I did, at the exact location thereof, place a permanent marker consisting of CAST IRON MONUMENT.

which reference or witness monuments are located in the manner following:

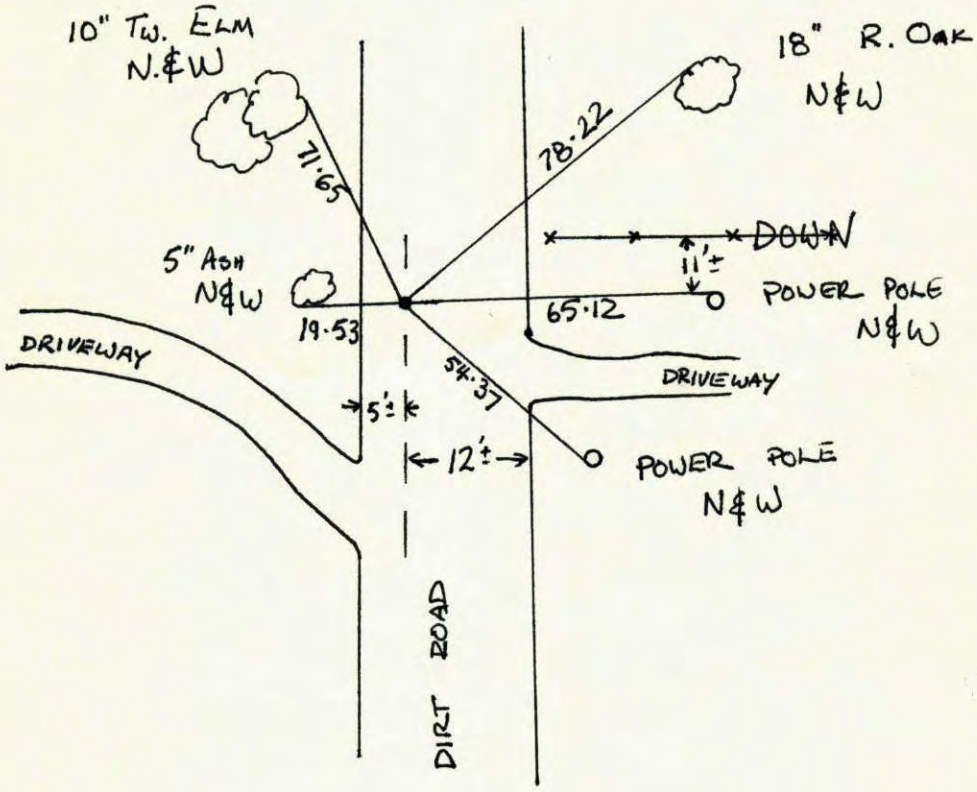

Revised date	Revised date	Revised date
12-26-90		

N
W ANOKA COUNTY SURVEYOR E
S

W 1/4 Cor. Sec. 36-T33-R22

Ties Taken by Jim Kurth Apr 1968

~~R.R. Spike~~ Down. 0.2'

Replaced Spike with Cast Iron Monument down 0.5'±. Sept. 23, 1969 D. Powell R. Olson

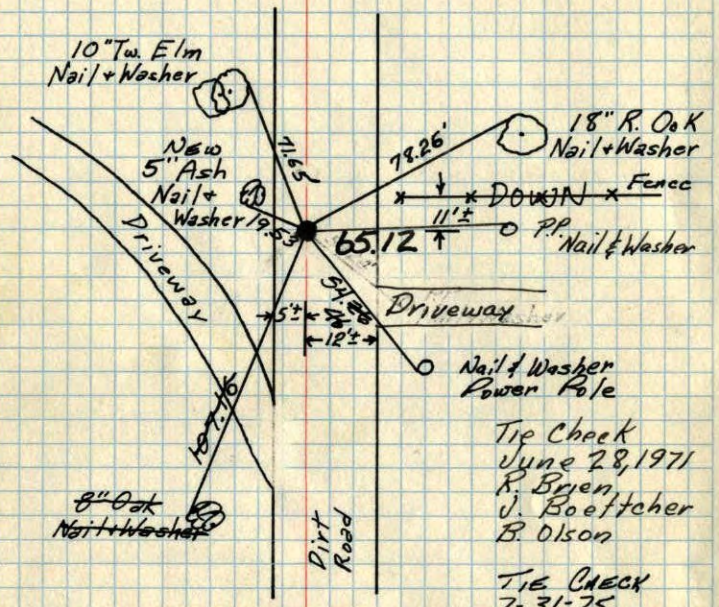

Tie Check
6-13-81
P. Ross
P. Hornby
G. Nolfinger

Tie Check
June 28, 1971
R. Bruen
J. Boettcher
B. Olson

Tie Check
7-31-78
M. Kisrow
B. Stephens

TIE CHECK
7-31-75
O. OAHL
B. SANNERUD
G. ADAMS

TEMPERATURE CORRECTED AND HORIZONTALLY TAPED MEASUREMENTS

ROLAND W. ANDERSON
COUNTY SURVEYOR
ANOKA COUNTY, MINNESOTA

W 1/4 Cor. Sec. 36-T33-R22

Ties Taken by Jim Kurth Apr 1968

R.R. Spike Down. 0.2'

Ties check to Nail + Disks of Kurth's. New ties to N+W of Anoka Co.
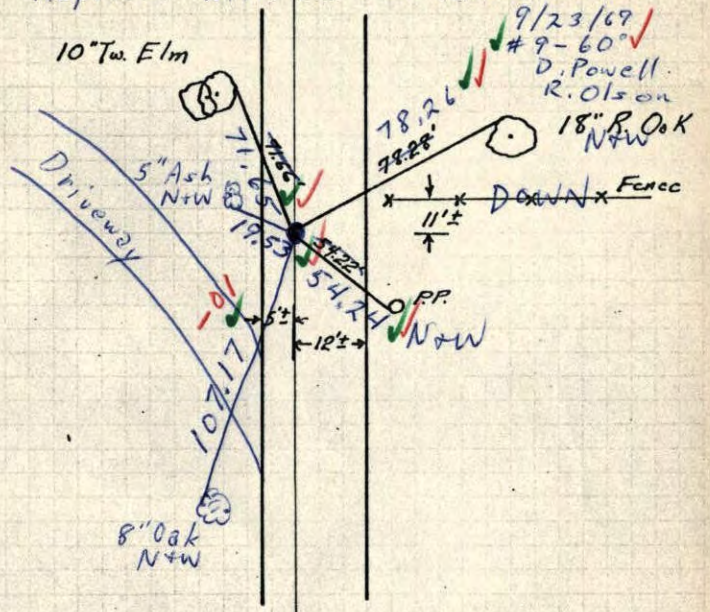
Replaced with C.I. Mon. down 0.5'±.