SHOT GPS 7-2-03

Page No. 138

CERTIFICATE OF LOCATION OF GOVERNMENT CORNER

County of Anoka *State of Minnesota*

EAST QTR. Corner of Sec. 36 Township 33 Range 22

I hereby certify that on the 26 *day of* JULY, 1966, *I found the described corner which was evidenced by* AREA SURVEY

and I further certify that to perpetuate the location of said corner, I did, at the exact location thereof, place a permanent marker consisting of CAST IRON MONUMENT

which reference or witness monuments are located in the manner following:

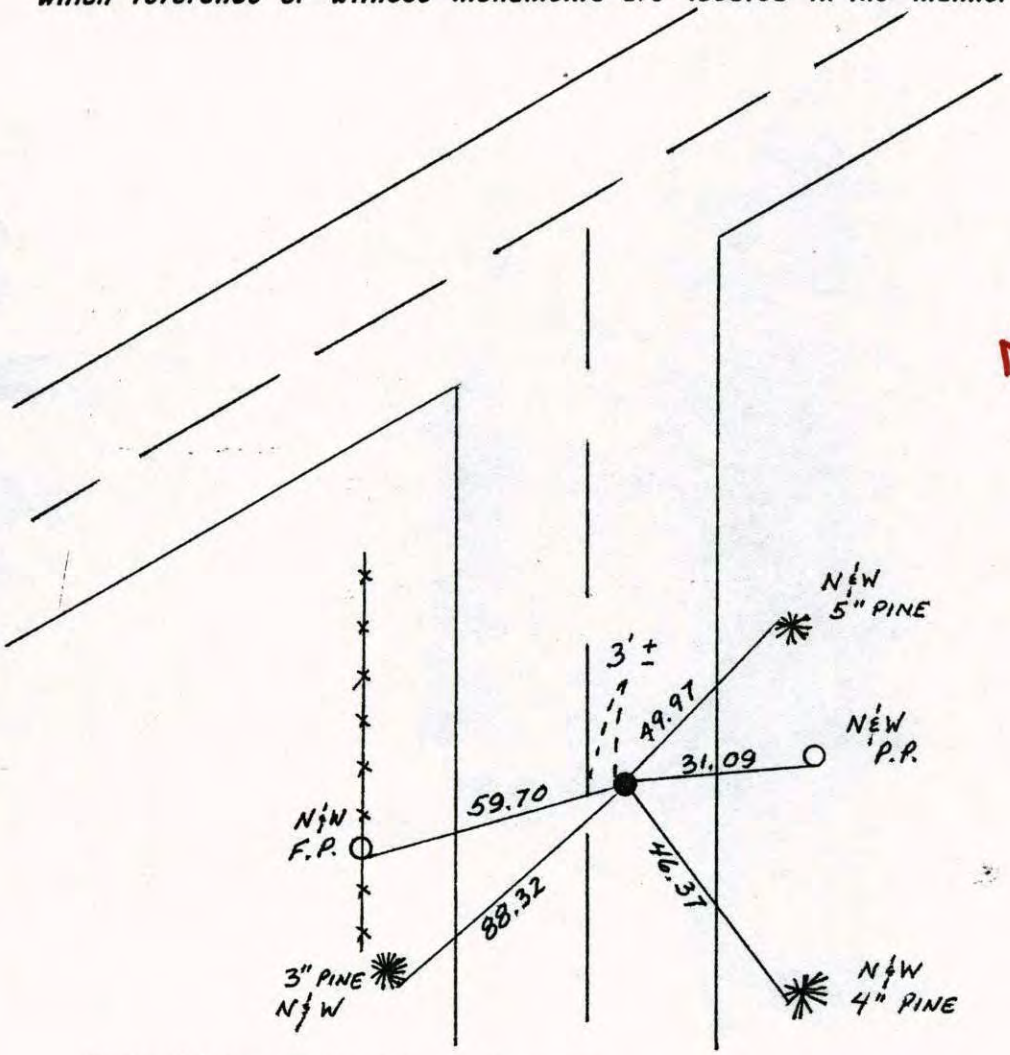

NEEDS TO BE RAISED 2.5' UNDER BLKTP. JS.

Revised date	Revised date	Revised date
10-17-90		

N
W ANOKA COUNTY E
SURVEYOR
S

CERTIFICATE OF LOCATION OF GOVERNMENT CORNER

County of Anoka *State of Minnesota*

EAST QTR. Corner of Sec. 36 Township 33 Range 22

I hereby certify that on the 26 *day of* JULY, 1966, *I found the described corner which was evidenced by* AREA SURVEY

and I further certify that to perpetuate the location of said corner, I did, at the exact location thereof, place a permanent marker consisting of CAST IRON MONUMENT

which reference or witness monuments are located in the manner following:

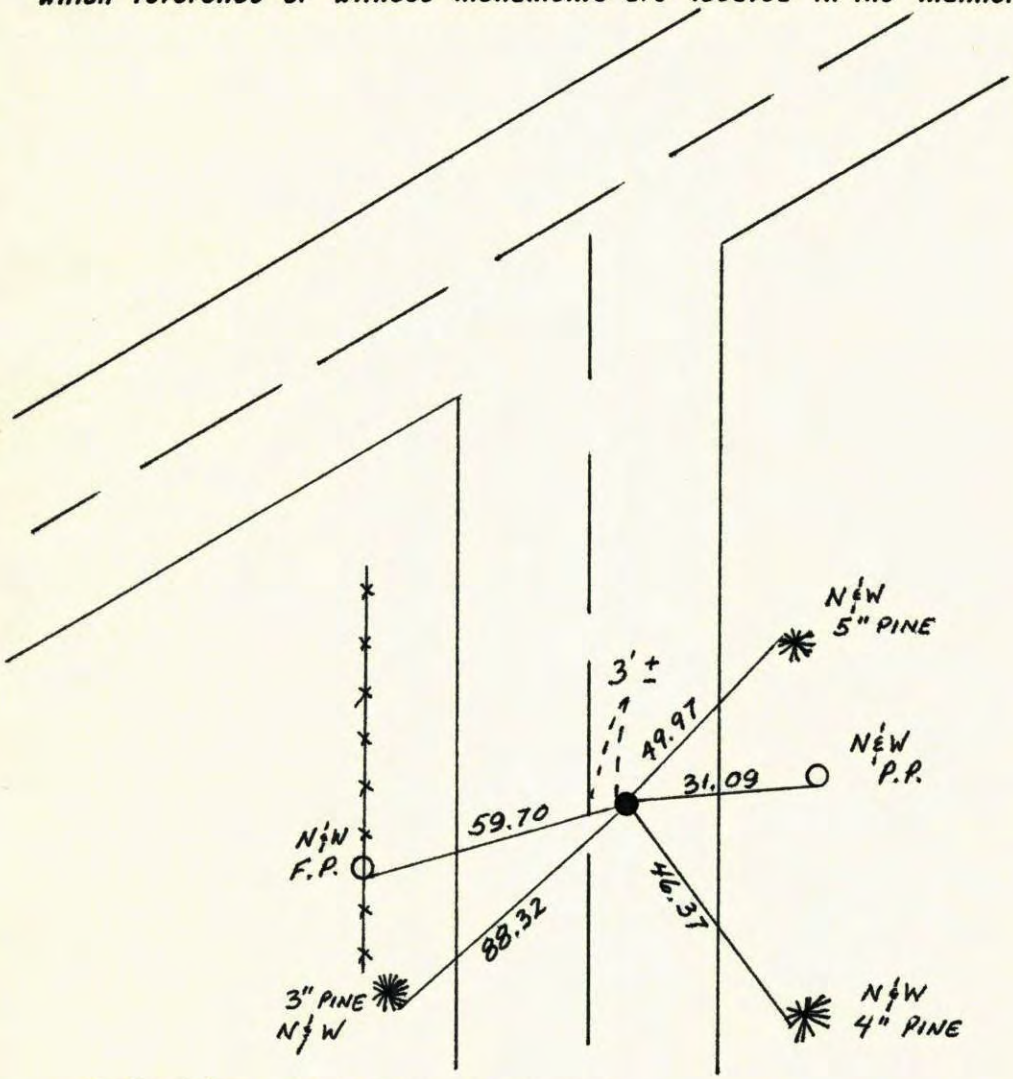

Revised date	Revised date	Revised date
10-17-90		

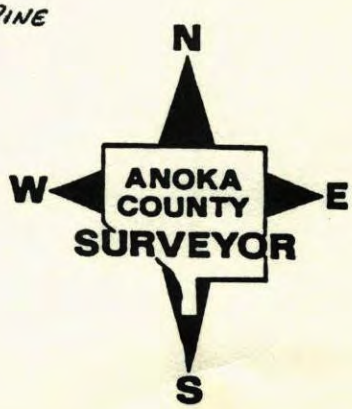

138

E 1/4 Cor. Sec. 36, T33 R22

Cor. Set from area resurvey

Set C.I. Monument down ~~.85~~ → ~~1.5'±~~ 2.0

Mon. is on ℄ of Dirt Road

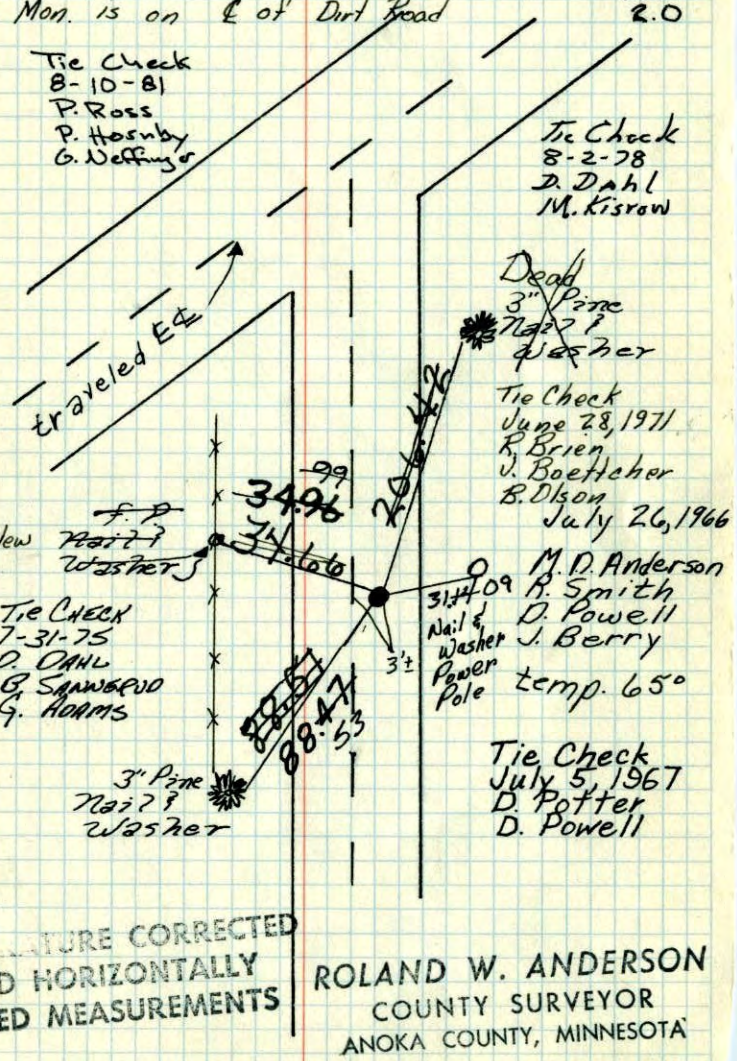

~~TURE~~ CORRECTED
AND HORIZONTALLY
TAPED MEASUREMENTS

ROLAND W. ANDERSON
COUNTY SURVEYOR
ANOKA COUNTY, MINNESOTA

~~24~~

E 1/4 Cor. Sec. 36, T33 R22

Cor. Set from area resurvey

Set C.I. Monument ~~down .85'~~ DOWN 1.5'±

7-5-77
D. POTTER
P. POWELL
#7 - 61°

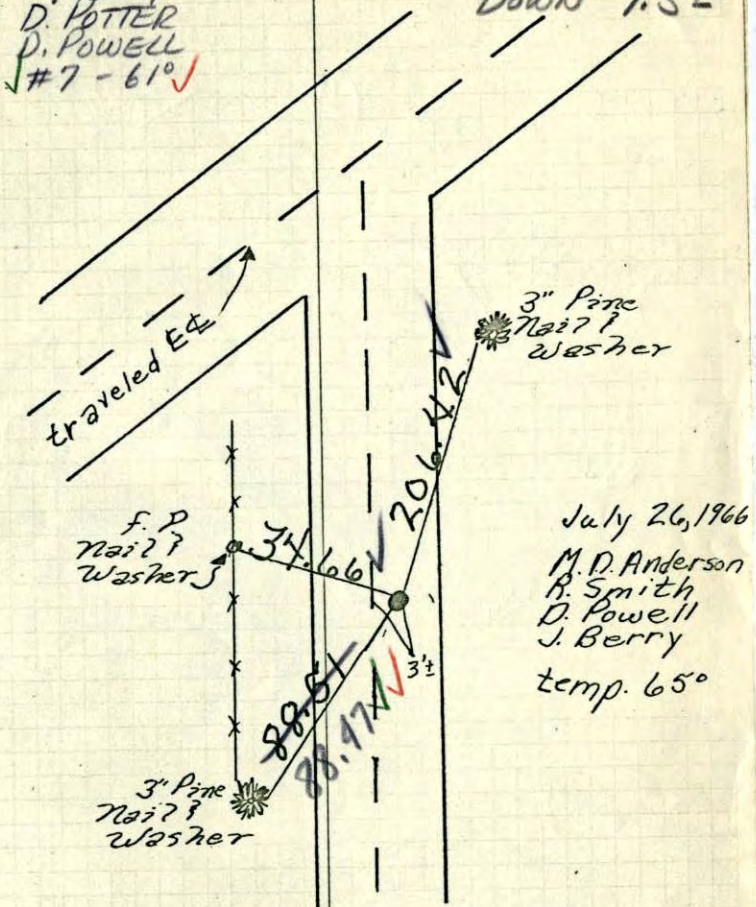

~~TURE~~ CORRECTED
AND HORIZONTALLY
TAPED MEASUREMENTS

ROLAND W. ANDERSON
COUNTY SURVEYOR
ANOKA COUNTY, MINNESOTA

E 1/4 Cor. Sec. 36 - T33 - R22

Cor. set from area resurvey
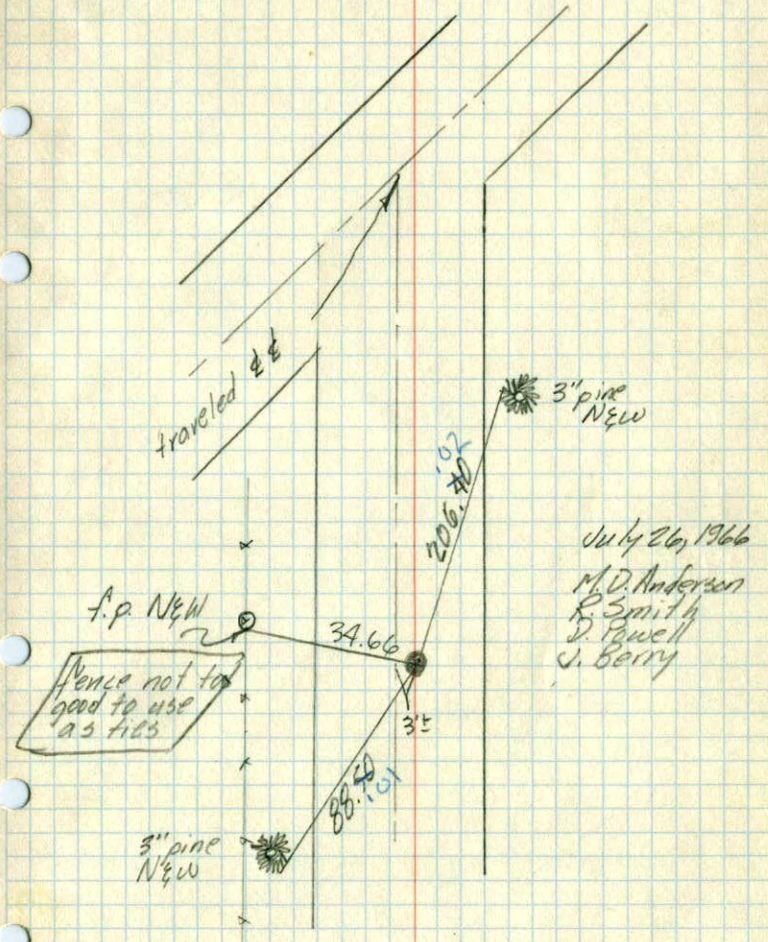
Set C.I. Monument down 0.5' ±