Page No. 139

CERTIFICATE OF LOCATION OF GOVERNMENT CORNER

County of Anoka State of Minnesota

Witness Corner of Sec. 36 Township 33 Range 22

(On east line of section)

On the 2nd day of August, 1966, the described corner was evidenced by area resurvey

and to perpetuate the location of said corner, at the exact location thereof, a permanent marker was placed consisting of a cast iron monument (ANOKA MON./C.M.) CHISAGO COUNTY SIGN POST ON N. SIDE

AND on the ___ day of _____, ____, said permanent marker was _____

Updated reference ties are as shown below.

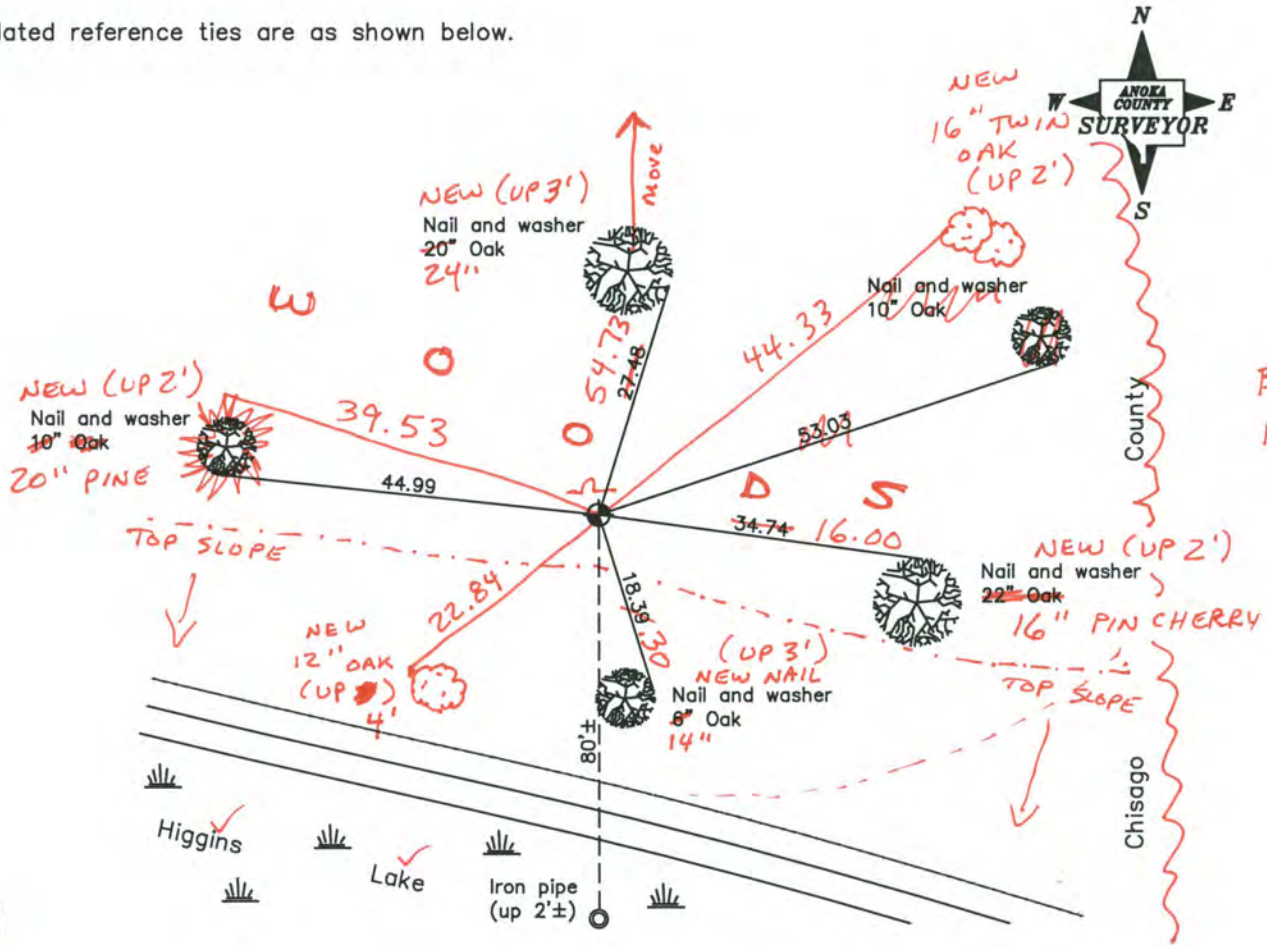

9-8-14
BK-55
TAPED

Revised date

11/02/90

N.A.D. 1983 Coordinates
(1996 Adjustment)

County Project Coordinates	
Northing	196100.8329
Easting	563590.3496
Date	5/27/04

I hereby certify that this United States public land survey monument record is correct and complete to the best of my knowledge and belief.

_____ Date _____

_____, Anoka County Surveyor

Minnesota License Number _____

Page No. 139

CERTIFICATE OF LOCATION OF GOVERNMENT CORNER

County of Anoka *State of Minnesota*

WITNESS E. LINE Corner of Sec. 36 Township 33 Range 22

I hereby certify that on the 2 *day of* AUG. , 1966, *I found the described corner which was evidenced by* AREA SURVEY

and I further certify that to perpetuate the location of said corner, I did, at the exact location thereof, place a permanent marker consisting of CAST IRON

which reference or witness monuments are located in the manner following:

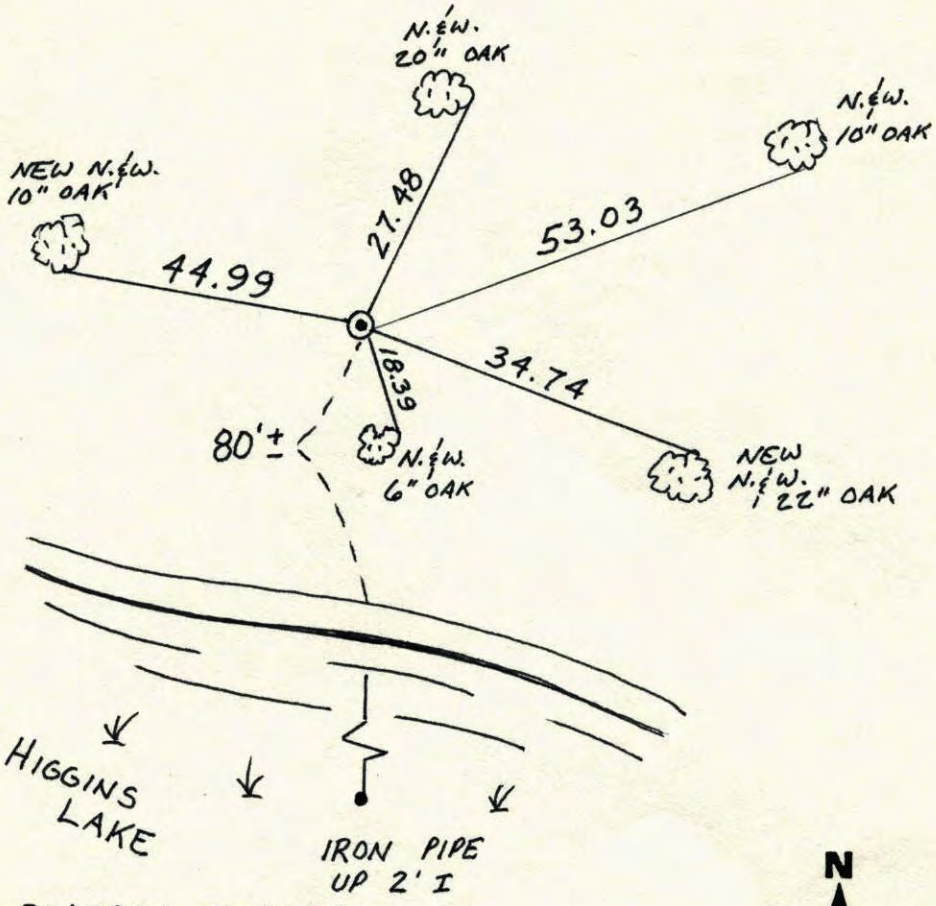

Revised date	Revised date	Revised date
11-2-90		

N
W ANOKA COUNTY SURVEYOR E
S

139

Witness Corner On East Line Of Section 36 - T33 - R22

SET CAST IRON MONUMENT FLUSH FROM AREA RESURVEY.

2 AUG 66
M.D. ANDERSON
R. SMITH
D. POWELL

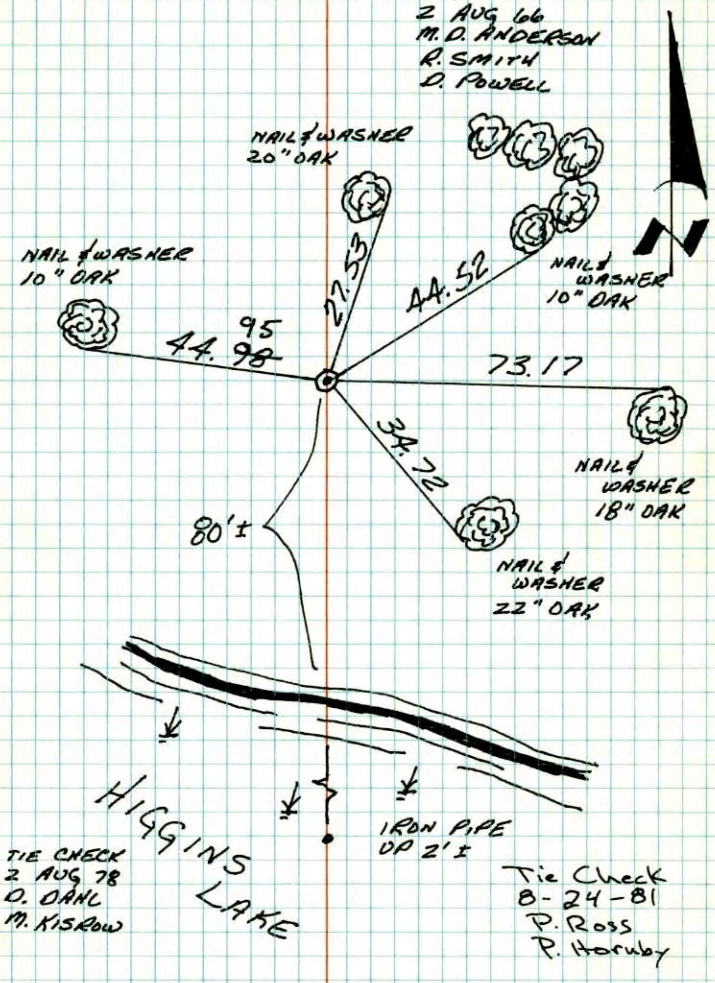

TIE CHECK
2 AUG 78
D. DAHL
M. KISROW

Tie Check
8-24-81
P. Ross
P. Hornby

TEMPERATURE CORRECTED AND HORIZONTALLY TAPED MEASUREMENTS

ROLAND W. ANDERSON
COUNTY SURVEYOR
ANOKA COUNTY, MINNESOTA

NO. 448 TELEDYNE

139

Witness Cor. on East Line Sec. 36, T33, R22

Set cast iron monument From area resurvey. Flush

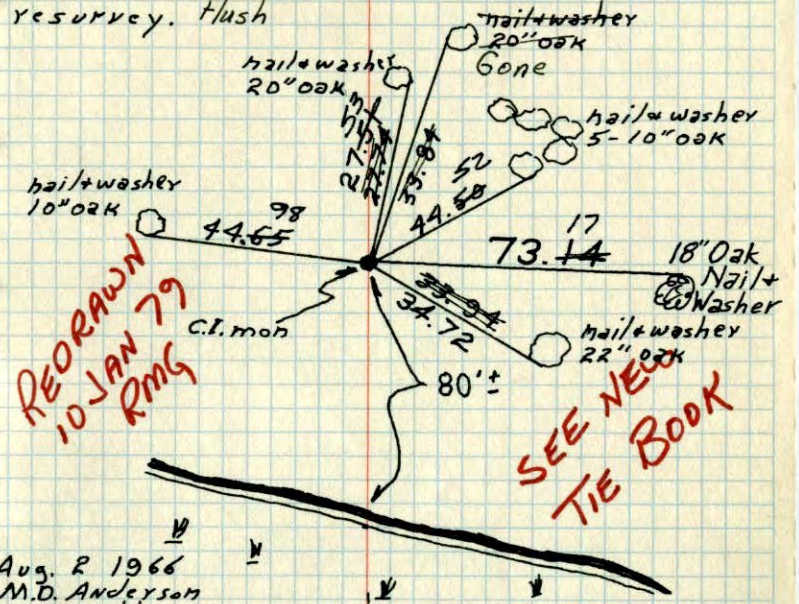

Aug. 2 1966
M.D. Anderson
R. Smith
D. Powell

2 I.P. up 2'±

Higgins Lake

Tie Check
July 5 1967
D. Potter
D. Powell

Tie Check
June 28 1971
R. Brien
J. Boettcher
B. Olson

TIE CHECK
7-31-75
O. Dahl
B. Sannerud
G. Adams

Tie Check
8-2-78
D. Dahl
M. Kisrow

TEMPERATURE CORRECTED AND HORIZONTALLY TAPED MEASUREMENTS

ROLAND W. ANDERSON
COUNTY SURVEYOR
ANOKA COUNTY, MINNESOTA

~~33~~

X

Witness Cor. on East Line Sec. 36, T33, R22

Set cast iron monument from area resurvey.

TEMPERATURE CORRECTED AND HORIZONTALLY TAPED MEASUREMENTS

ROLAND W. ANDERSON
COUNTY SURVEYOR
ANOKA COUNTY, MINNESOTA

Witness Cor. on East line Sec 36-T33-R22

Set C.I. Monument from area resurvey

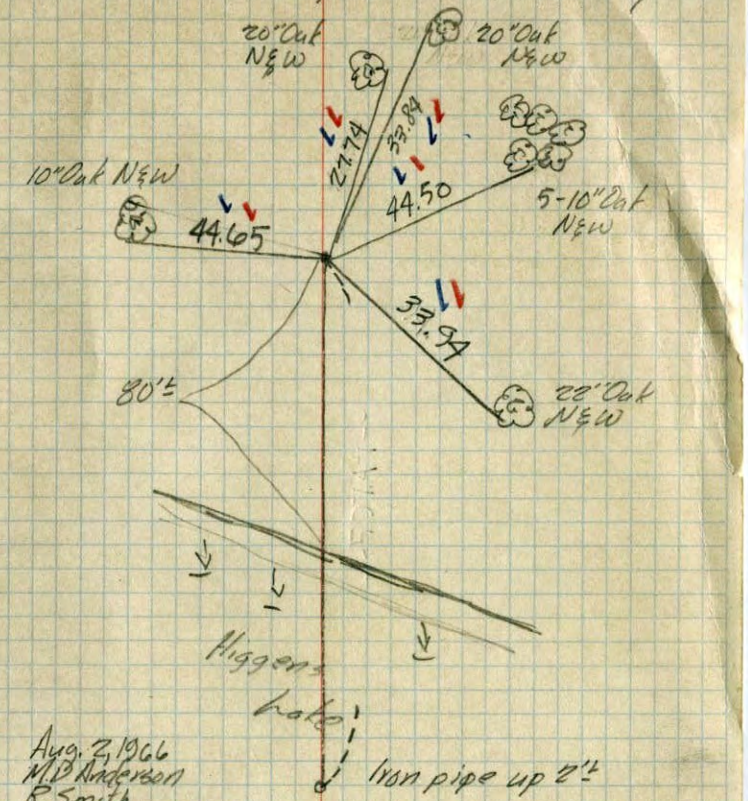

Aug. 2, 1966
M.D. Anderson
R. Smith
D. Powell

Temp. 78° ✓

TAPE 6