W.C. ON SOUTH LINE OF SE 1/4 SECTION 36
T33 R22

SET CAST IRON MONUMENT FROM
AREA SURVEY C.L. FLUSH PK'S 2.00' N. + E.

#5 60°
10-22-86
W. LARSON
B. GUETZKO
W. GRAMS

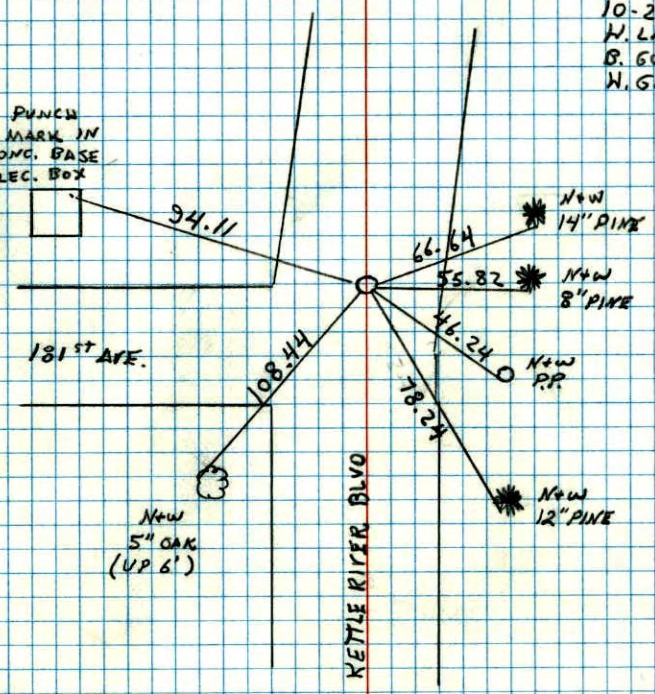

NO. 448 TELEDYNE