Page No. 26

CERTIFICATE OF LOCATION OF GOVERNMENT CORNER

County of Anoka State of Minnesota

Northeast Corner of Sec. 10 Township 33 Range 22

On the 10th day of July, 1974, the described corner was evidenced by area resurvey

and to perpetuate the location of said corner, at the exact location thereof, a permanent marker was placed consisting of a cast iron monument with a sign and post on the north side

Mon. ● and ties are on SW END OF OVAL ISLAND

AND on the ___ day of _____, ____, said permanent marker was _____

Updated reference ties are as shown below.

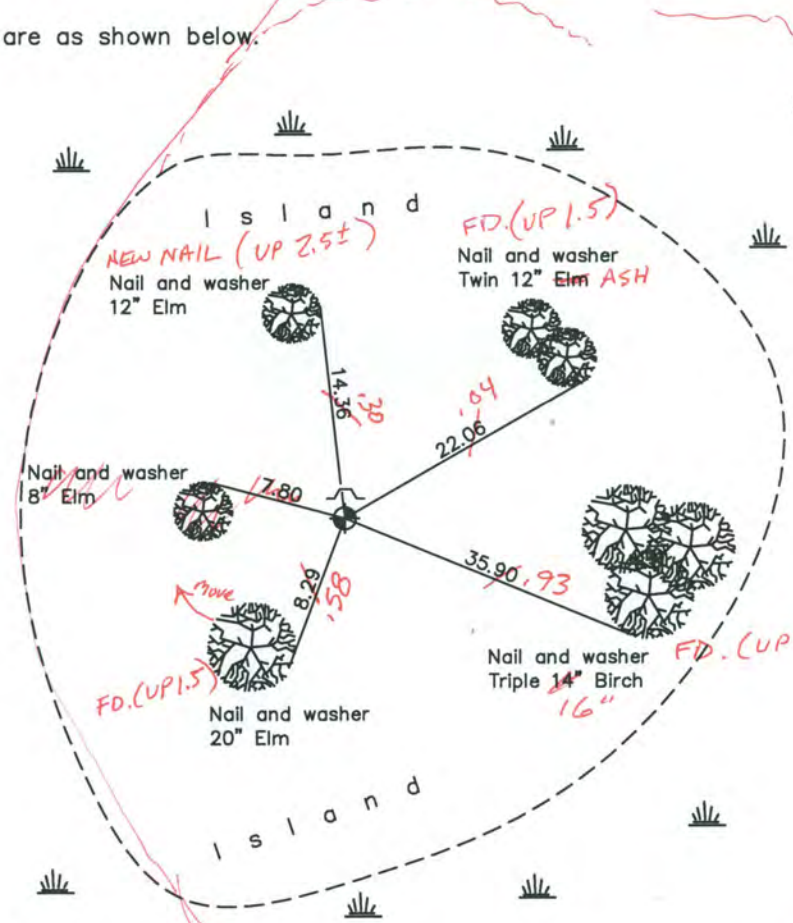

12-10-13
BK-55
TAPED

Revised date
5/23/90
6/08/95

N.A.D. 1983 Coordinates (1996 Adjustment)

County Project Coordinates	
Northing	222079.9607
Easting	553208.9218
Date	2/23/05

I hereby certify that this United States public land survey monument record is correct and complete to the best of my knowledge and belief.

_____ Date _____

_____, Anoka County Surveyor

Minnesota License Number _____

Page No. 26

CERTIFICATE OF LOCATION OF GOVERNMENT CORNER

County of Anoka *State of Minnesota*

NORTHEAST Corner of Sec. 10 Township 33 Range 22

I hereby certify that on the 10 *day of* JULY, 19 74, *I found the described corner which was evidenced by* AREA RESURVEY

and I further certify that to perpetuate the location of said corner, I did, at the exact location thereof, place a permanent marker consisting of CAST IRON MONUMENT WITH SIGN AND POST ON THE NORTH SIDE

which reference or witness monuments are located in the manner following:

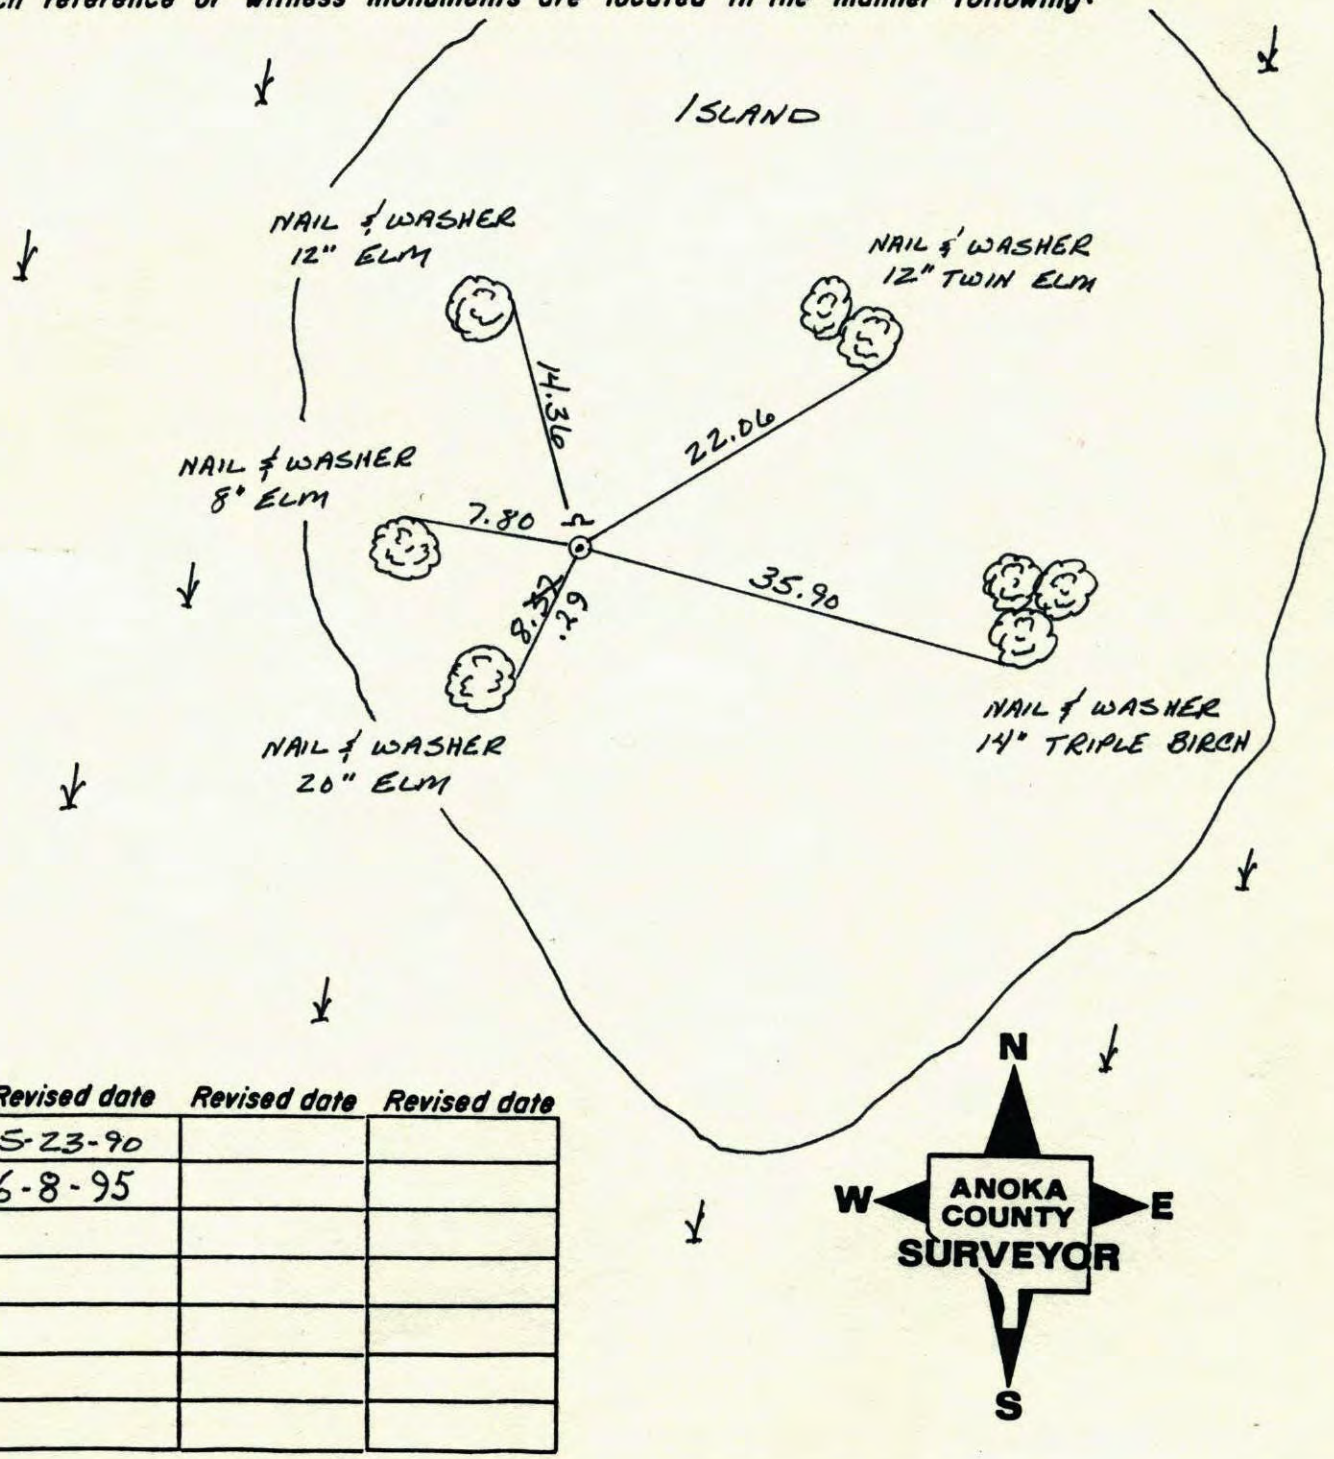

Revised date	Revised date	Revised date
5-23-90		
6-8-95		

NORTHEAST CORNER SECTION 10 T33 R22

SET SIGN AND POST ON NORTH SIDE AND RETIED.

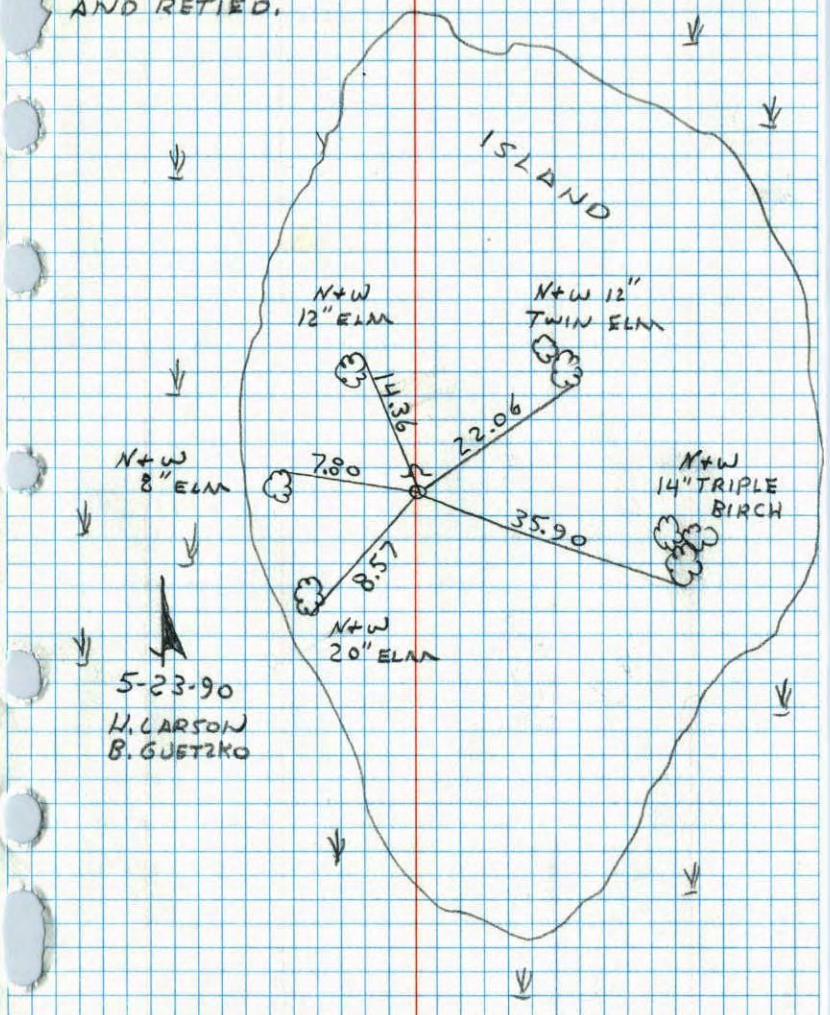

5-23-90
H. LARSON
B. GUETZKO

NO. 448
TELEDYNE

N.E. Cor. Sec. 10 - T33 - R22

Set Cast Iron Mon. From Area Resurvey

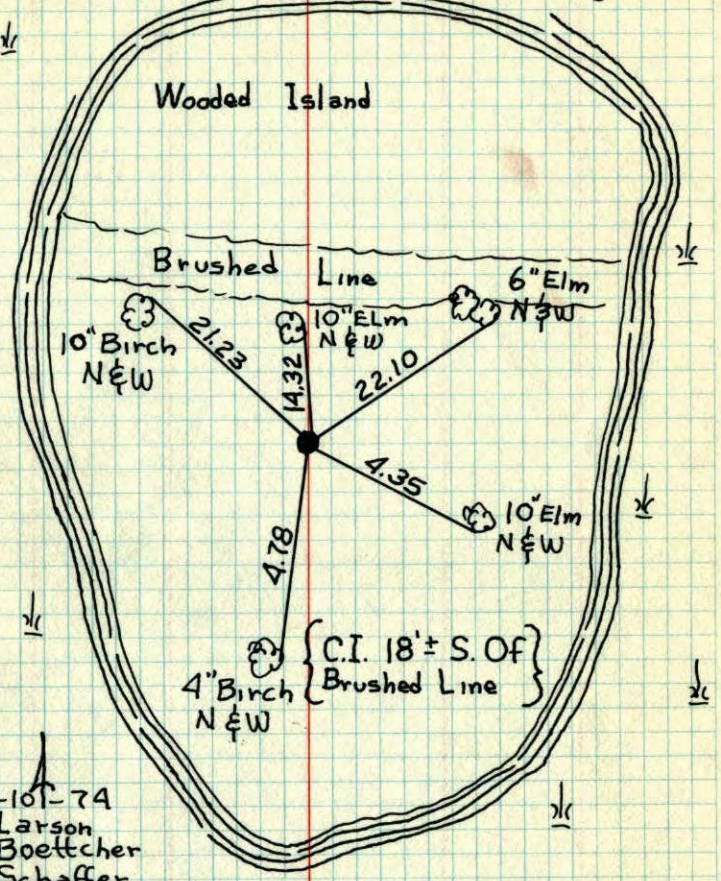

7-10-74
H. Larson
J. Boettcher
B. Schaffer
Temp. 80°
Tape #14

ROLAND W. ANDERSON
COUNTY SURVEYOR
ANOKA COUNTY, MINNESOTA

TEMPERATURE CORRECTED AND HORIZONTALLY TAPED MEASUREMENTS

NE Cor. Sec. 10 T33 R22
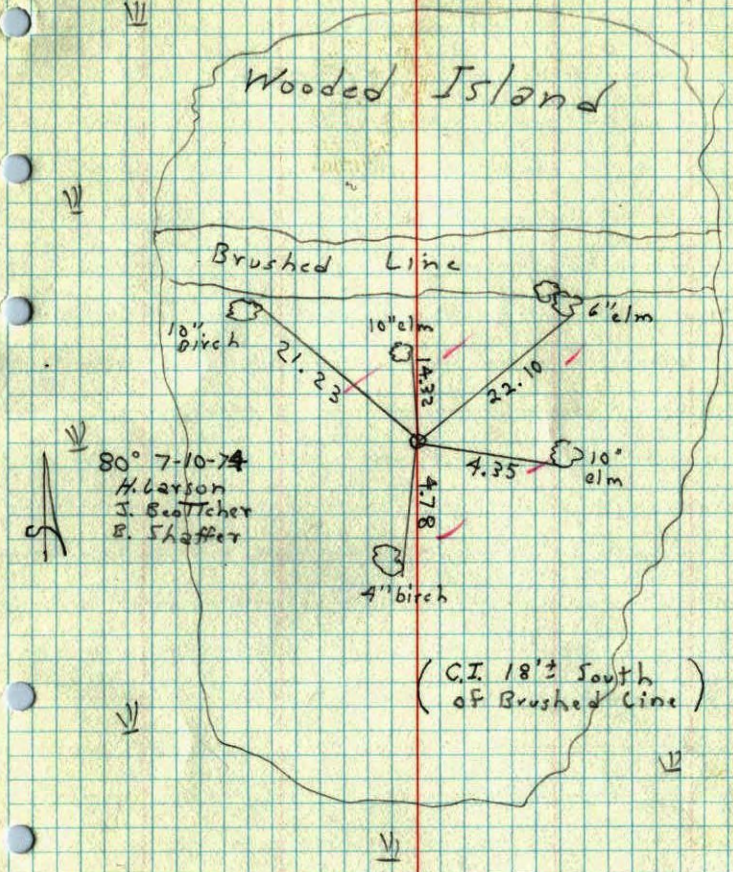
Set cast iron mon. From orig. resurvey