Point on North line N.E. 1/4 Sec.9-T33-R22

placed 1/2" iron pipe in Road
Set from area Resurvey

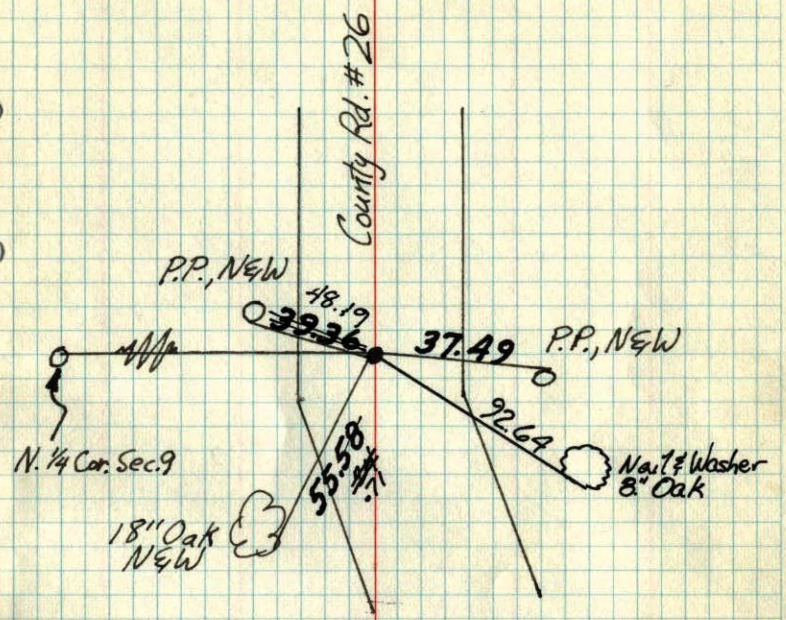

TIE CHECK
8-4-81
P. ROSS
P. HORNBY
G. NEFFINGER

TIE CHECK
August 28, 1984
G. Lips
D. Ross
P. Vogel

TEMPERATURE CORRECTED AND HORIZONTALLY TAPED MEASUREMENTS

ROLAND W. ANDERSON
COUNTY SURVEYOR
ANOKA COUNTY, MINNESOTA