CERTIFICATE OF LOCATION OF GOVERNMENT CORNER

County of Anoka State of Minnesota

West 1/4 Corner of Sec. 8 Township 33 Range 22

On the 24th day of November, 1959, the described corner was evidenced by a pinched iron pipe

and to perpetuate the location of said corner, at the exact location thereof, a permanent marker was placed consisting of a cast iron monument

AND on the ___ day of _____, ____, said permanent marker was _____

Updated reference ties are as shown below.

N
W ANOKA COUNTY SURVEYOR E
S

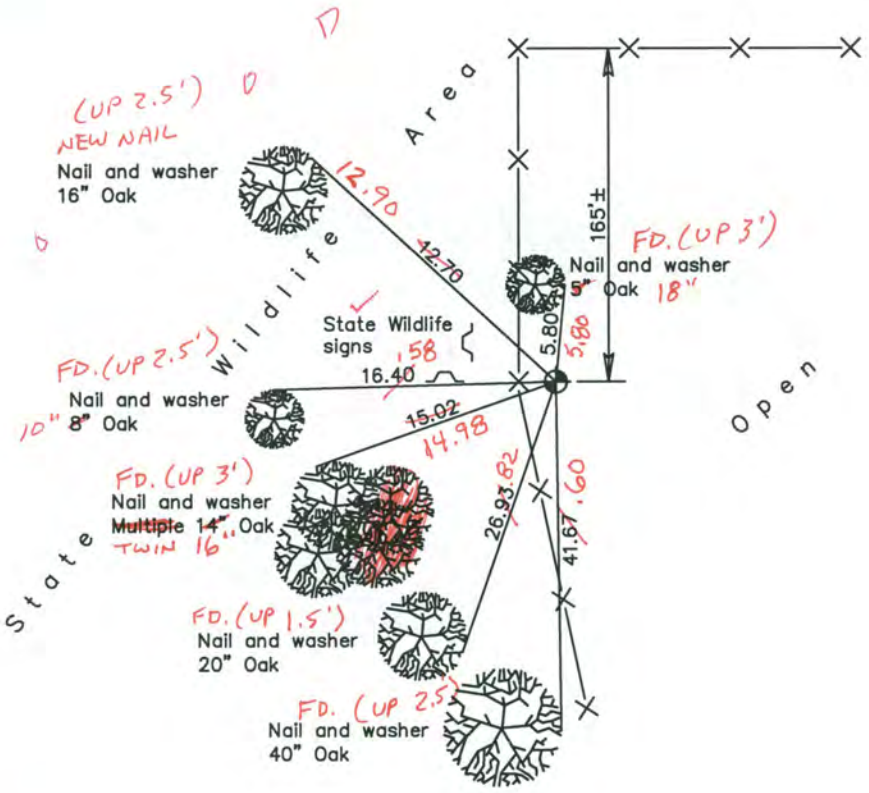

11-27-13
BK-55
TAPED

Revised date
8/24/84
8/12/87
8/09/95

N.A.D. 1983 Coordinates
(1996 Adjustment)

County Project Coordinates	
Northing	219337.5873
Easting	536922.0955
Date	3/01/05

I hereby certify that this United States public land survey monument record is correct and complete to the best of my knowledge and belief.

_____ Date _____

_____, Anoka County Surveyor

Minnesota License Number _____

CERTIFICATE OF LOCATION OF GOVERNMENT CORNER

County of Anoka State of Minnesota

WEST 1/4 Corner of Sec. 8 Township 33 Range 22

I hereby certify that on the 24 day of NOV, 1959, I found the described corner which was evidenced by PINCHED IRON PIPE

and I further certify that to perpetuate the location of said corner, I did, at the exact location thereof, place a permanent marker consisting of CAST IRON MONUMENT

which reference or witness monuments are located in the manner following:

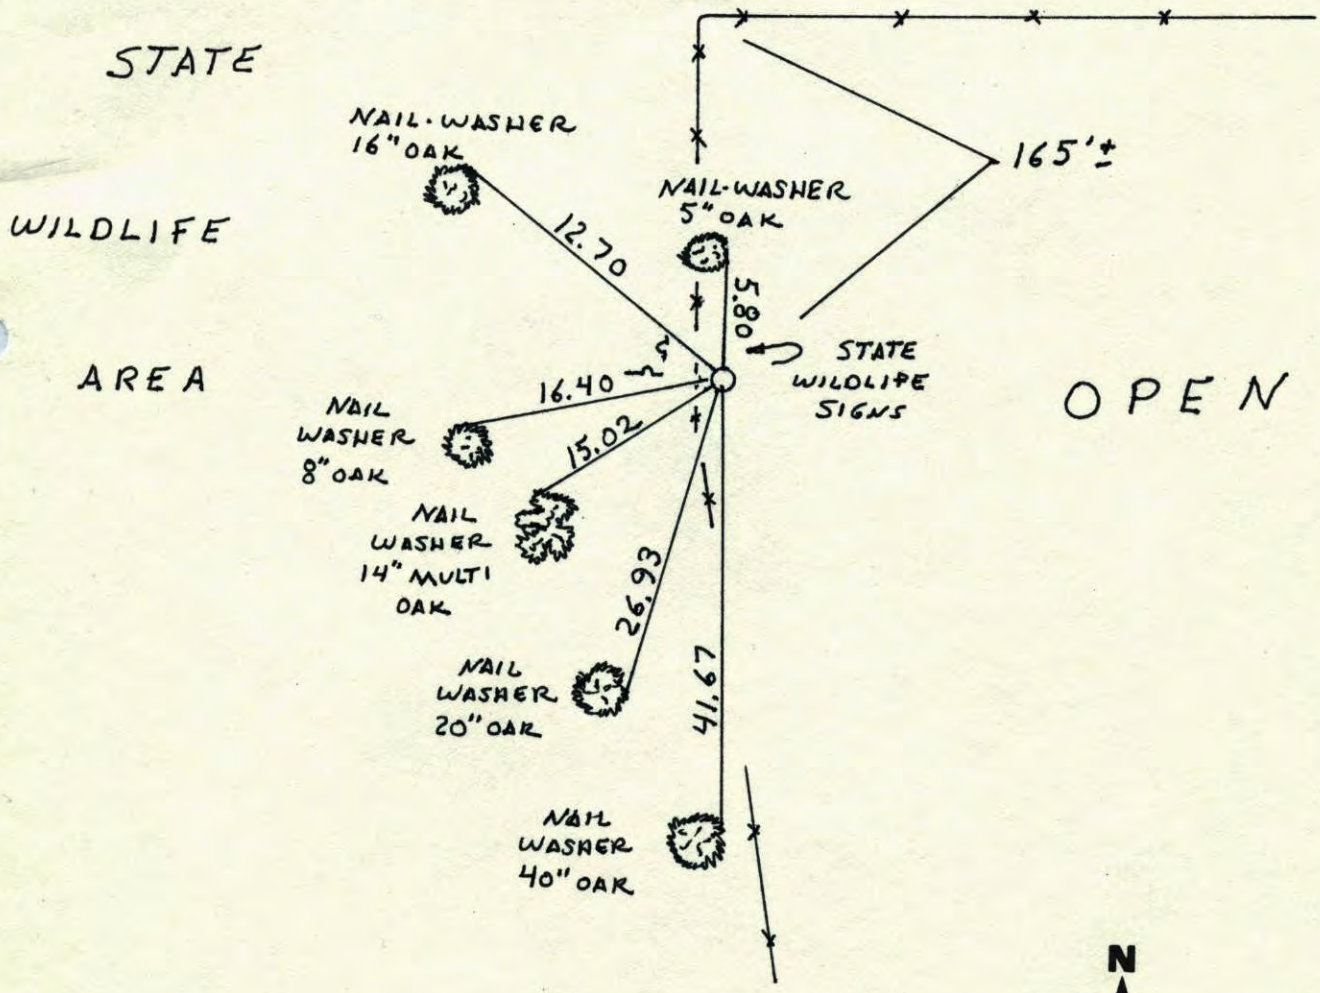

Revised date	Revised date	Revised date
7-6-71		
7-6-75		
7-20-78		
8-24-81		
8-24-84		
8-12-87		
8-9-95		

N
W ANOKA COUNTY SURVEYOR E
S

WEST 1/4 Sec. 8 Tw. 33 R. 22

RETIE CAST IRON MON.

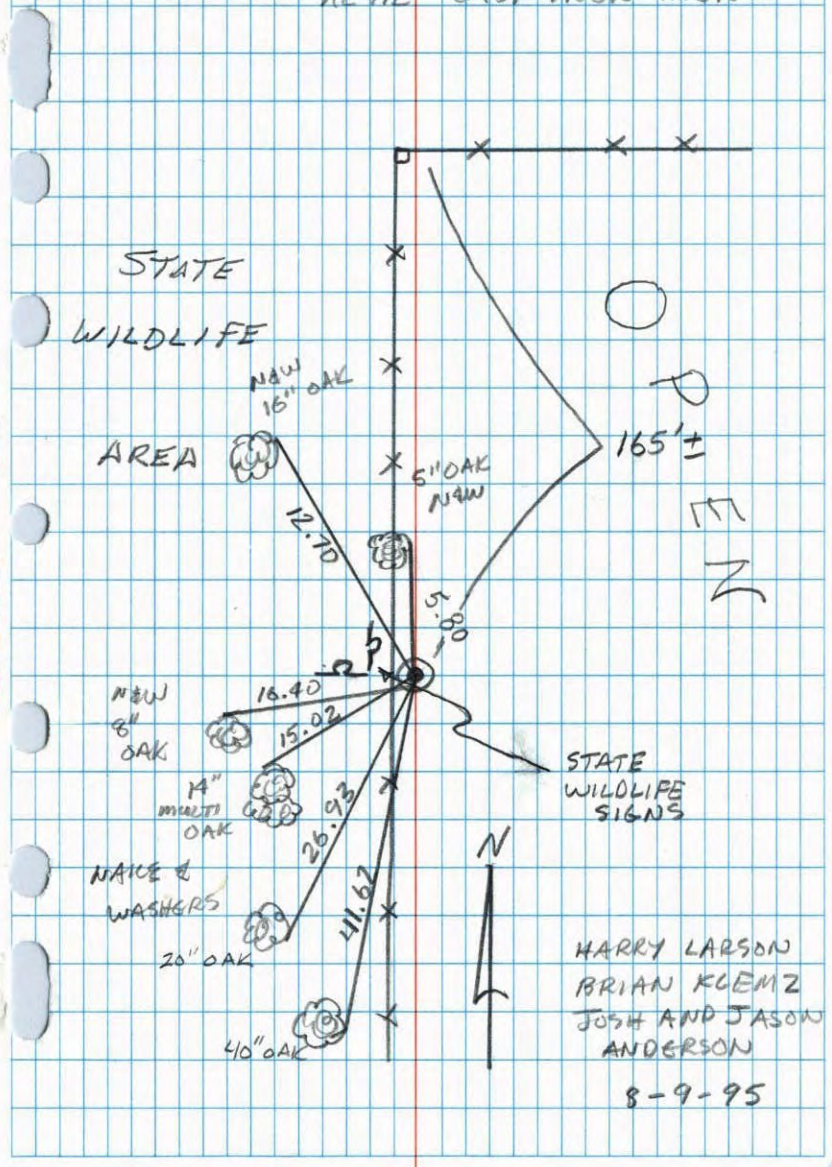

NATIONAL PRINTFAST NO. 446

W1/4 Cor. Sec. 8-T33-R22

Cast Iron Monument flush

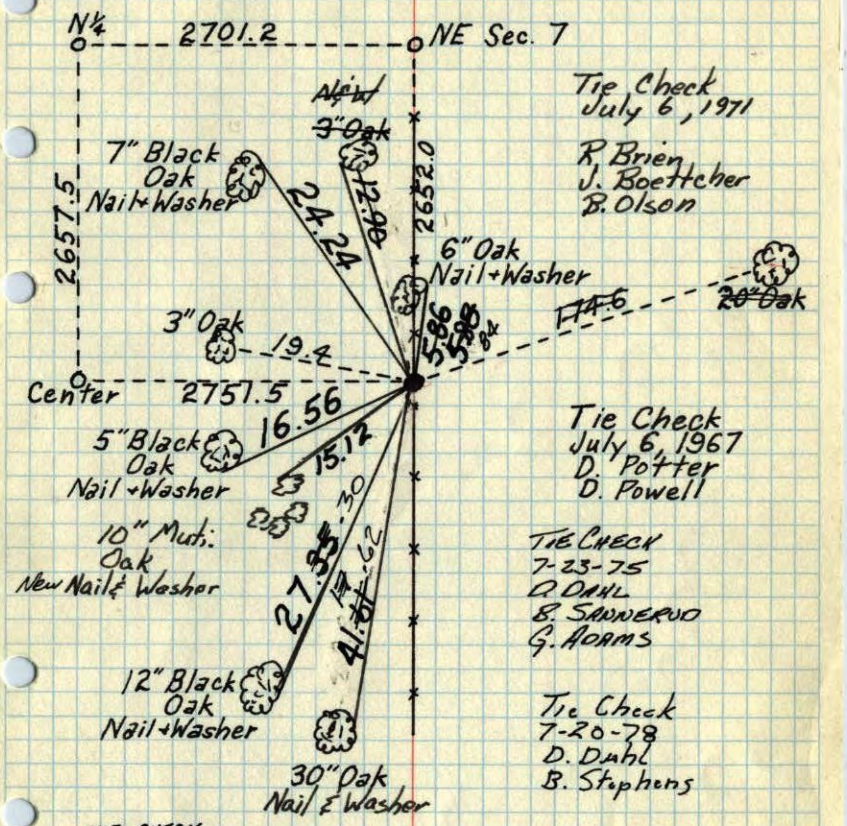

Tie Check
July 6, 1971
R Brien
J. Boettcher
B. Olson

Tie Check
July 6, 1967
D. Potter
D. Powell

TIE CHECK
7-23-75
D. Dahl
B. Sanderud
G. Adams

Tie Check
7-20-78
D. Duhl
B. Stephens

TIE CHECK
8-24-81
P. Ross
P. Hornby

TIE CHECK
August 24, 1984
D. Vogel
D. Ross
G. Lips

TEMPERATURE CORRECTED AND HORIZONTALLY TAPED MEASUREMENTS

ROLAND W. ANDERSON
COUNTY SURVEYOR
ANOKA COUNTY, MINNESOTA

SET C.I

~~12~~

W 1/4 Corner Sec. 8, T33, R22

Pinched I.P. CAST IRON
6/16/58 ~~SET~~
FLUSH

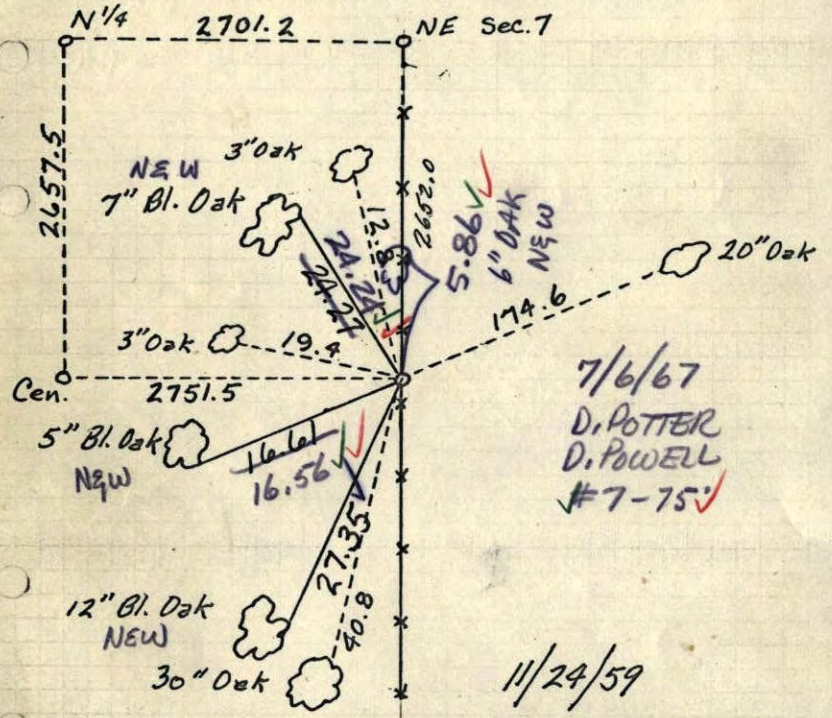

7/6/67
D. POTTER
D. POWELL
#7-75

11/24/59

Bill Rogers Assist.

ROLAND W. ANDERSON
COUNTY SURVEYOR
ANOKA COUNTY, MINNESOTA
---- N.C. Holum

12

W 1/4 Corner Sec. 8, T33, R22

Pinched I.P.
6/16/58

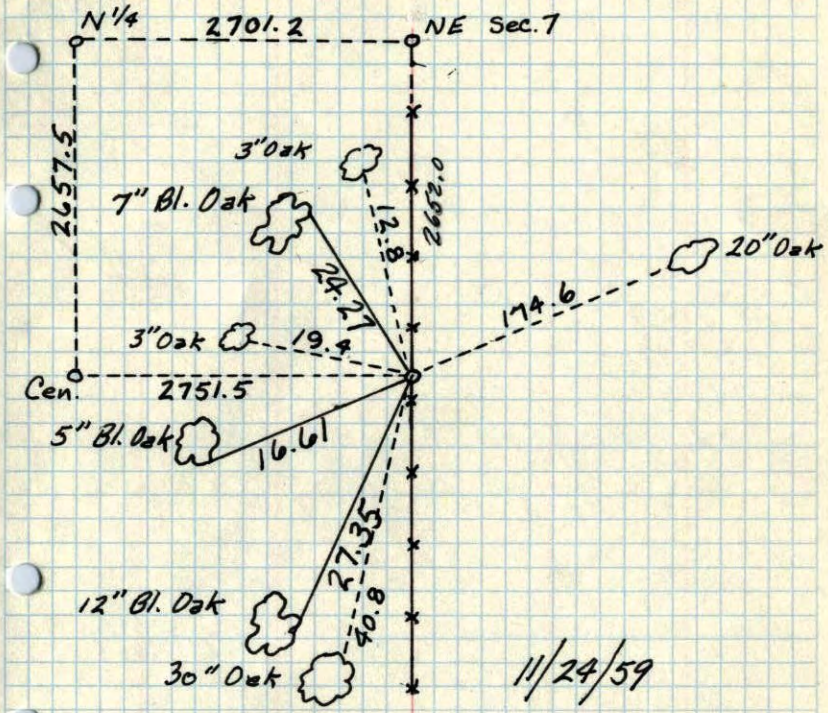

11/24/59

Bill Rogers Assist.

ROLAND W. ANDERSON
COUNTY SURVEYOR
ANOKA COUNTY, MINNESOTA
---- N.C. Holum

W 1/4 Corn. Sec. 8, 33-22

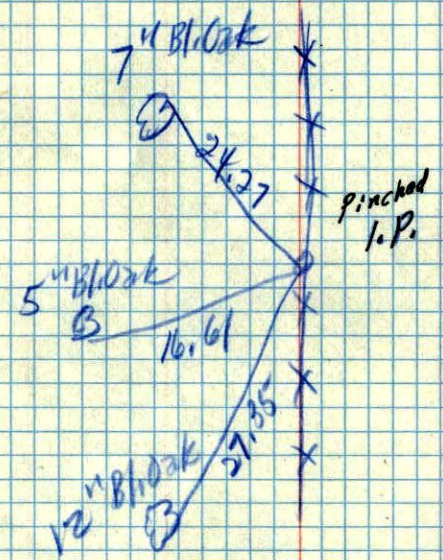

11/24/59
Bill Rogers Assist.