Page No. 40

CERTIFICATE OF LOCATION OF GOVERNMENT CORNER

County of Anoka State of Minnesota

West 1/4 Corner of Sec. 9 Township 33 Range 22

On the 28th day of December, 1961, the described corner was evidenced by area resurvey

and to perpetuate the location of said corner, at the exact location thereof, a permanent marker was placed consisting of a cast iron monument with a sign and post on the north side

AND on the ___ day of _____, ____, said permanent marker was _____

Updated reference ties are as shown below.

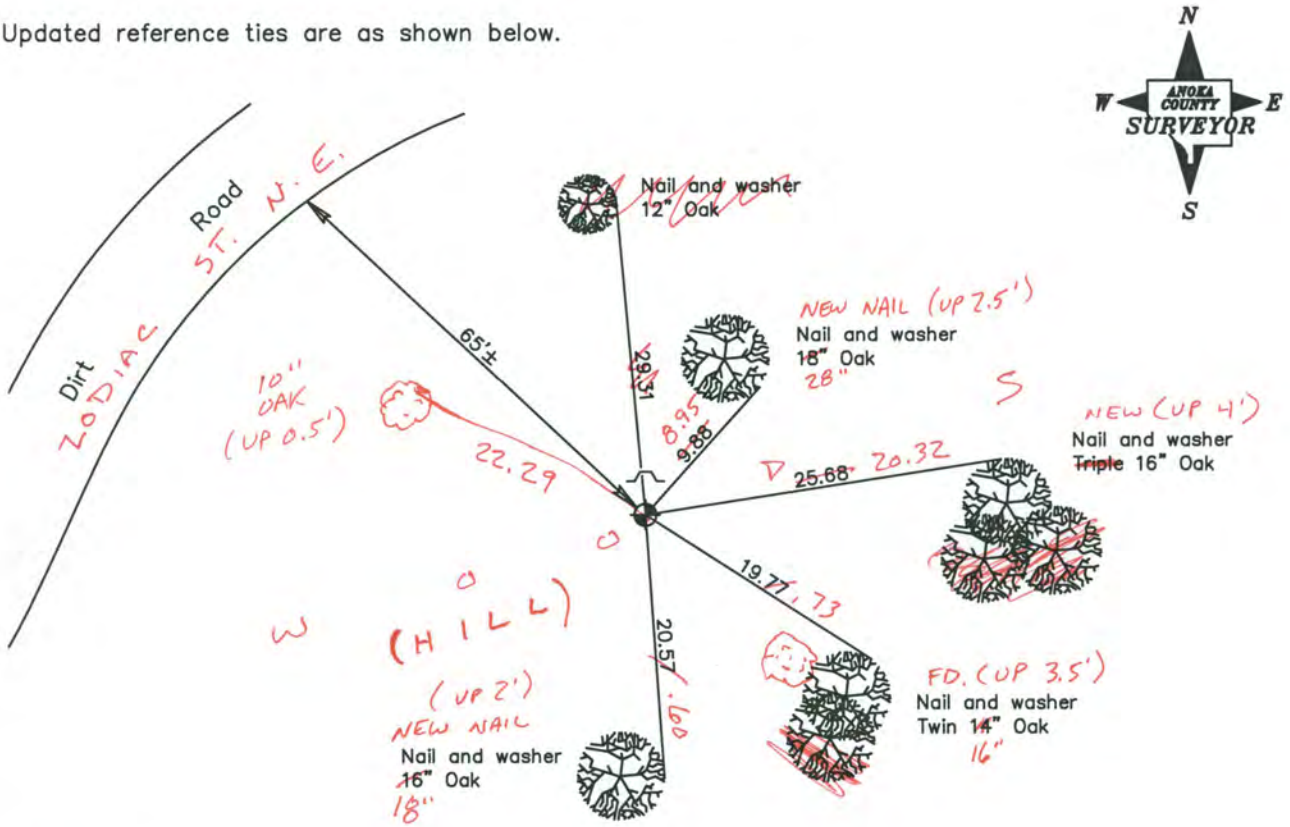

11-26-13
BK-55
TAPED

Revised date
10/18/90
6/28/93

N.A.D. 1983 Coordinates (1996 Adjustment)

County Project Coordinates	
Northing	219573.4179
Easting	542337.7215
Date	4/07/04

I hereby certify that this United States public land survey monument record is correct and complete to the best of my knowledge and belief.

_____ Date _____

_____, Anoka County Surveyor

Minnesota License Number _____

CERTIFICATE OF LOCATION OF GOVERNMENT CORNER

County of Anoka State of Minnesota

WEST QUARTER Corner of Sec. 9 Township 33 Range 22

I hereby certify that on the 28th day of DECEMBER, 19 61, I found the described corner which was evidenced by AREA RESURVEY

and I further certify that to perpetuate the location of said corner, I did, at the exact location thereof, place a permanent marker consisting of CAST IRON MONUMENT WITH SIGN AND POST ON NORTH SIDE.

which reference or witness monuments are located in the manner following:

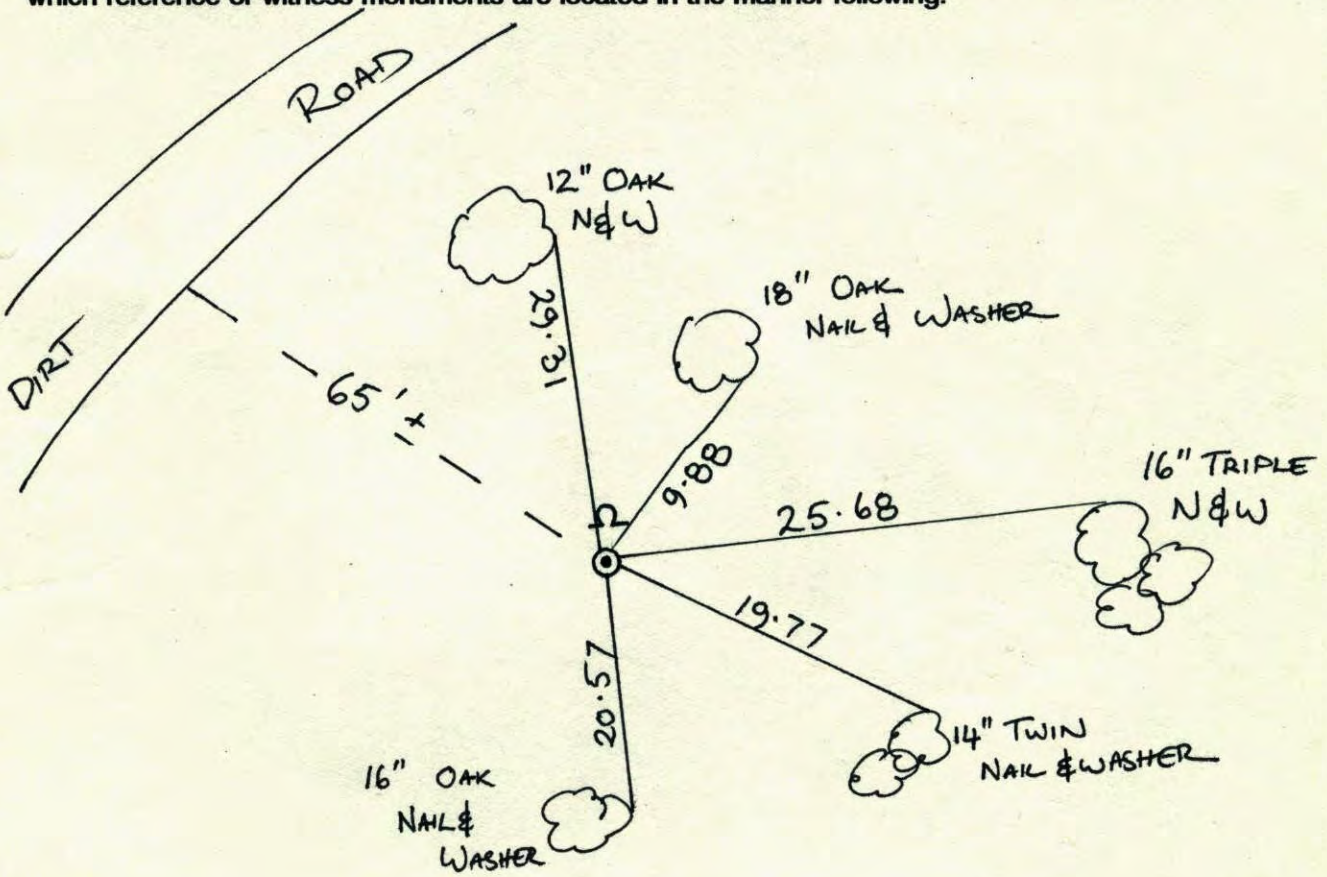

Revised date	Revised date	Revised date
10-18-90		
6-28-93		

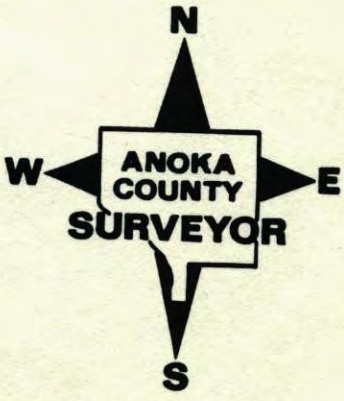

WEST ¼ COR SEC 9 T33 R 22

RETIE CAST IRON MONUMENT WITH SIGN & POST ON NTH SIDE.

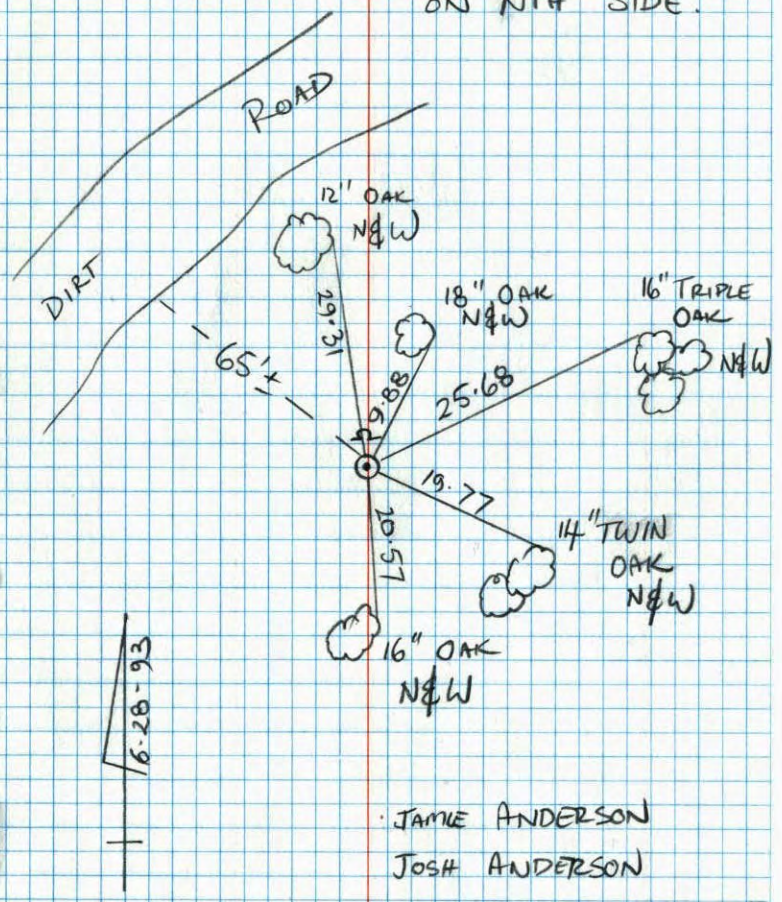

JAMIE ANDERSON
JOSH ANDERSON

NO. 448 TELEDYNE

W 1/4 Cor. Sec. 9 T33 R22

Set cast iron monument in place of A.R. spike C.I. flush
Warning Sign & Post 1' North

CONSTRUCTION TIES TAKEN 4-16-80 H. LARSON FOR POWERLINE

Tie Check July 6, 1971
R. Brien
J. Boettcher
B. Olson

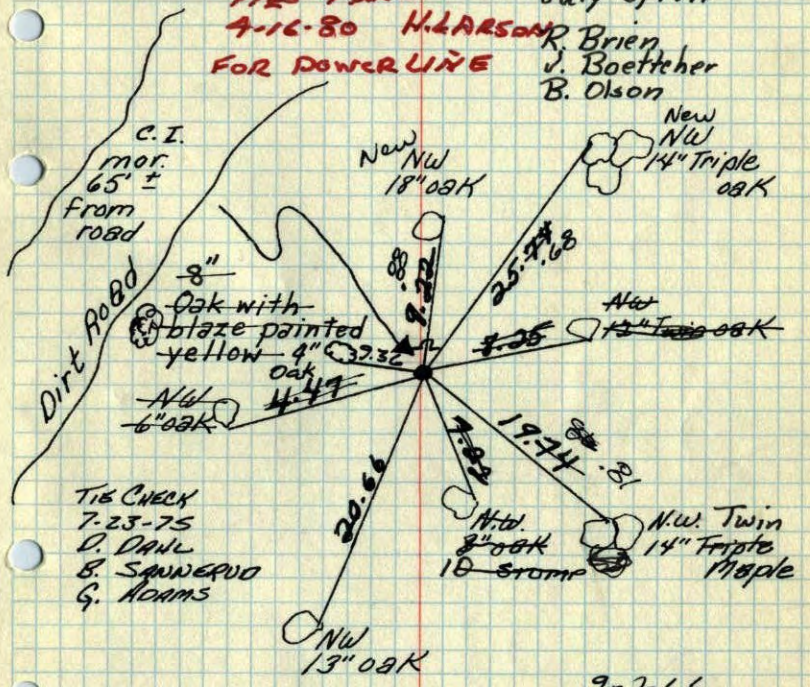

Tie Check
7-23-75
D. Dahl
B. Sawerud
G. Adams

Tie Check
June 28, 1967
D. Potter
D. Powell

Tie Check
D. Dahl
B. Stephens
7-21-78

9-2-66
Temp 76°
H. Larson
D. Porter

TIE CHECK
8-10-81
C. Ross
P. Hornby

TIE CHECK
August 29, 1984
D. Vogel
D. Ross
G. Lips

TEMPERATURE CORRECTED AND HORIZONTALLY TAPED MEASUREMENTS

ROLAND W. ANDERSON
COUNTY SURVEYOR
ANOKA COUNTY, MINNESOTA

X W PAGE 13 IN Tie Book ~~16~~

E 1/4 Cor. Sec. 9 T33 R22

Set cast iron monument in place of R.R. spike C.I. Flush

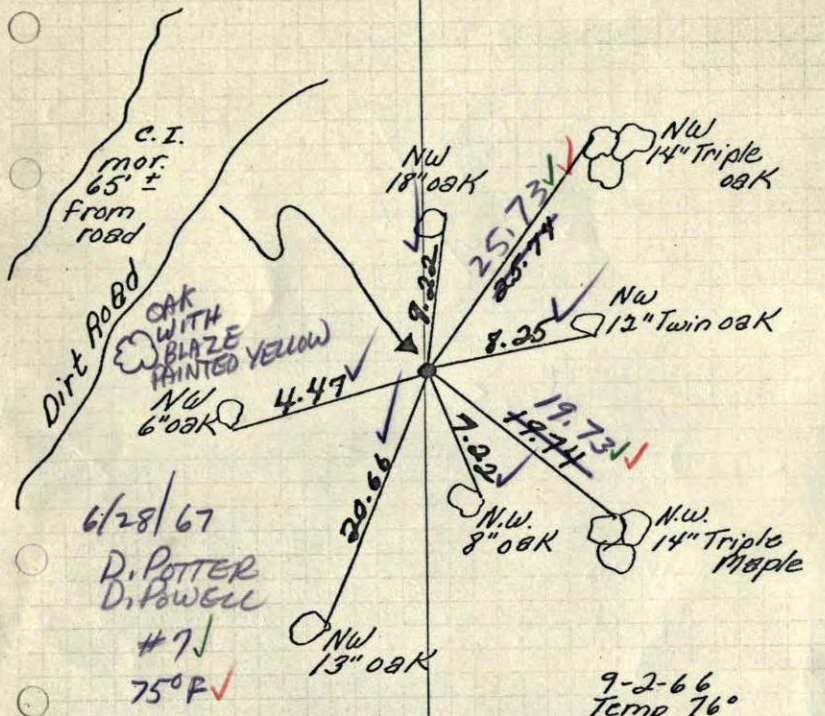

6/28/67
D. POTTER
D. POWELL
#7
75° F

9-2-66
Temp 76°
H. Larson
D. Porter

TEMPERATURE CORRECTED AND HORIZONTALLY TAPED MEASUREMENTS

ROLAND W. ANDERSON
COUNTY SURVEYOR
ANOKA COUNTY, MINNESOTA

13

W¼ Cor. Sec. 9-33-22

Set Cor. by doubling dist. & running bar from center through ¼ Cor. from East.

Set Cast Iron Mon.

Dec. 28, 1961

R.O. Freeman
M.D. Anderson

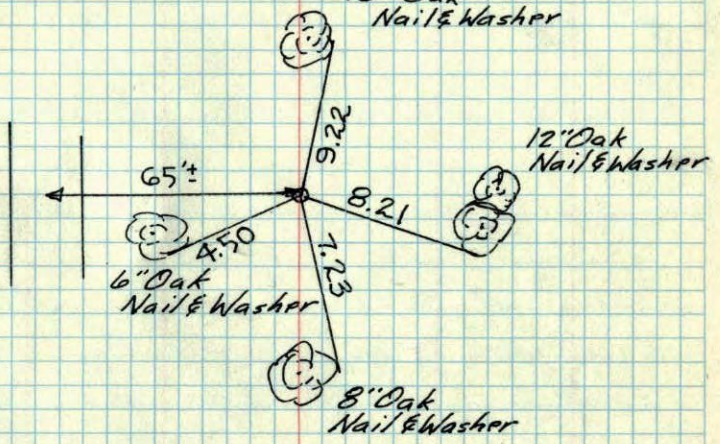

ROLAND W. ANDERSON
COUNTY SURVEYOR
ANOKA COUNTY, MINNESOTA

TEMPERATURE CORRECTED AND HORIZONTALLY TAPED MEASUREMENTS

28 Dec 1961
Freeman - Anderson
+10°

W¼ Cor Sec 9 · 33 · 22 Linwood
Set Cor by doubling dist. from Center thru ⅙ Cor.
Set Cast Iron Mon.

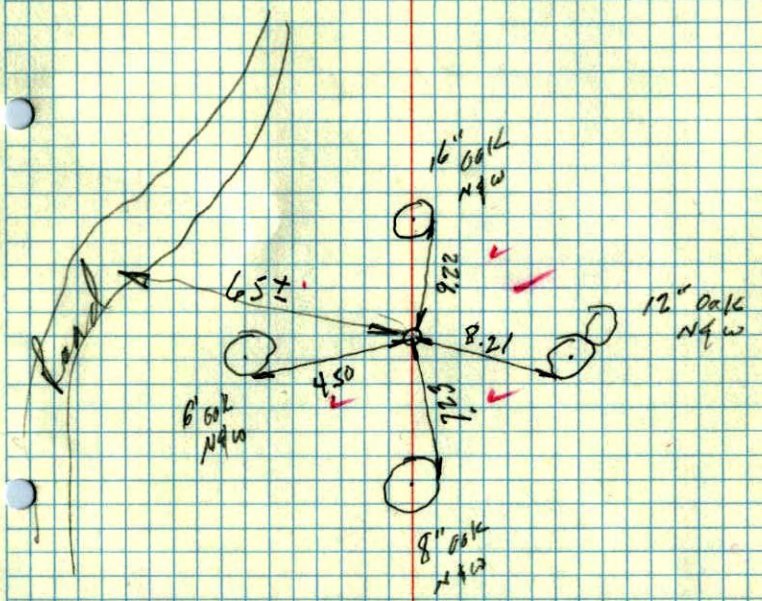

TEMP. CORR.
Ls. 40°