Center of Sec. 9-33-22

found piece of R.R. track up. 0.5'
May be Center of Sec. 9

VOID REFERENCE PT. ONLY

NOT TRUE CENTER

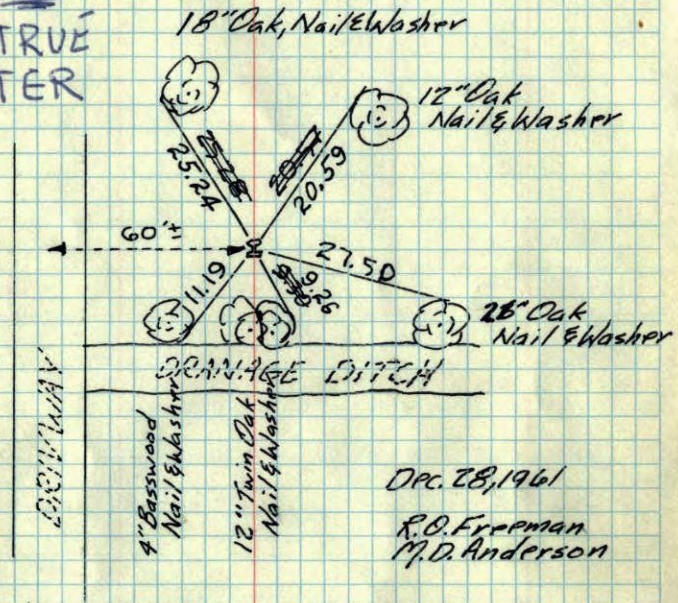

Dec. 28, 1961

R.O. Freeman
M.D. Anderson

Tie Check
July 9, 1971
R. Brien
J. Boettcher
B. Olson

Tie Check
June 28, 1967
D. Potter
D. Powell

ROLAND W. ANDERSON
COUNTY SURVEYOR
ANOKA COUNTY, MINNESOTA

TEMPERATURE CORRECTED
AND HORIZONTALLY
TAPED MEASUREMENTS

Center of Sec. 9-33-22

found piece of R.R. track up. 0.5'
May be Center of Sec. 9

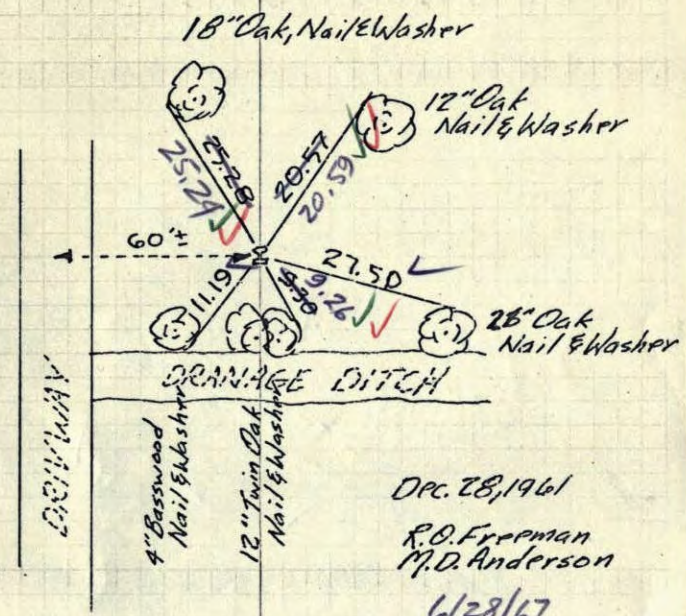

Dec. 28, 1961

R.O. Freeman
M.D. Anderson

6/28/67
D. POTTER
D. POWELL
#7
75°F

ROLAND W. ANDERSON
COUNTY SURVEYOR
ANOKA COUNTY, MINNESOTA

TEMPERATURE CORRECTED
AND HORIZONTALLY
TAPED MEASUREMENTS

28 Dec 1961
Freemon Anderson

+10°
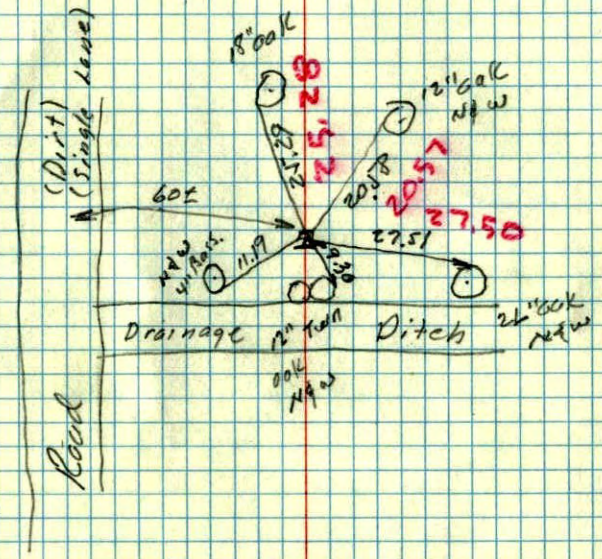
Center Sec 9-33-22 Linwood
Found piece of R.R. track up 0.5'