Page No. 43

CERTIFICATE OF LOCATION OF GOVERNMENT CORNER

County of Anoka State of Minnesota

East 1/4 Corner of Sec. 9 Township 33 Range 22

On the 25th day of January, 1972, the described corner was evidenced by area resurvey

and to perpetuate the location of said corner, at the exact location thereof, a permanent marker was placed consisting of a cast iron monument with a sign and post on the north side

AND on the ___ day of _____, ____, said permanent marker was _____

Updated reference ties are as shown below.

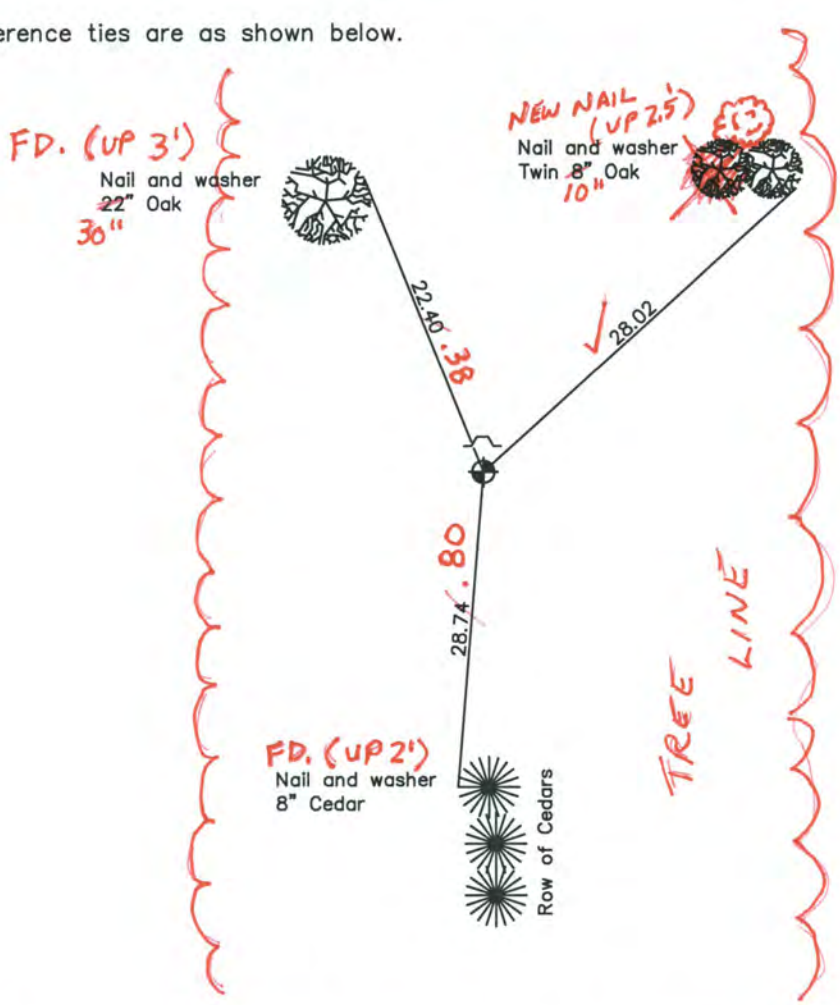

N
W ANOKA COUNTY SURVEYOR E
S

12-6-13
BK-55
TAPED

Revised date
12/26/90
6/28/93

N.A.D. 1983 Coordinates
(1996 Adjustment)

County Project Coordinates	
Northing	219366.9110
Easting	547688.8950
Date	4/08/04

I hereby certify that this United States public land survey monument record is correct and complete to the best of my knowledge and belief.

_____ Date _____

_____, Anoka County Surveyor

Minnesota License Number _____

CERTIFICATE OF LOCATION OF GOVERNMENT CORNER

County of Anoka State of Minnesota

EAST QUARTER Corner of Sec. 9 Township 33 Range 22

I hereby certify that on the 25 day of JANUARY, 19 72, I found the described corner which was evidenced by AREA RESURVEY

and I further certify that to perpetuate the location of said corner, I did, at the exact location thereof, place a permanent marker consisting of CAST IRON MONUMENT, SIGN AND POST ON NORTH SIDE

which reference or witness monuments are located in the manner following:

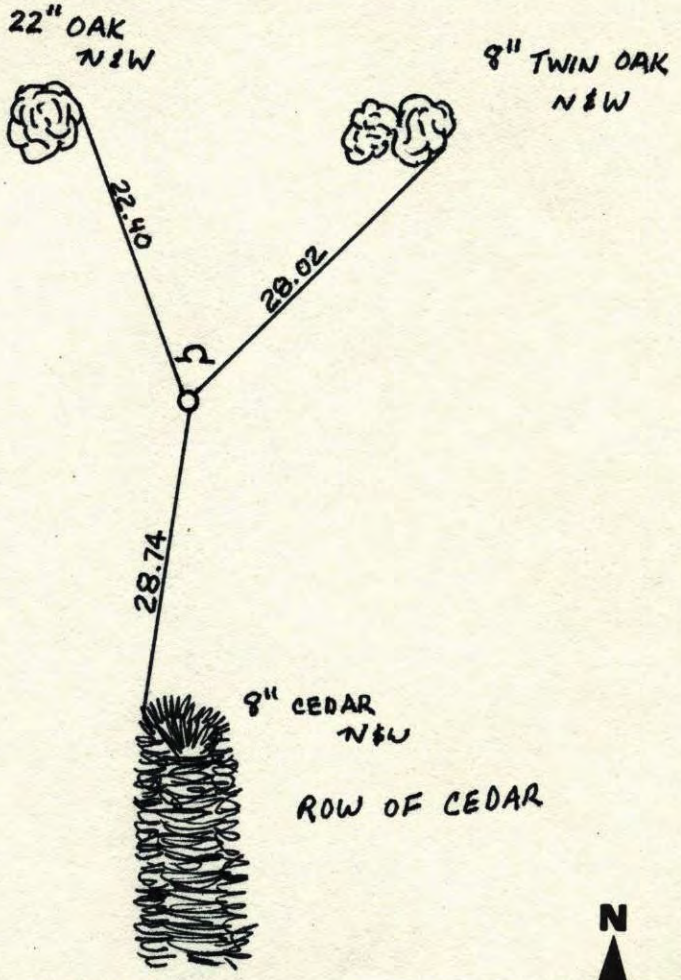

Revised date	Revised date	Revised date
12-26-90		
6-28-93		

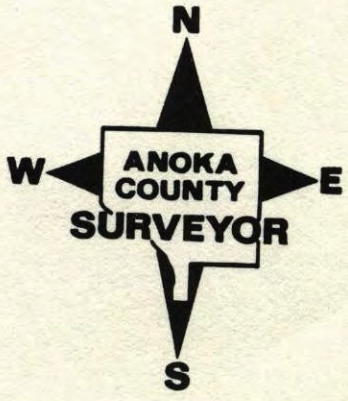

EAST QUARTER Corner S9 T33 R22

CAST IRON MONUMENT - TIE CHECK

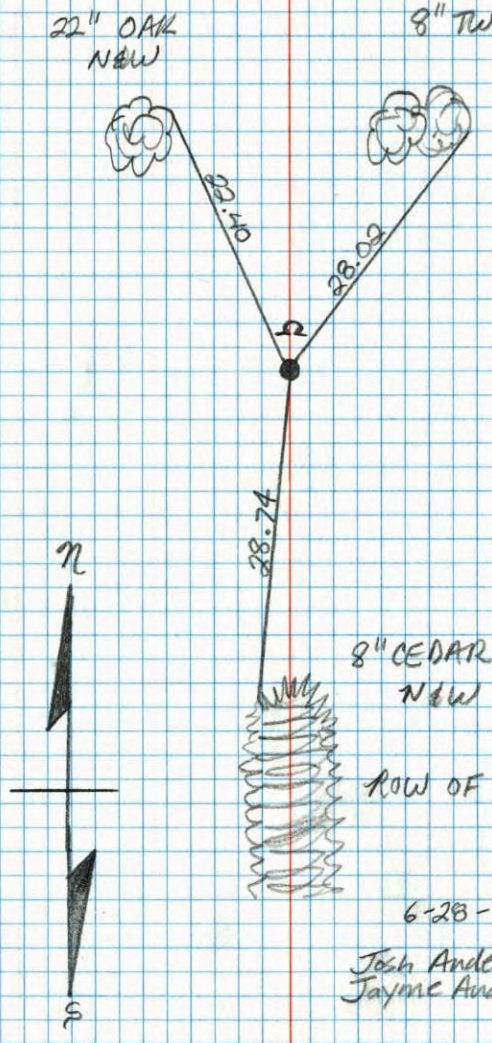

6-28-93
Josh Anderson
Jayme Anderson

NO. 448
TELEDYNE

E¼ Cor. Sec. 9-T33-R 22

Set Iron pipe (½") from area resurvey
Set steel sign post with warning sign
1'± North of Iron pipe

Cast Iron Mon. in place

Tie Check
7-23-75
O. Dahl
B. Sannerud
G. Adams

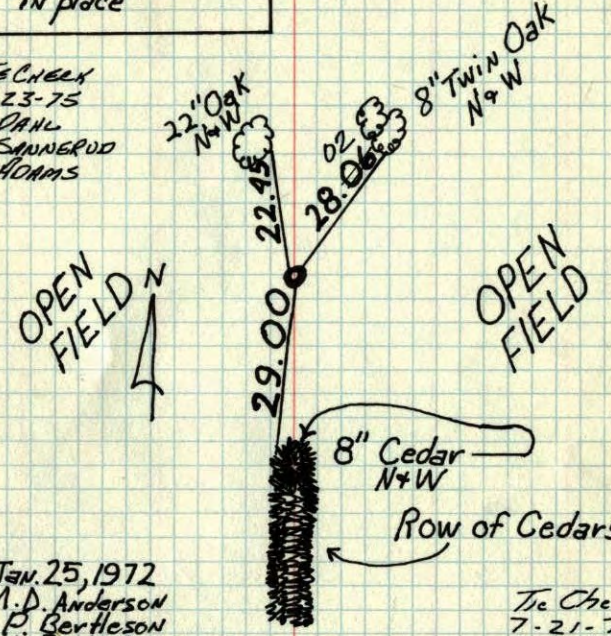

Jan. 25, 1972
M.D. Anderson
P. Bertleson
J. Boettcher
tape #13
temp 38°

Tie Check
7-21-78
D. Dahl
B. Stephens

TIE CHECK
8-17-81
P. ROSS
R. HORNBY
G. NEFFINGER

TEMPERATURE CORRECTED AND HORIZONTALLY TAPED MEASUREMENTS

ROLAND W. ANDERSON
COUNTY SURVEYOR
ANOKA COUNTY, MINNESOTA

E 1/4 Cor. Sec. 9-T33-R22

Set ~~iron pipe (4")~~ from area resurvey

Set steel sign post with warning sign 1' ± N. of iron pipe

Cast iron Mon. in place

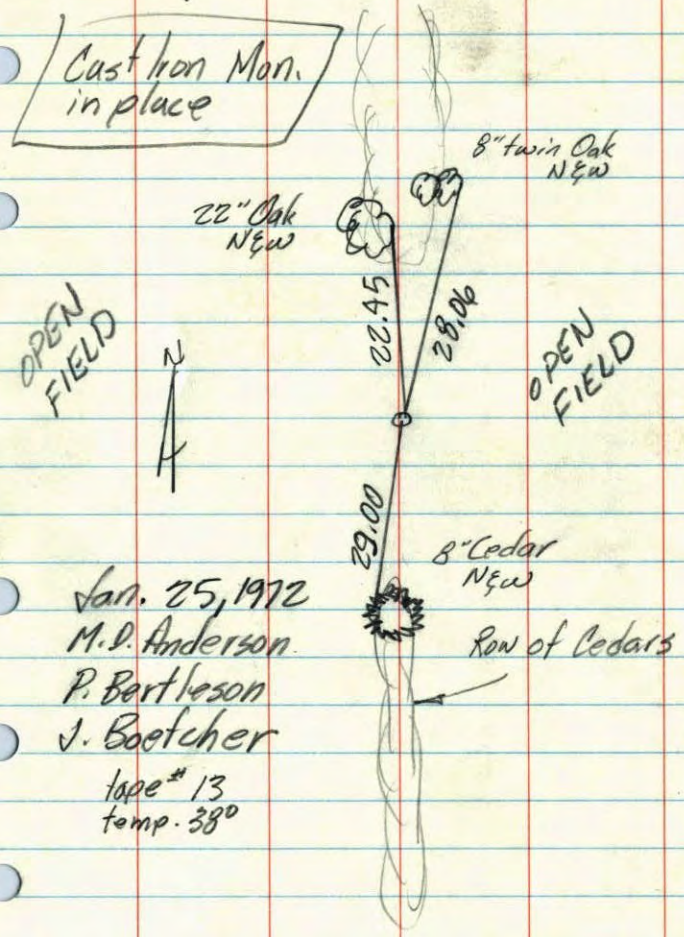

Jan. 25, 1972

M.D. Anderson

P. Bertleson

J. Boetcher

tape # 13

temp. 38°

E 1/4 Cor. Sec 9 T33 R22

Set cast iron monument in place of R.R. spike. C.I. Flush

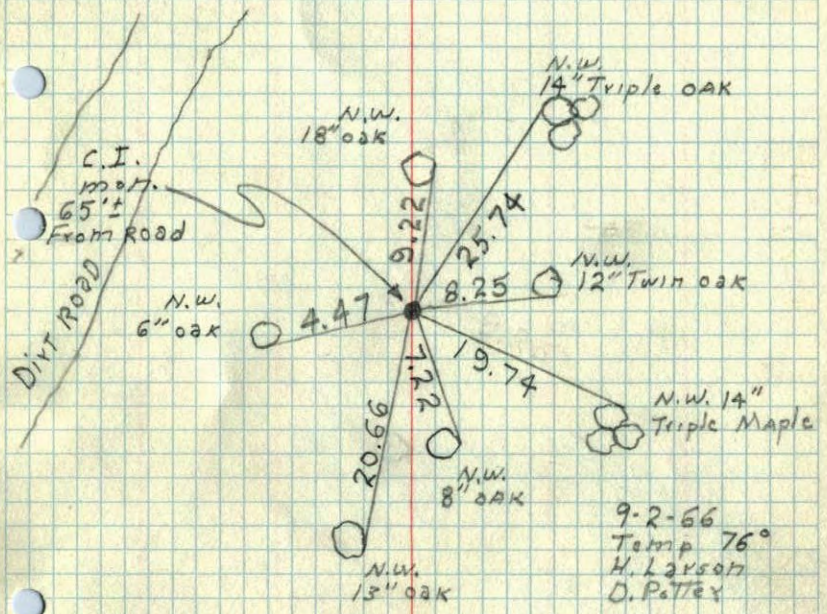

9-2-66

Temp 76°

H. Larson

D. Potter