Page No. 44

CERTIFICATE OF LOCATION OF GOVERNMENT CORNER

County of Anoka State of Minnesota

East 1/4 Corner of Sec. 10 Township 33 Range 22

On the 3rd day of July, 1974, the described corner was evidenced by area resurvey

and to perpetuate the location of said corner, at the exact location thereof, a permanent marker was placed consisting of a cast iron monument (MON. 2'± N. of ℄)

AND on the ___ day of _____, ____, said permanent marker was _____

Updated reference ties are as shown below.

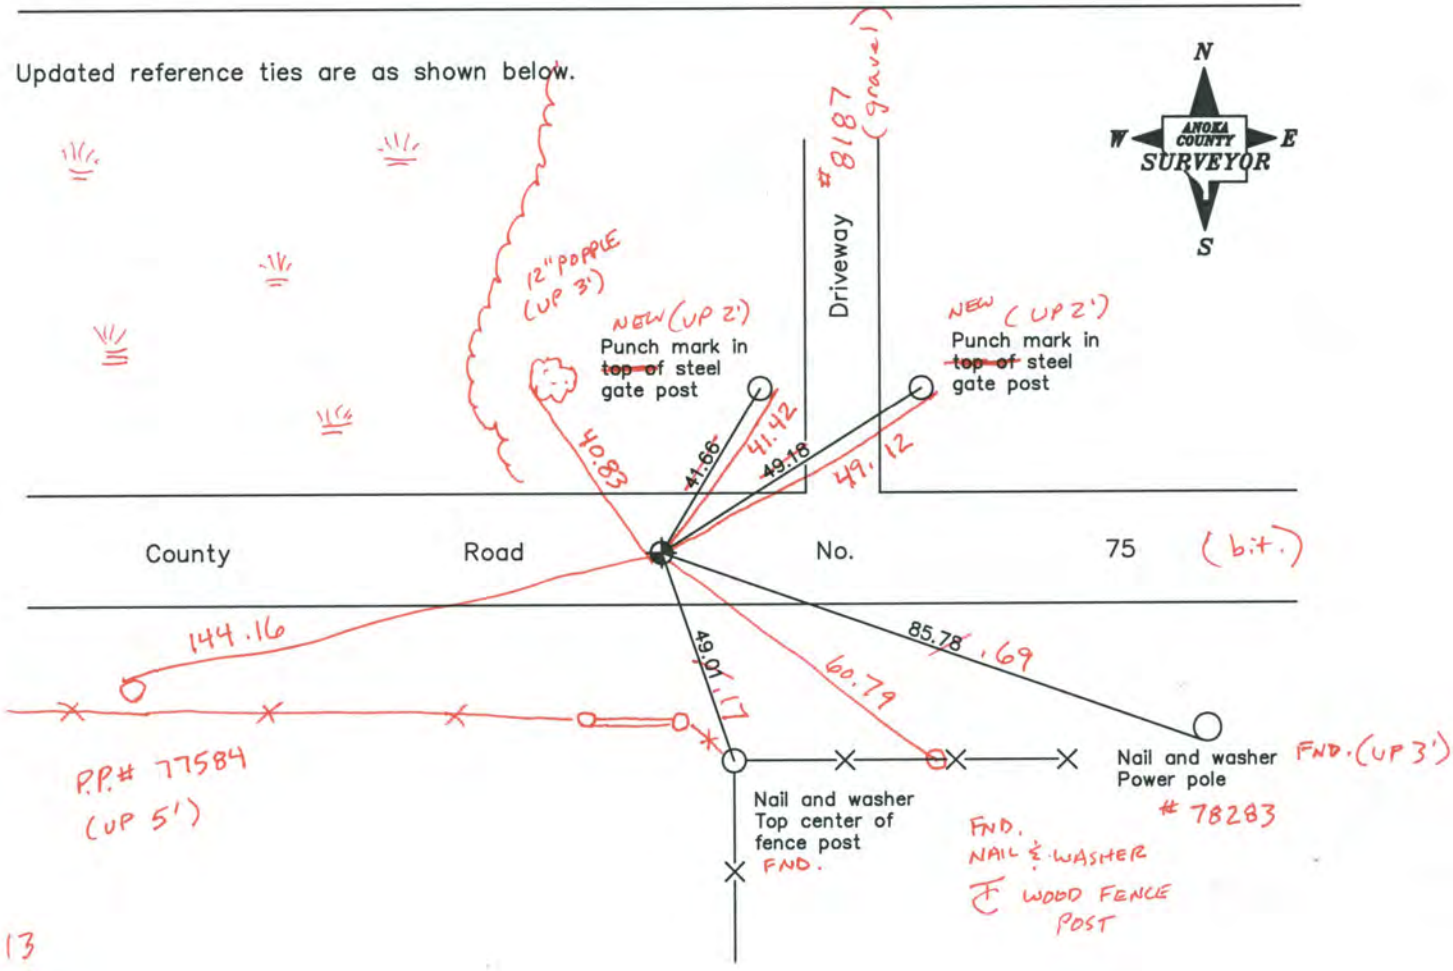

11-22-13
BK - SS
T/T - VRS

Revised date
12/26/90
6/14/93
6/03/99

N.A.D. 1983 Coordinates (1996 Adjustment)

County Project Coordinates	
Northing	219431.1657
Easting	553031.8884
Date	4/13/04

I hereby certify that this United States public land survey monument record is correct and complete to the best of my knowledge and belief.

_____ Date _____

_____, Anoka County Surveyor

Minnesota License Number _____

VRS 3DQ = 0.06 N = 219431.1314 E = 553031.8706

CERTIFICATE OF LOCATION OF GOVERNMENT CORNER

County of Anoka State of Minnesota

EAST 1/4 Corner of Sec. 10 Township 33 Range 22

I hereby certify that on the 3RD day of JULY, 19 74, I found the described corner which was evidenced by AREA RESURVEY

and I further certify that to perpetuate the location of said corner, I did, at the exact location thereof, place a permanent marker consisting of CAST IRON

which reference or witness monuments are located in the manner following:

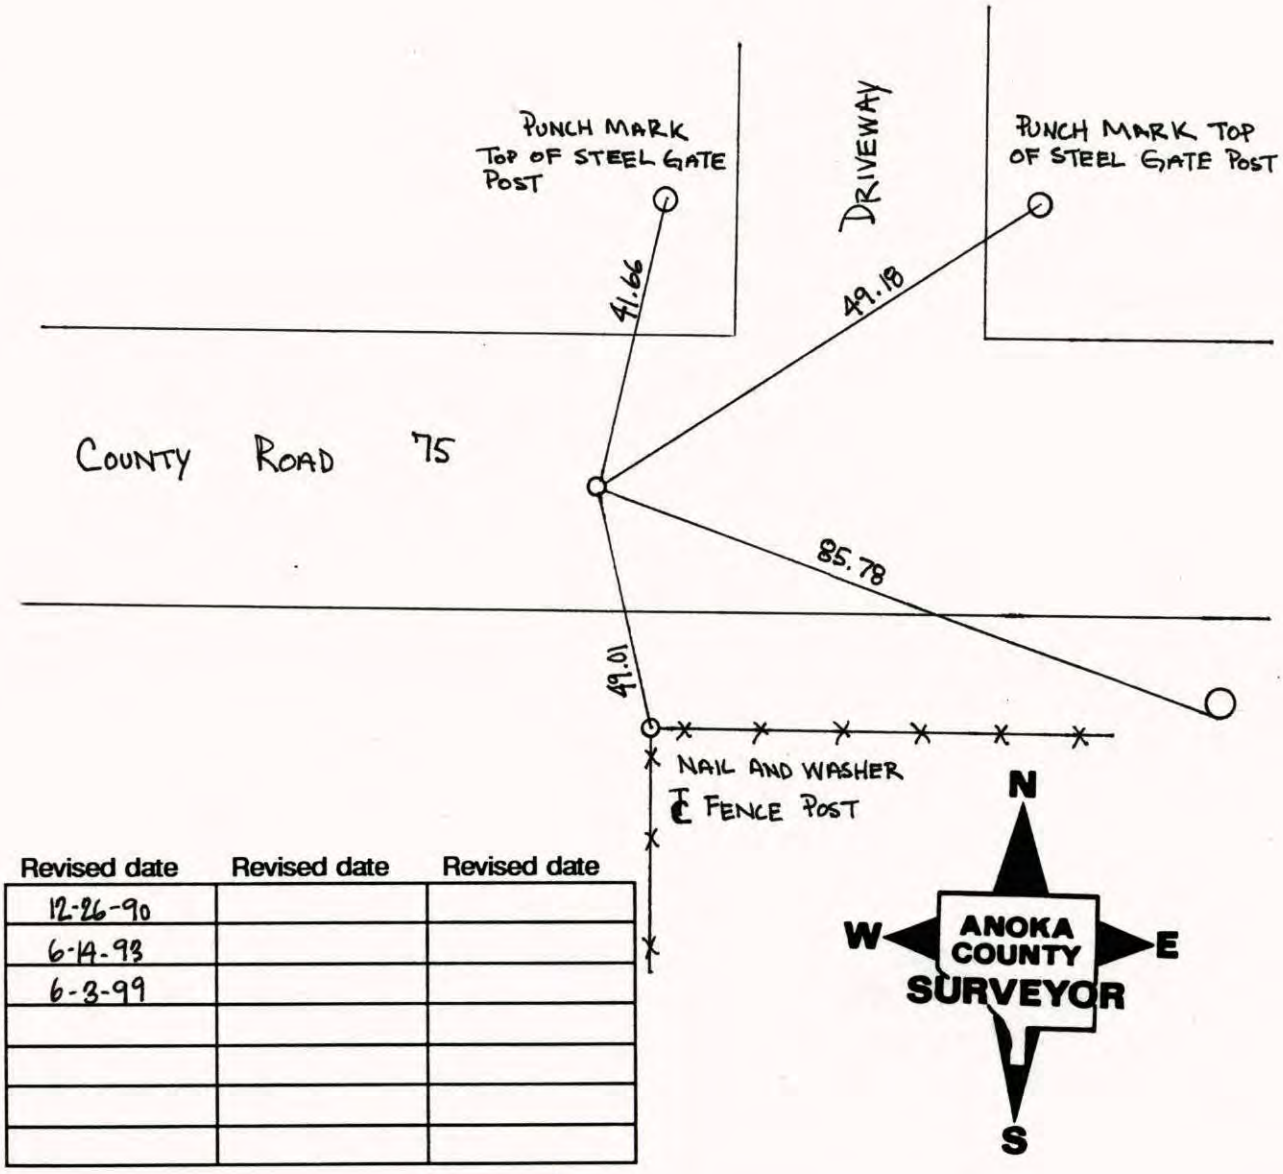

Revised date	Revised date	Revised date
12-26-90		
6-14-93		
6-3-99		

EAST 1/4 SEC. 10, T. 33, R. 22

RETIED AFTER MONUMENT WAS REPLACED DUE TO ROAD RECONSTRUCTION

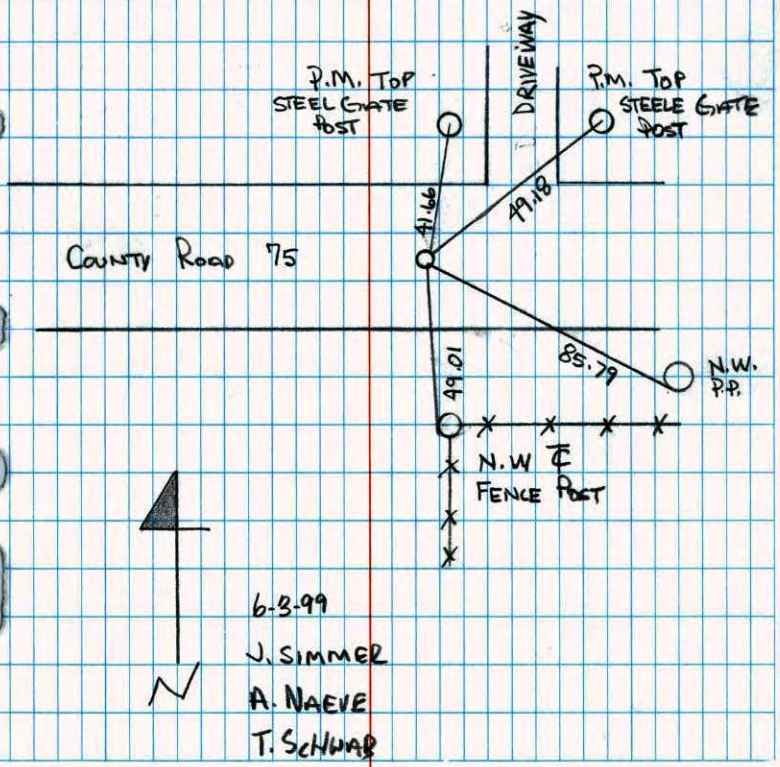

6-3-99
J. SIMMER
A. NAEVE
T. SCHWAB

TRANSIT TIE
E 1/4 COR SEC 10 T 33 R 22
REMOVED C.I.M. FOR GRIND & OVERLAY

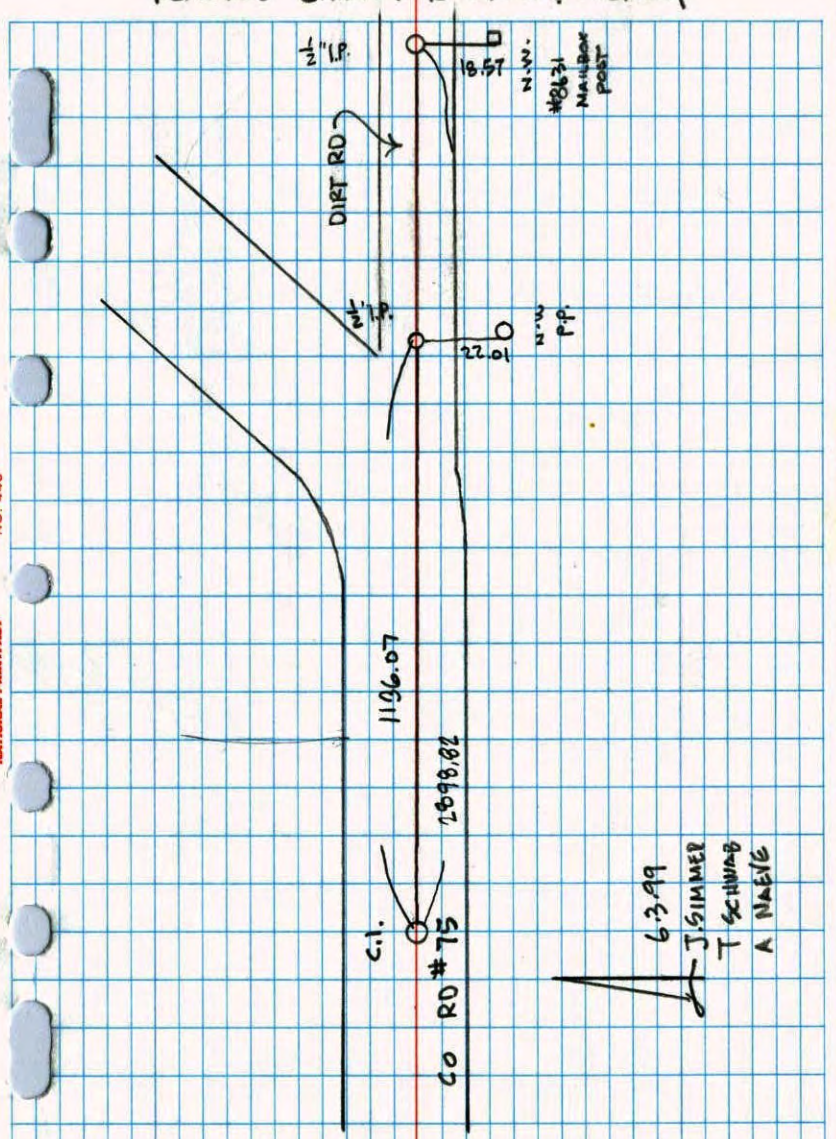

EAST QTR. Corner Sec. 10 T. 33 R. 22

RETIED CAST IRON MONUMENT, CHECKED TIES

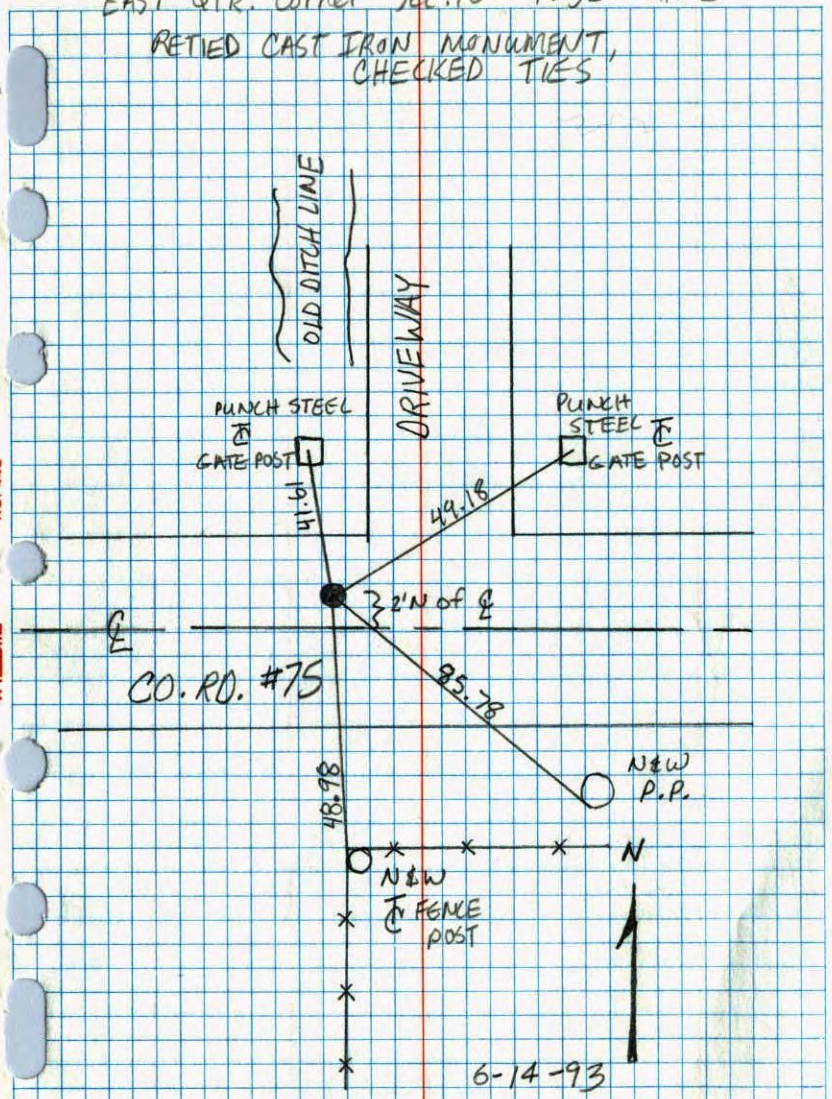

6-14-93

JOSH ANDERSON
JAYME ANDERSON

E 1/4 CORNER SECTION 10-T33-R22

SET CAST IRON MONUMENT FLUSH FROM AREA RESURVEY.
PK's 2.00' NORTH & EAST.

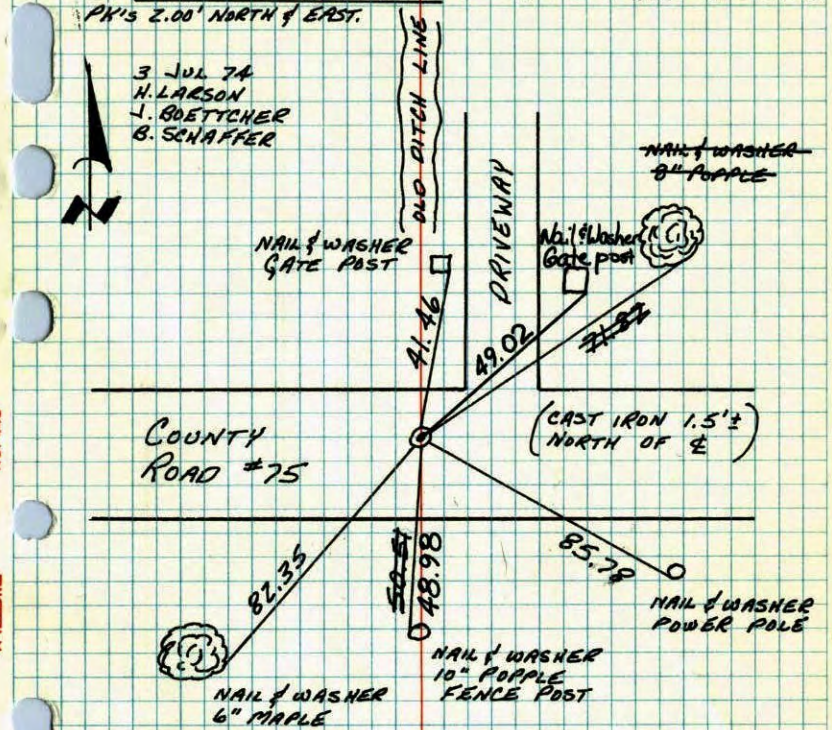

TIE CHECK
23 JUL 75
O. OAHL
B. SANNERUD
G. ADAMS

TIE CHECK
8-N-81
A. ROSS
P. NORNBY
G. NEFFINGER

TIE CHECK
21 JUL 78
O. OAHL
B. STEPHENS

TieCheck
August 28, 1984
G. Lips
D. Ross
D. Vogel

TEMPERATURE CORRECTED AND HORIZONTALLY TAPED MEASUREMENTS

ROLAND W. ANDERSON
COUNTY SURVEYOR
ANOKA COUNTY, MINNESOTA

E¼ Cor. Sec. 10 T33, R22
Cast Iron Mon. flush
Pk's 2'00 North & East

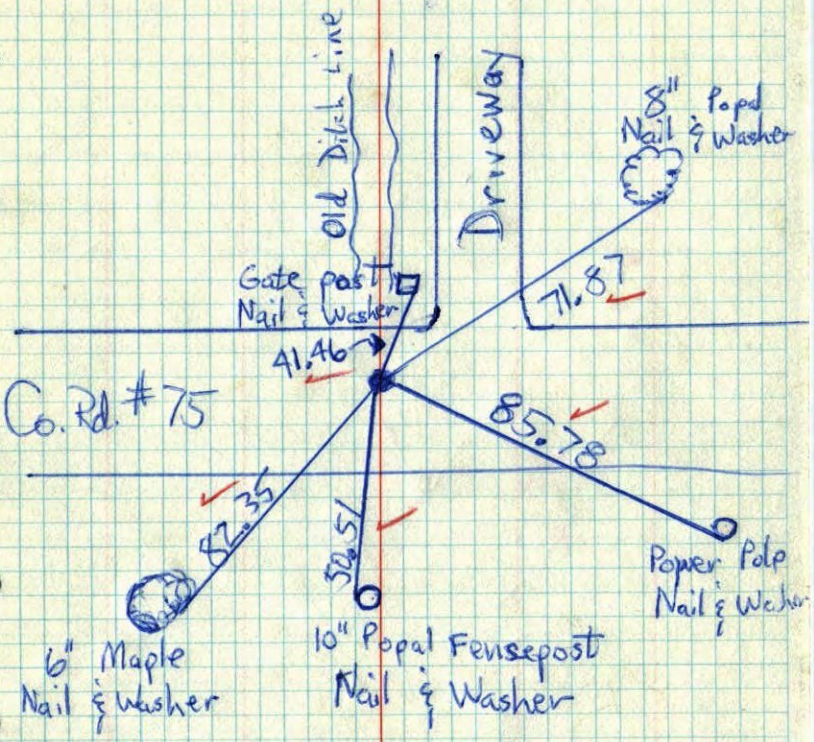

Tie Check
7-21-78
D. Dahl
B. Stephens
#2 74°

E¼ Cor. Sec. 10 - T33 - R22
Set Cast Iron Monument From Area Resurvey P.K.'s 2.00' N. & E.

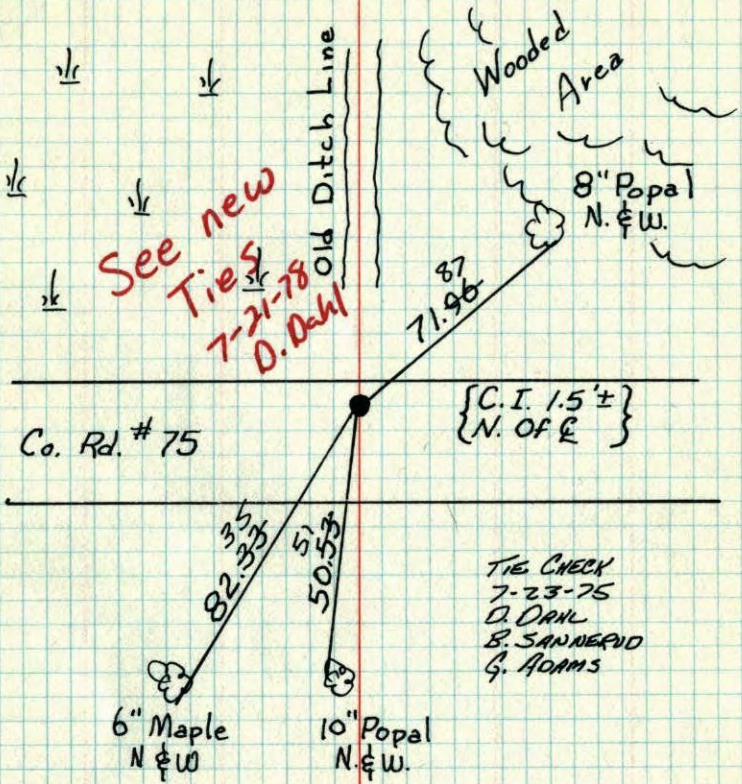

Tie Check
7-23-75
D. Dahl
B. Sannerud
G. Adams

7-3-1974
H. Larson
J. Boettcher
B. Schaffer
Temp. 80°
Tape #14

ROLAND W. ANDERSON
COUNTY SURVEYOR
ANOKA COUNTY, MINNESOTA

TEMPERATURE CORRECTED AND HORIZONTALLY TAPED MEASUREMENTS

E¼ Cor. Sec. 10 T33 R22
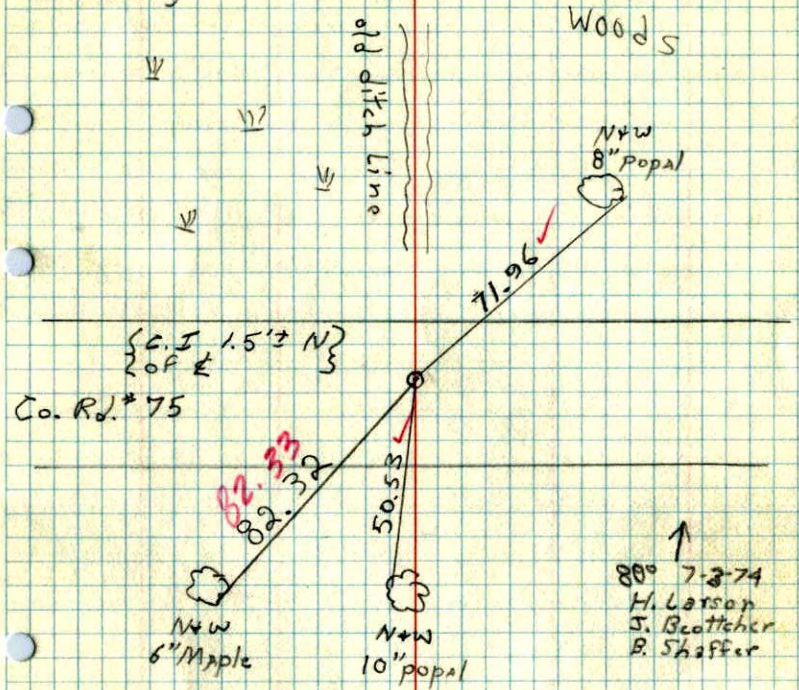
Set cast iron monument from area re survey. P.K. 52.00' N. + E.