

CERTIFICATE OF LOCATION OF GOVERNMENT CORNER

County of Anoka

State of Minnesota


Meander Corner of Sec. 9 Township 33 Range 22
 (MC #21 on south line of SW 1/4)

On the 27th day of August, 1964, the described corner was evidenced by a 6" X 6" granite monument

and to perpetuate the location of said corner, at the exact location thereof, a permanent marker was placed consisting of the same granite monument with a sign and post on the north side

AND on the ___ day of _____, _____, said permanent marker was _____

Updated reference ties are as shown below.

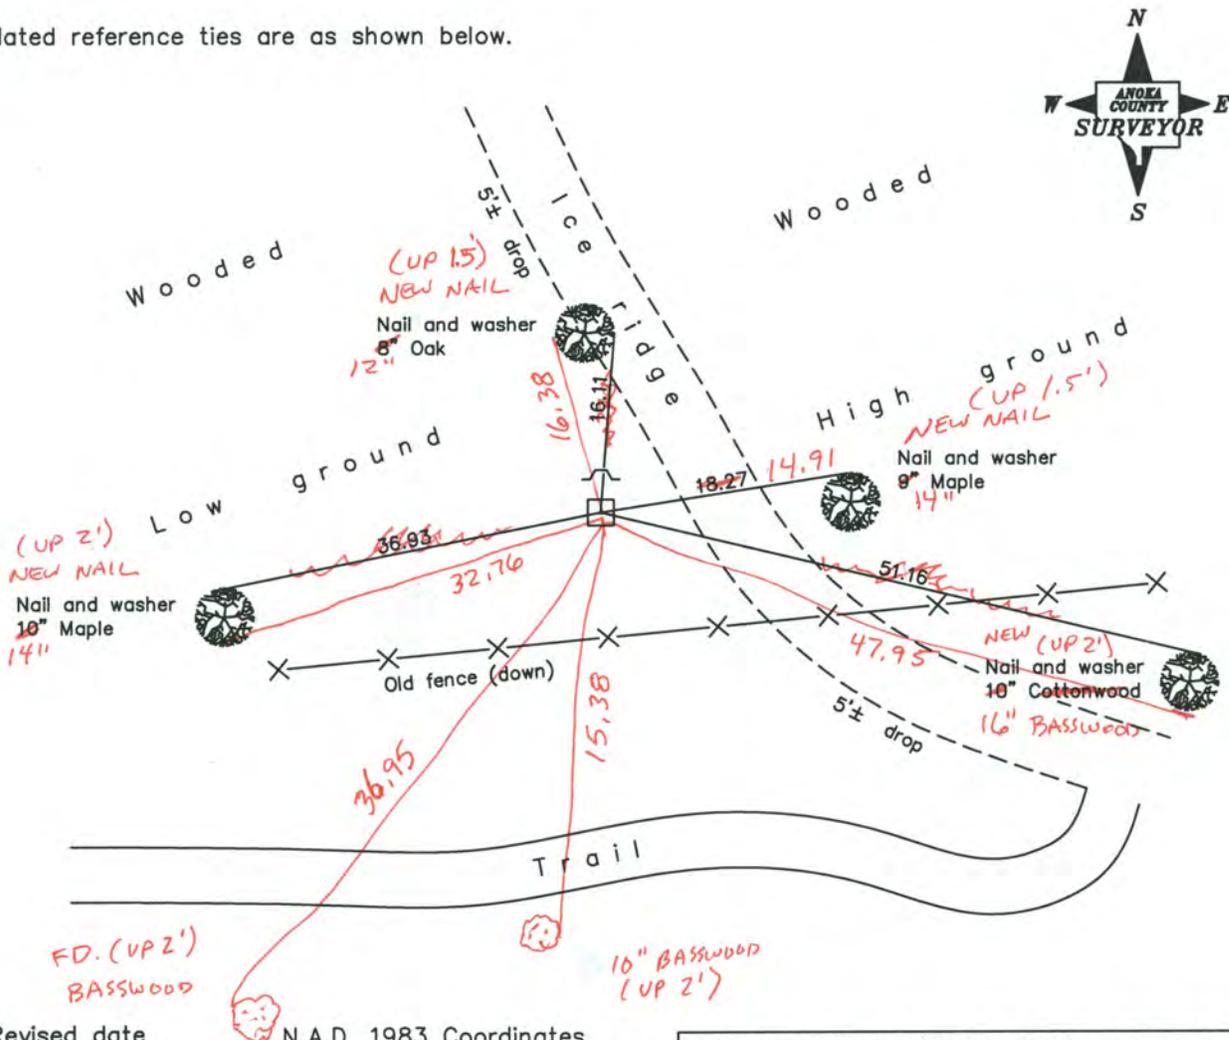

11-27-13
BK-SS
TAPED

Revised date
10/18/90
6/24/93

N.A.D. 1983 Coordinates (1996 Adjustment)
County Project Coordinates
Northing <u>216795.7761</u>
Easting <u>544681.8552</u>
Date <u>5/12/04</u>

I hereby certify that this United States public land survey monument record is correct and complete to the best of my knowledge and belief.

_____ Date _____

_____, Anoka County Surveyor

Minnesota License Number _____

CERTIFICATE OF LOCATION OF GOVERNMENT CORNER


County of Anoka State of Minnesota

M.C. #21 SOUTH Corner of Sec. 9 Township 33 Range 22
 LINE OF S.W. QTR.


I hereby certify that on the 27 day of AUGUST, 1964, I found the described corner which was evidenced by 6" x 6" GRANITE

and I further certify that to perpetuate the location of said corner, I did, at the exact location thereof, place a permanent marker consisting of SAME, SIGN AND POST, NORTH SIDE

which reference or witness monuments are located in the manner following:

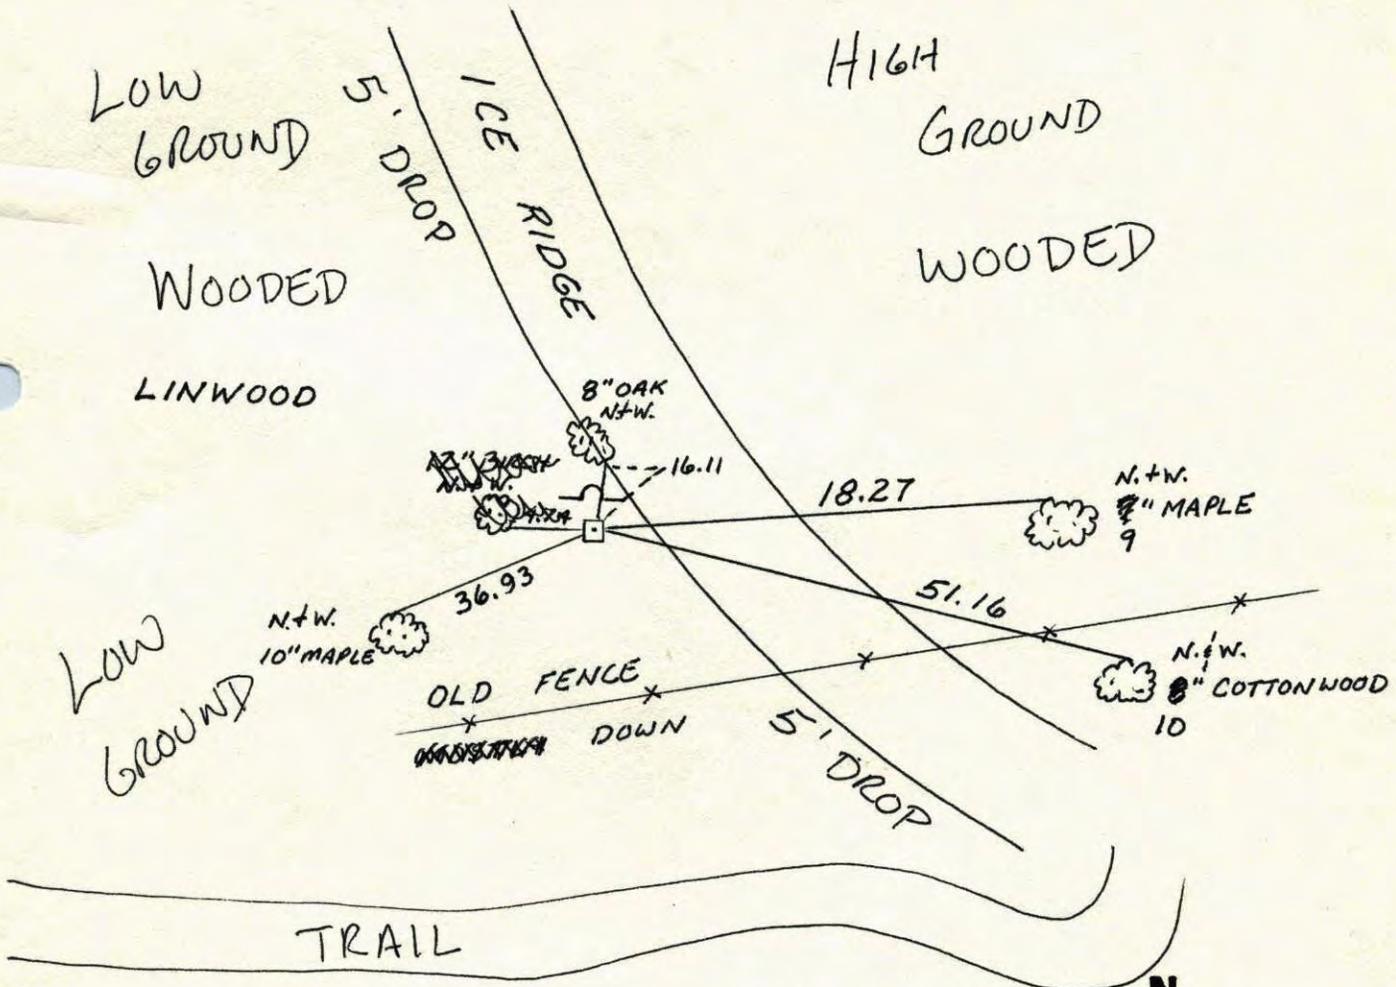

Revised date	Revised date	Revised date
10-18-90		
6-24-93		

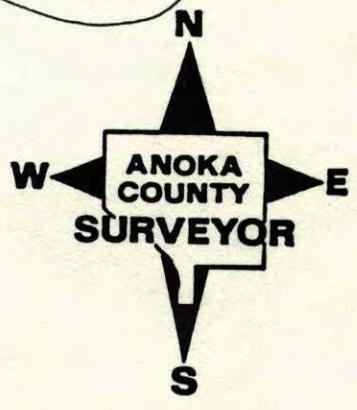

M.C. #21 on S. line Sec. 9-T33-R22
on E. side of Linwood Lake

6"x6" Granite monument up 0.4'
on west edge of ice ridge
Warning Post & Sign 1 1/2 North

Tie Check

7-24-75

D. Dahl
R. SANMERO
G. ADAMS


Aug. 27, 1964

M.D. Anderson
J. Dunlap

Tie Check

7-24-78

D. Dahl
B. Stephens
D. Nagjak

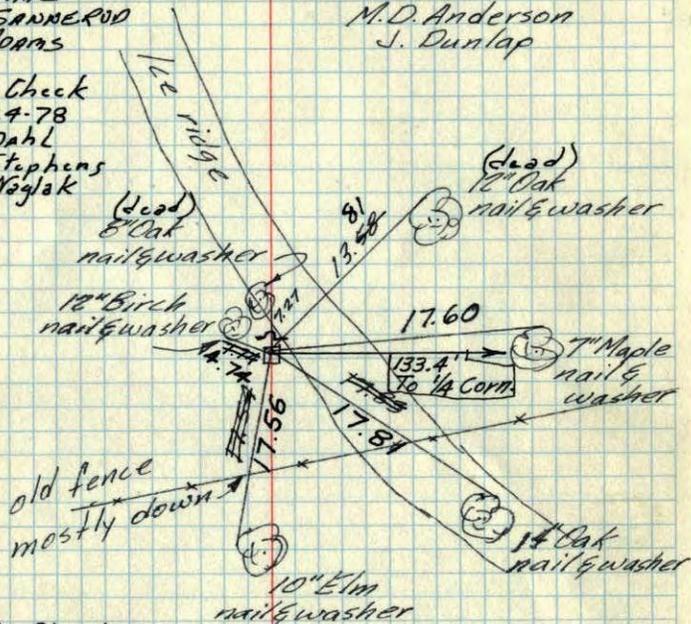

Tie Check
July 11, 1967
D. Potter
D. Powell

Tie Check
July 9, 1971
R. Brien
J. Boettcher
B. Olson

TIE CHECK
8-26-81
P. ROSS
P. HORNBY

ROLAND W. ANDERSON
COUNTY SURVEYOR
ANOKA COUNTY, MINNESOTA

TEMPERATURE CORRECTED
AND HORIZONTALLY
TAPED MEASUREMENTS

M.C. #21 on S. line Sec. 9-T33-R22
on E. side of Linwood Lake

6"x6" Granite monument up 0.4'
on west edge of ice ridge


7/11/67

D. POTTER
D. POWELL

#7-76°F ✓

Aug. 27, 1964


M.D. Anderson
J. Dunlap

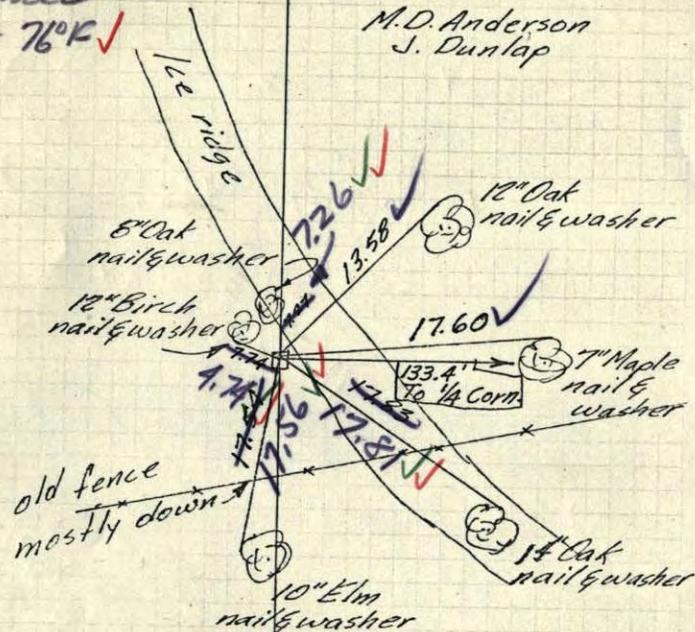

ROLAND W. ANDERSON
COUNTY SURVEYOR
ANOKA COUNTY, MINNESOTA

TEMPERATURE CORRECTED
AND HORIZONTALLY
TAPED MEASUREMENTS

M.C. #21 on So. line of Sec. 9-33-22
 On E. side of Linwood lake
 6" x 6" Granite Monument up 0.4' ±
 on West edge of Ice ridge

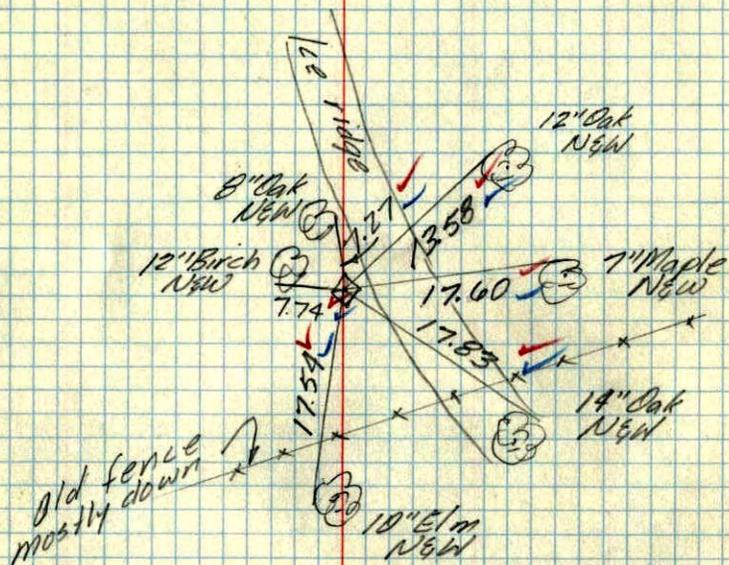


Aug. 27, 1969
 M.D. Anderson
 J. Dunlap
 Temp. 69°
 Tape #1

Ties To M.C. 21 - So. Line Sec. 9-33-22
 Found 6" x 6" Granite Mon. 4" above ground.
 Tied to B.T.'s - Nail in Blazed trees
 Note: Measured 133.4' W. from S. 1/4 Cor. Sec. 9
 to M.C. 21

Date: - Nov. 30, 1955

- E.A. Westman -

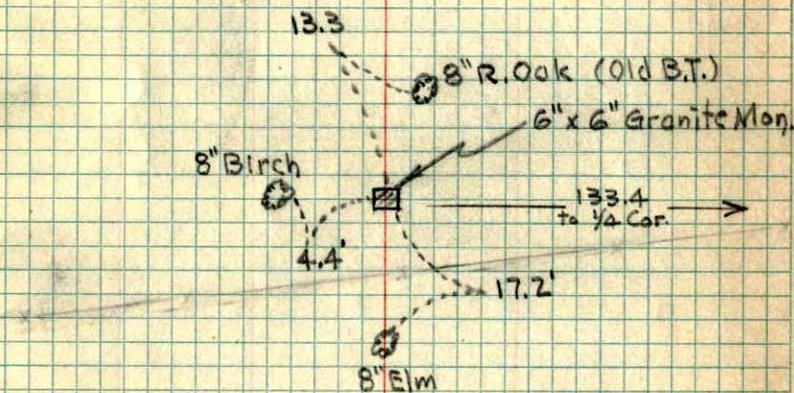

8" Birch - W. 4.4'
 8" Elm - S. 17.2'
 8" Red Oak - N.N.E. 13.3'