CERTIFICATE OF LOCATION OF GOVERNMENT CORNER

County of Anoka State of Minnesota

Southwest Corner of Sec. 8 Township 33 Range 22

On the 24th day of March, 1961, the described corner was evidenced by a 1" iron pipe

and to perpetuate the location of said corner, at the exact location thereof, a permanent marker was placed consisting of a cast iron monument

AND on the 4th day of June, 2003, said permanent marker was found, the ties were updated and P.K.'s were set 2.00' north and east

Updated reference ties are as shown below.

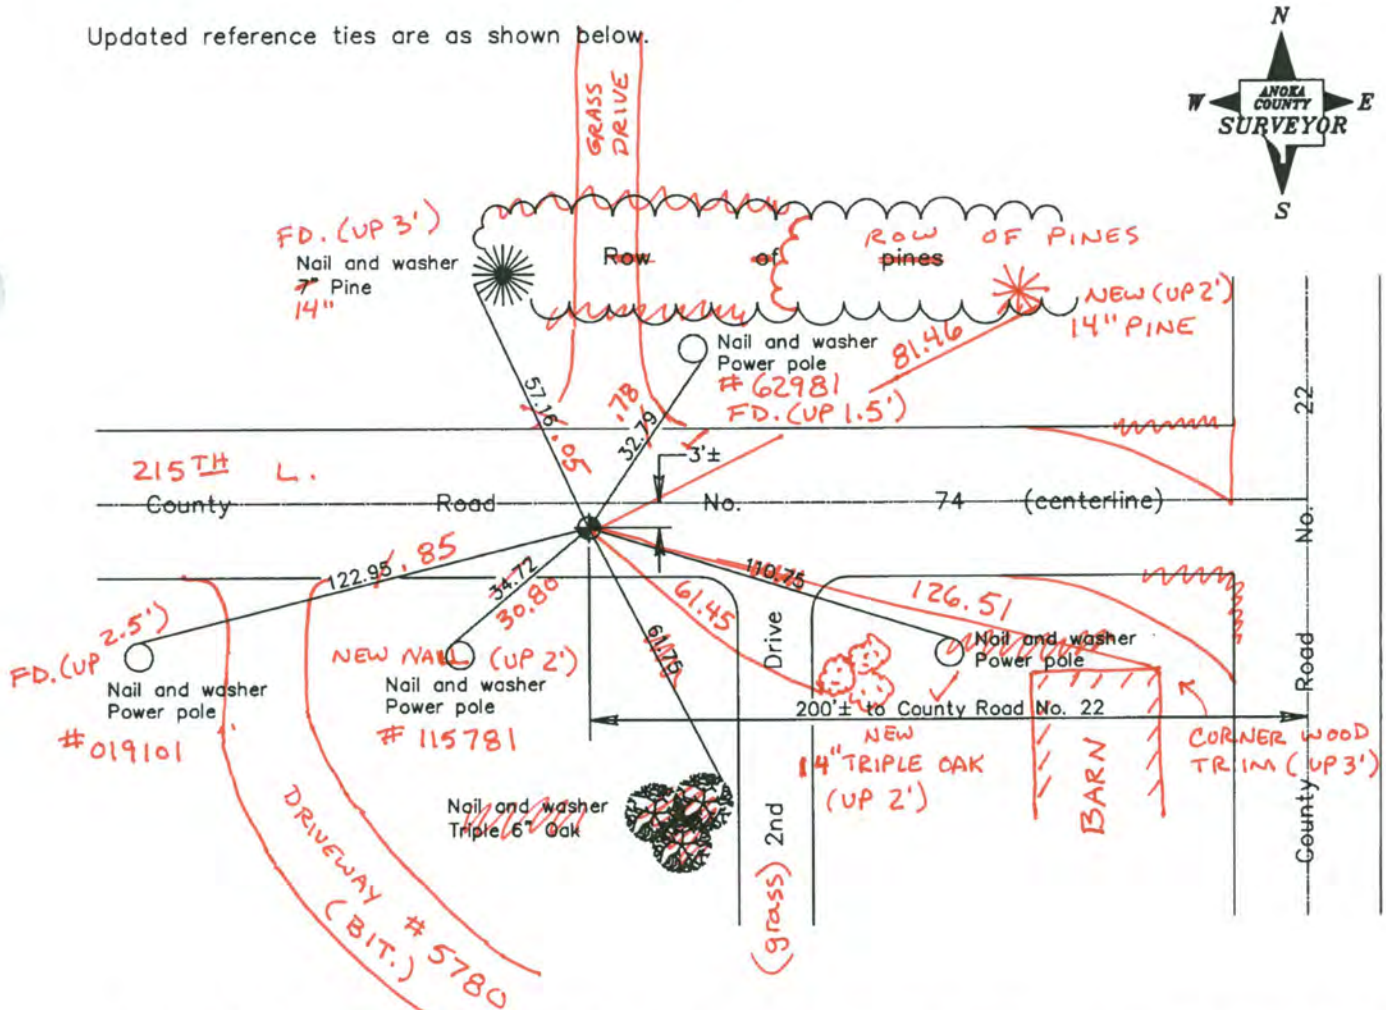

Revised date
11/09/87
6/16/93
6/04/03
11-18-13
BK-55

T/T

N.A.D. 1983 Coordinates
(1996 Adjustment)

County Project Coordinates	
Northing	216707.5096
Easting	536890.1398
Date	6/09/03

I hereby certify that this United States public land survey monument record is correct and complete to the best of my knowledge and belief.

Date 6/04/03

Larry D. Hoium, Anoka County Surveyor

Minnesota License Number 18165

CERTIFICATE OF LOCATION OF GOVERNMENT CORNER

County of Anoka State of Minnesota

SOUTHWEST Corner of Sec. 8 Township 33 Range 22

I hereby certify that on the 24 day of MARCH, 1961, I found the described corner which was evidenced by 1" IRON PIPE

and I further certify that to perpetuate the location of said corner, I did, at the exact location thereof, place a permanent marker consisting of CAST IRON MON.

which reference or witness monuments are located in the manner following:

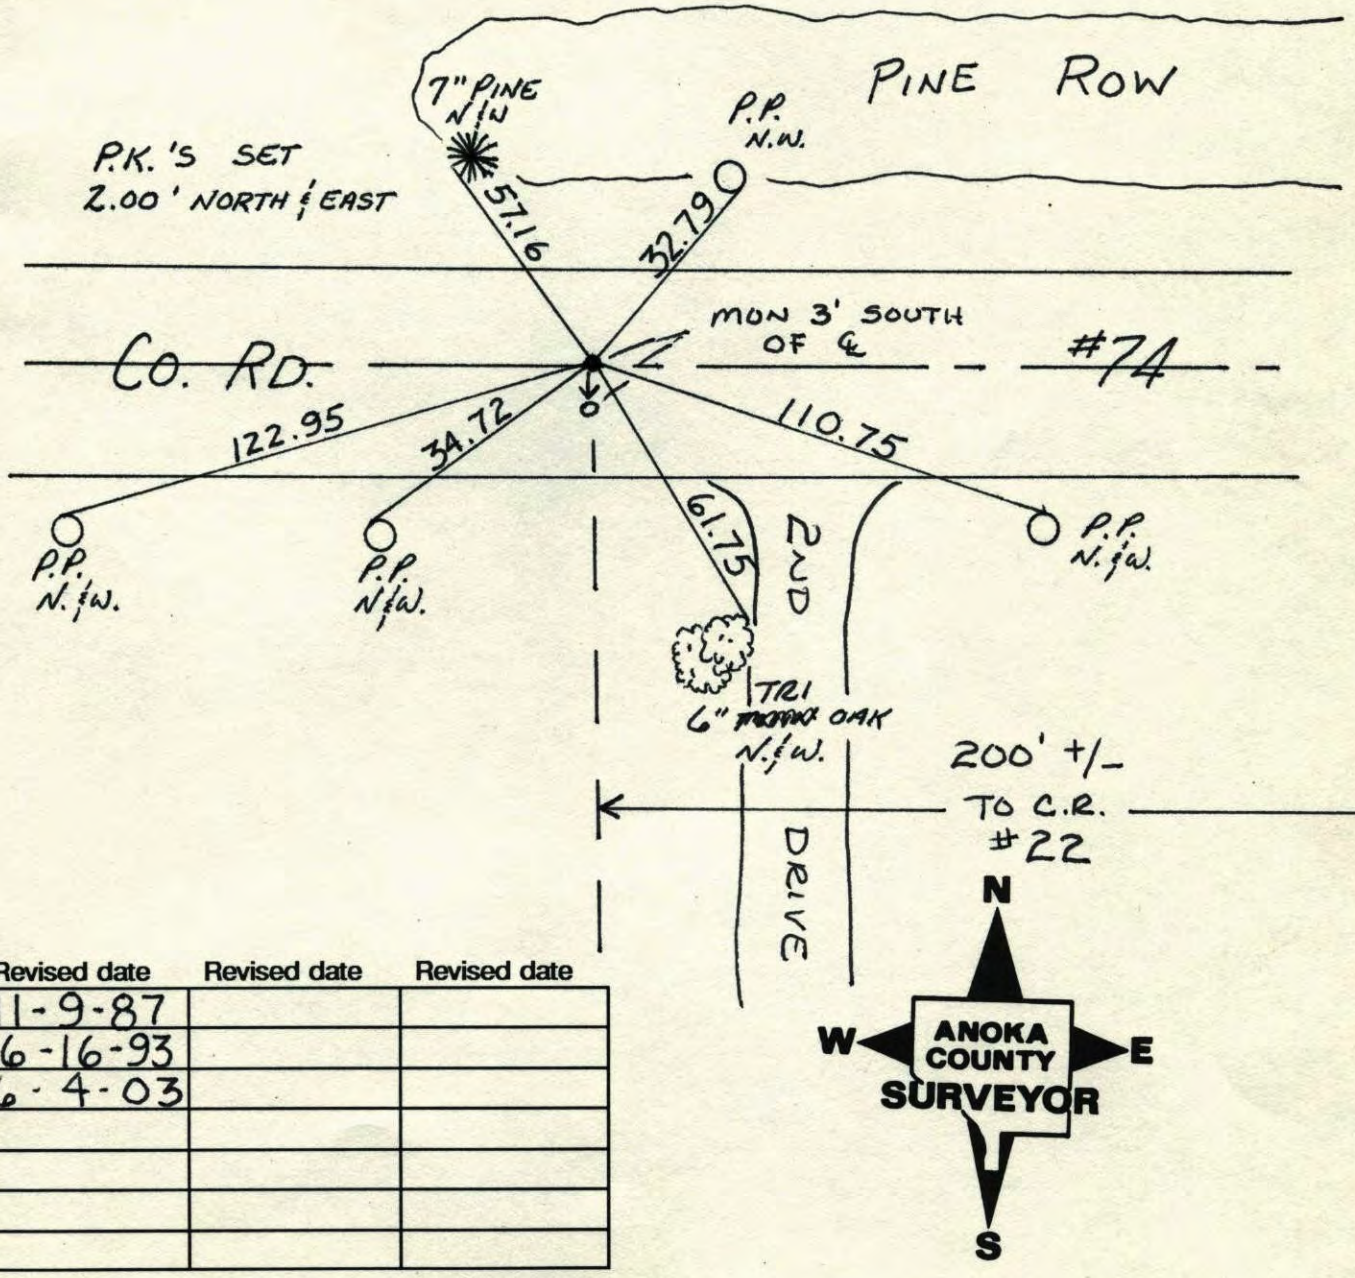

Revised date	Revised date	Revised date
11-9-87		
6-16-93		
6-4-03		

SW COR. SECTION 8 T33 R22

RETIED CAST IRON

6-16-93
MA
MSA

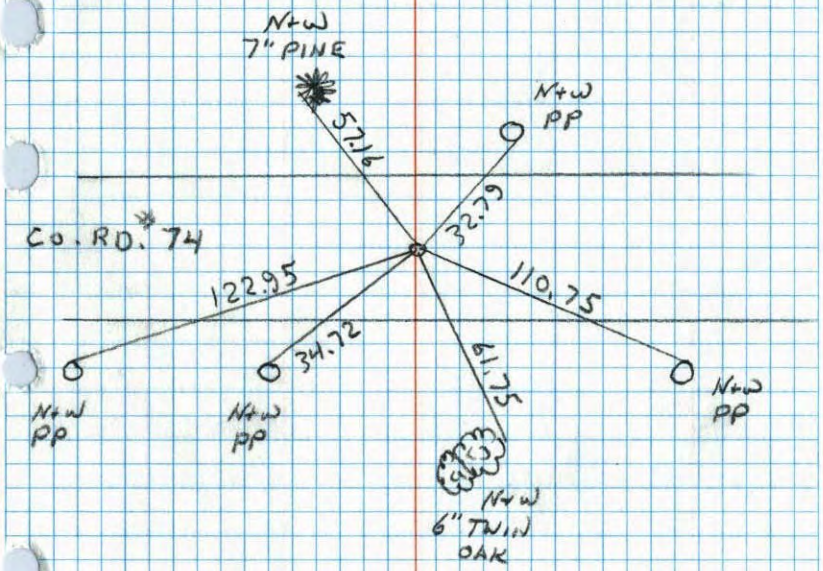

NO. 448

TELEDYNE

Redraw

8-24-84 58

S.W. Cor. Sec. 8-T33-R22

Set Cast Iron Monument flush
Set PK's 2.00' N & E

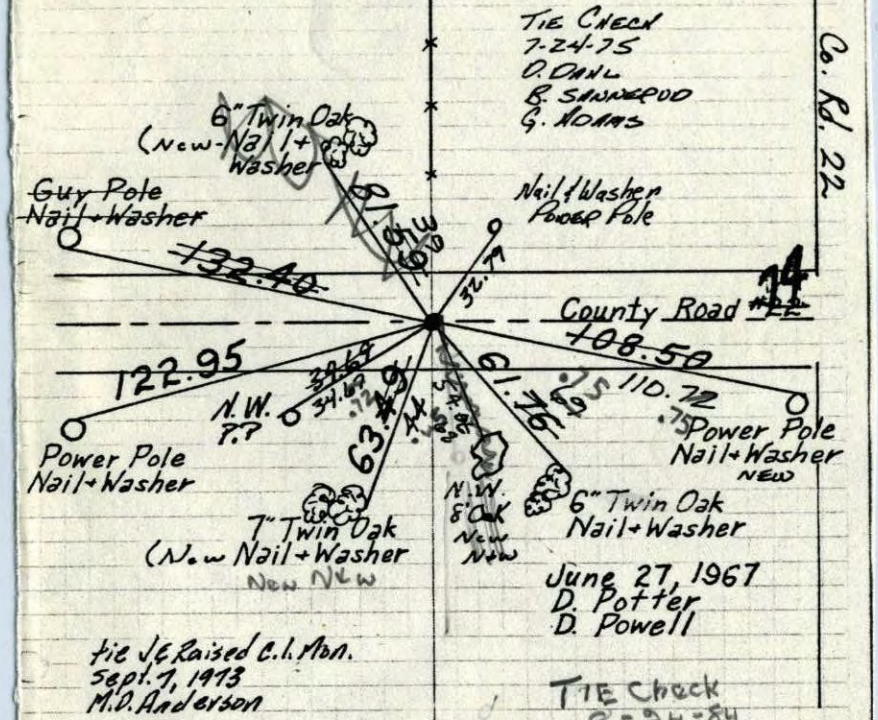

June 27, 1967
D. Potter
D. Powell

tie to Raised C.I. Mon.
Sept. 7, 1973
M.D. Anderson

TIE Check
8-24-84
D. Vogel
D. Ryss
G. Lips #800

Tie Check
7-24-78
D. Dahl
B. Stephens
D. Naglak

TIE CHECK
8-5-81
P. ROSS
P. HORNBY
G. NEFFINGER

1" Iron
3-24-61
Freeman

TEMPERATURE CORRECTED AND HORIZONTALLY TAPED MEASUREMENTS

ROLAND W. ANDERSON
COUNTY SURVEYOR
ANOKA COUNTY, MINNESOTA

S.W. Cor. Sec. 8-T33-R22

Set Cast Iron Monument flush
Set PK's 2.00' N & E.

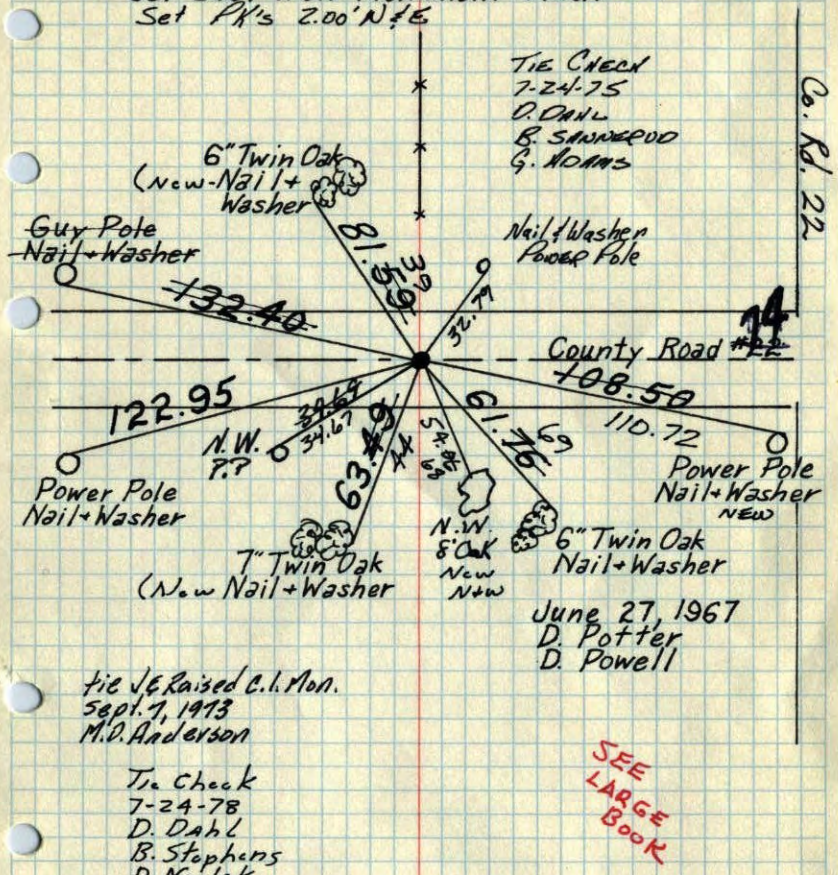

tie J & Raised C.L. Mon.
Sept. 7, 1973
M.O. Anderson

Tie Check
7-24-78
D. Dahl
B. Stephens
D. Naglak

TIE CHECK
8-5-81
P. ROSS
F. HORNBY
G. NEFFINGER

SEE LARGE BOOK

TEMPERATURE CORRECTED AND HORIZONTALLY TAPED MEASUREMENTS

ROLAND W. ANDERSON
COUNTY SURVEYOR
ANOKA COUNTY, MINNESOTA

SW Cor Sec 8-T33-R22

Cast Iron Mon flush
RK. Spikes 2.00' N & E.

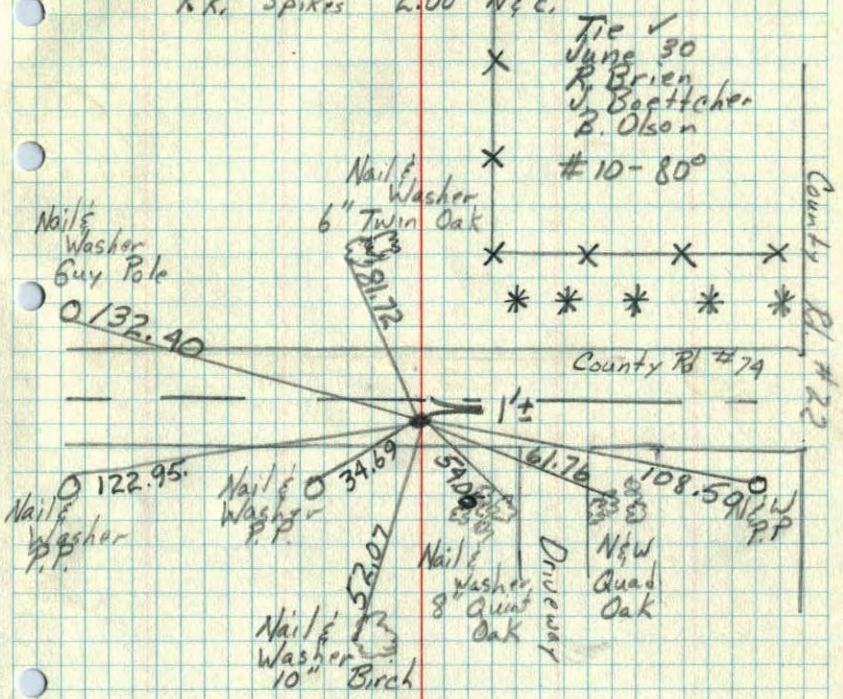

S.W. Cor. Sec 8-33-22 Linwood
1" Iron down 1.0' in ℄ Road. (C. #22)
Set C.I. IN PLACE

3-24-61
Freeman
Anderson
6/27/67
D. Potter
J. Powell
#7
82°F

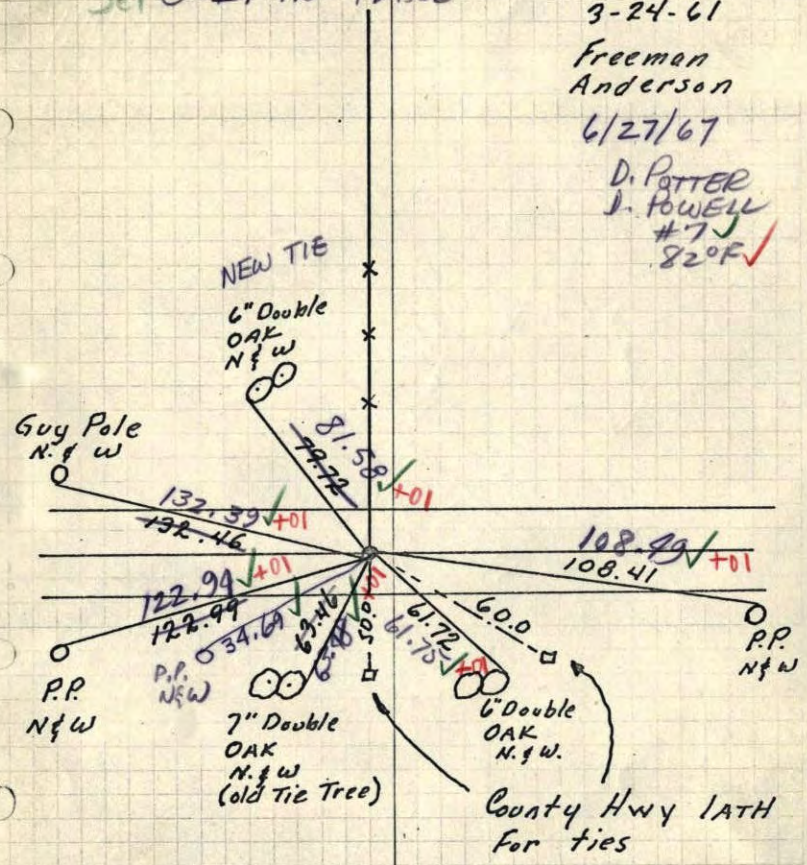

TEMPERATURE CORRECTED AND HORIZONTALLY TAPED MEASUREMENTS

ROLAND W. ANDERSON
COUNTY SURVEYOR
ANOKA COUNTY, MINNESOTA

#21

S.W. Cor. Sec 8-33-22 Linwood
1" Iron down 1.0' in ℄ Road. (C. #22)

3-24-61
Freeman
Anderson

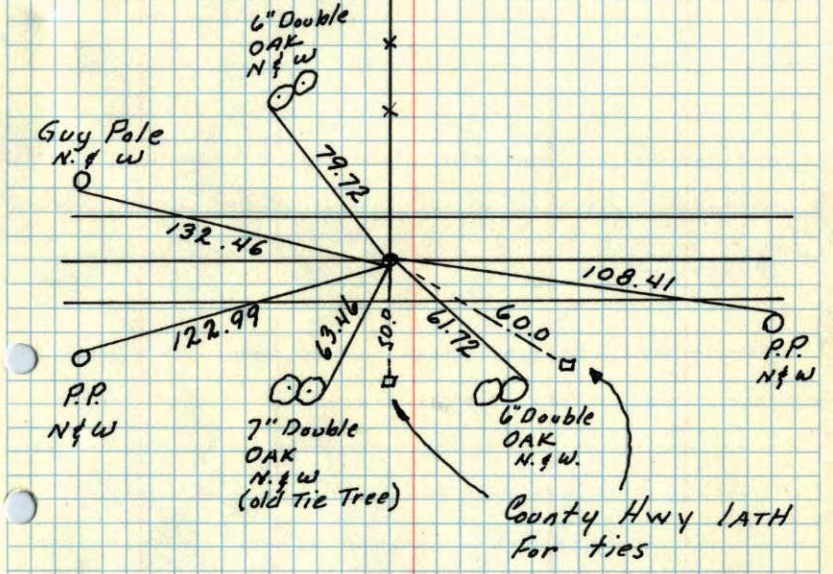

TEMPERATURE CORRECTED AND HORIZONTALLY TAPED MEASUREMENTS

ROLAND W. ANDERSON
COUNTY SURVEYOR
ANOKA COUNTY, MINNESOTA

24 March 1961
Freeman Anderson
+54°

To check Dist. from SW Cor Sec 8-33-22 Linwood to iron pipe on So Line Sec 8 & E. Line of County Rd. #22

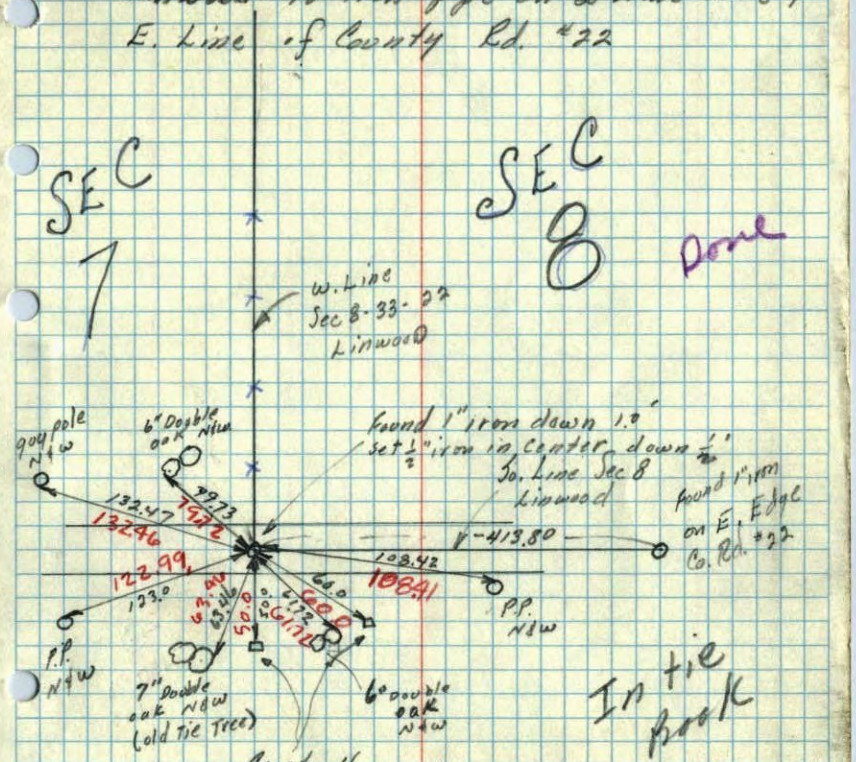

Note: Established Cor from old tie tree & County Hwy tie lath - dug down 1.0' found 1" iron - fit ties good Set ½" iron in Center of old iron down 0.5' in Center gravel Road

3-16-56

2 years ago. 8

~~NE~~ SW Corner of Sec. ~~18~~ T33, R22 was a stone mon. in ℄ of Road.

M.C. 24 was a cedar Post down the bank.

Lewis Grant
Modern Pine Cafe & Cabins
Elk River, Minn.