S.W. Cor. Sec. 7-T33-R22

Set Cast Iron Monument

May 25, 1960
D. Potter Assisting

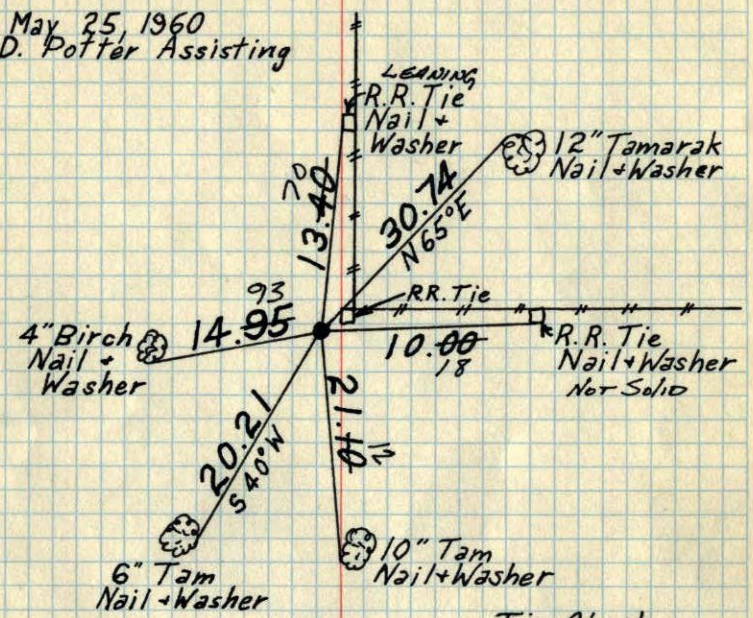

Tie Check
July 11, 1967
D. Potter
D. Powell

Tie Check
July 25, 1971
R. Brien
J. Boettcher
B. Olson

TIE CHECK
7-25-75
D. DAHL
G. ADAMS

TEMPERATURE CORRECTED AND HORIZONTALLY TAPED MEASUREMENTS

ROLAND W. ANDERSON
COUNTY SURVEYOR
ANOKA COUNTY, MINNESOTA

SW. Corn. Sec. 7, T33, R22

Set Cast Iron Monument

7/11/67
D. POTTER
D. POWELL
✓#7-75°F✓

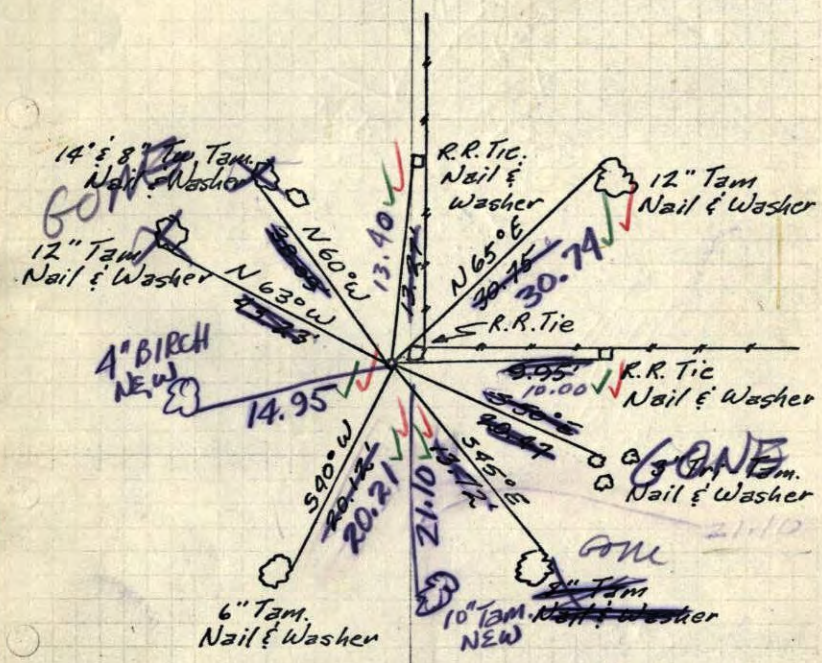

May 25, 1960
Dennis Potter Assisting

ROLAND W. ANDERSON
COUNTY SURVEYOR
ANOKA COUNTY, MINNESOTA

SW. Corn. Sec. 7, T33, R22

Set Cast Iron Monument

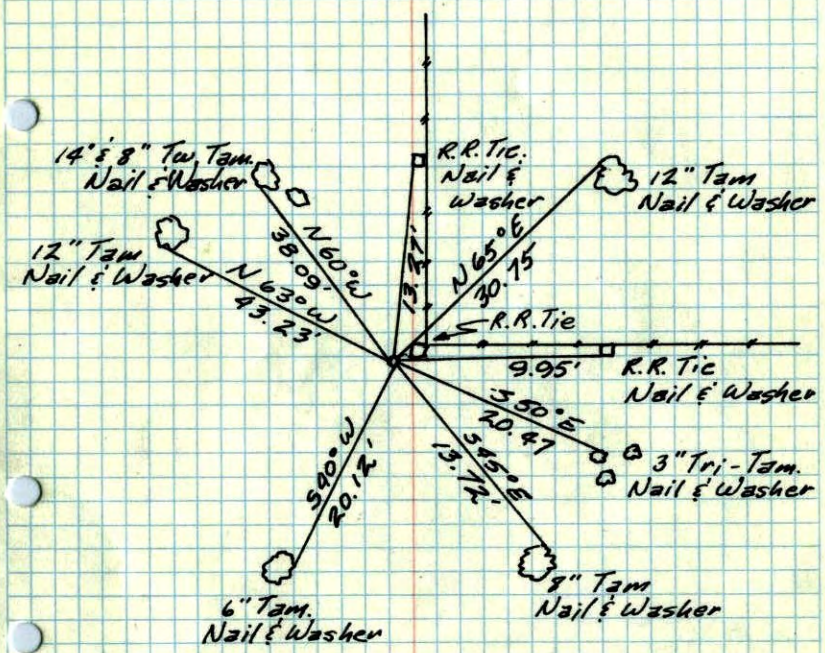

May 25, 1960

Dennis Potter Assisting

ROLAND W. ANDERSON
COUNTY SURVEYOR
ANOKA COUNTY, MINNESOTA

SW Corn. Sec. 7, 33-22

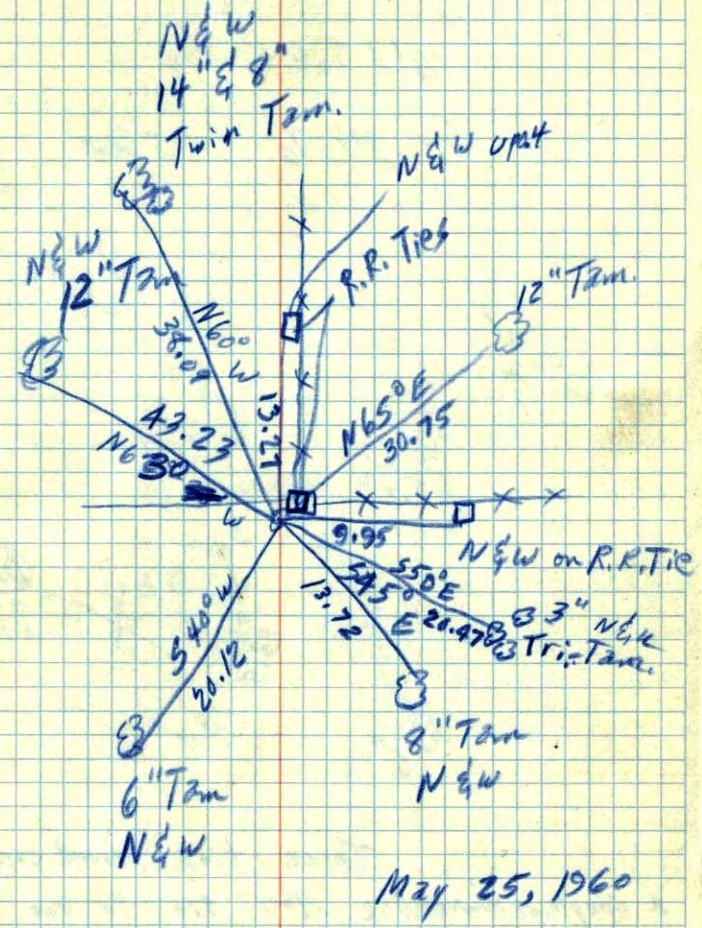

May 25, 1960

Set Cast Iron Monument

Old Ties to

Sw sec. 7, 33-22

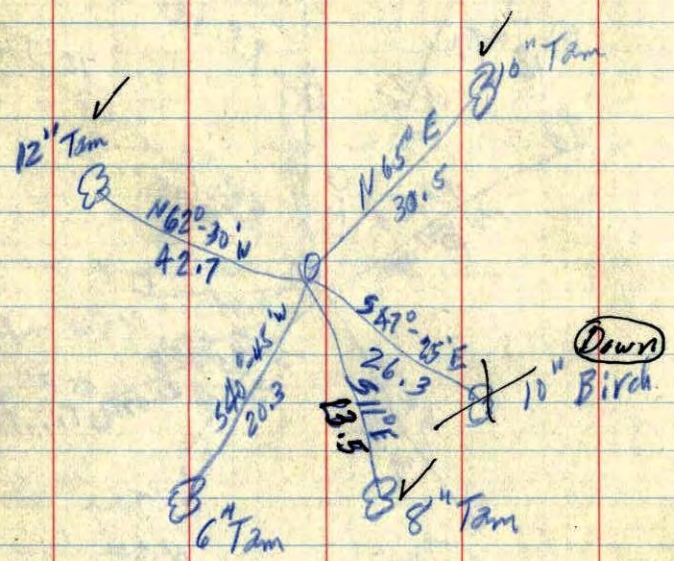

Three ties proved correct to a Couple of Hundreths One other tie to two tenths and the Birch tree was leaning and no longer useful. I placed cast iron Mon. at intersection of the 3 ties.

Roland W. Anderson

SW Sec. 7 T 33 R 22

1½" I.P. Flush
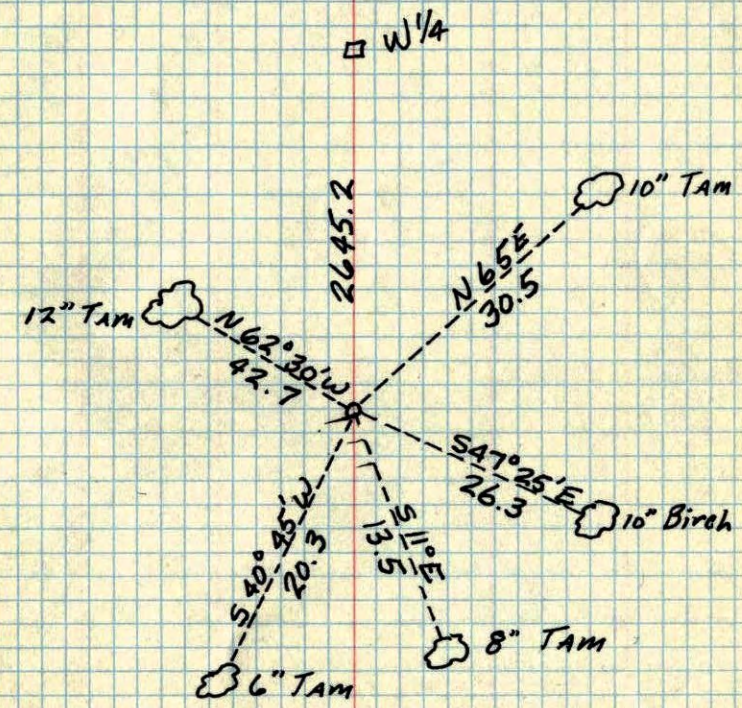
12/10/46