CERTIFICATE OF LOCATION OF GOVERNMENT CORNER

County of Anoka State of Minnesota

Witness Corner of Sec. 4 Township 33 Range 22
(on east line of NE1/4)

On the 26th day of December, 1975, the described corner was evidenced by area resurvey

and to perpetuate the location of said corner, at the exact location thereof, a permanent marker was placed consisting of a cast iron monument

AND on the 1st day of April, 2004, said permanent marker was found and the ties were updated

Updated reference ties are as shown below.

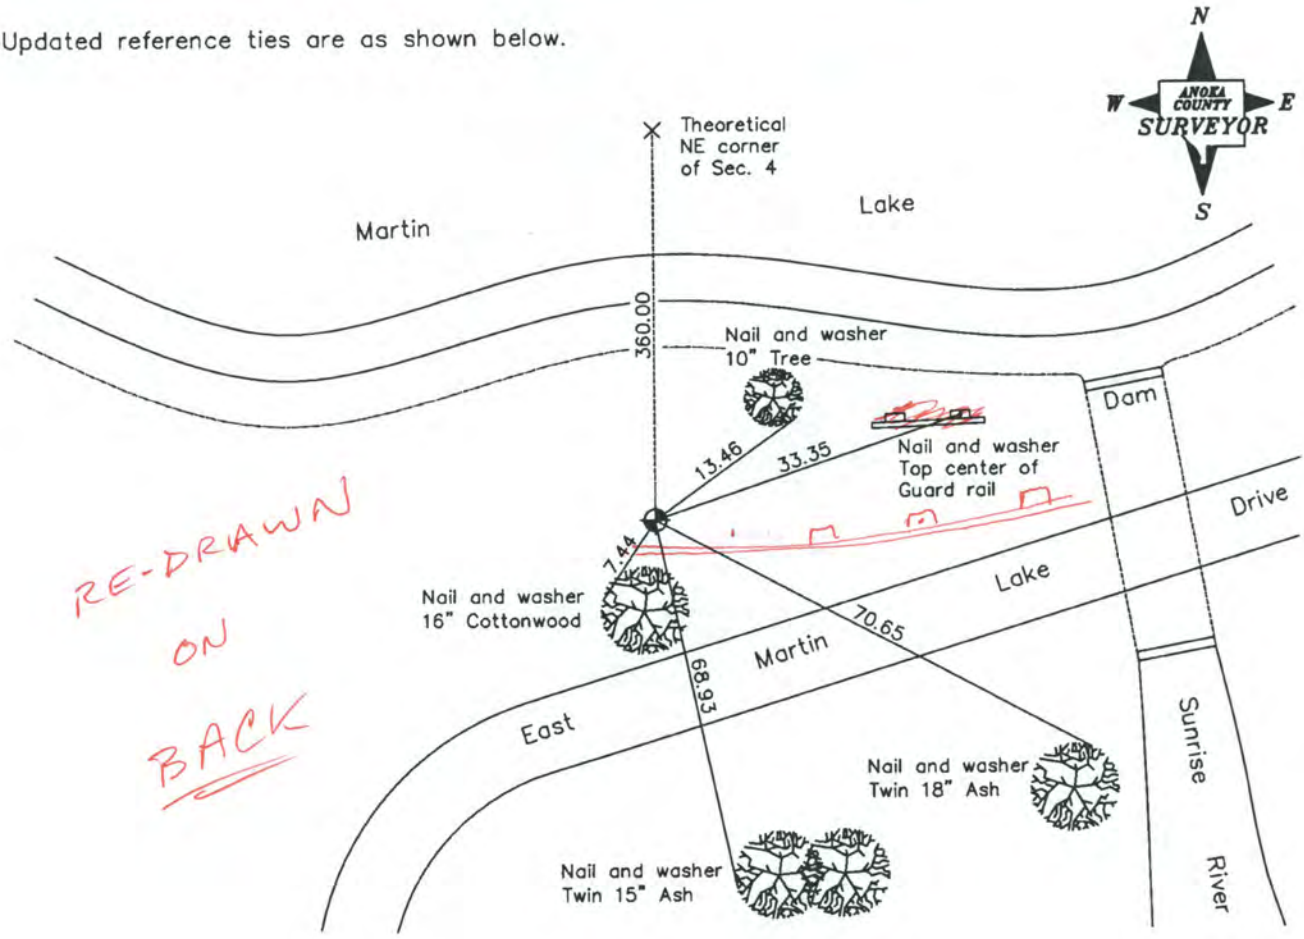

Revised date
8/11/87
6/30/93
4/01/04

N.A.D. 1983 Coordinates (1996 Adjustment)

County Project Coordinates	
Northing	226875.1323
Easting	547990.9754
Date	4/01/04

I hereby certify that this United States public land survey monument record is correct and complete to the best of my knowledge and belief.

Larry D. Hoium Date 4/01/04

Larry D. Hoium, Anoka County Surveyor

Minnesota License Number 18165

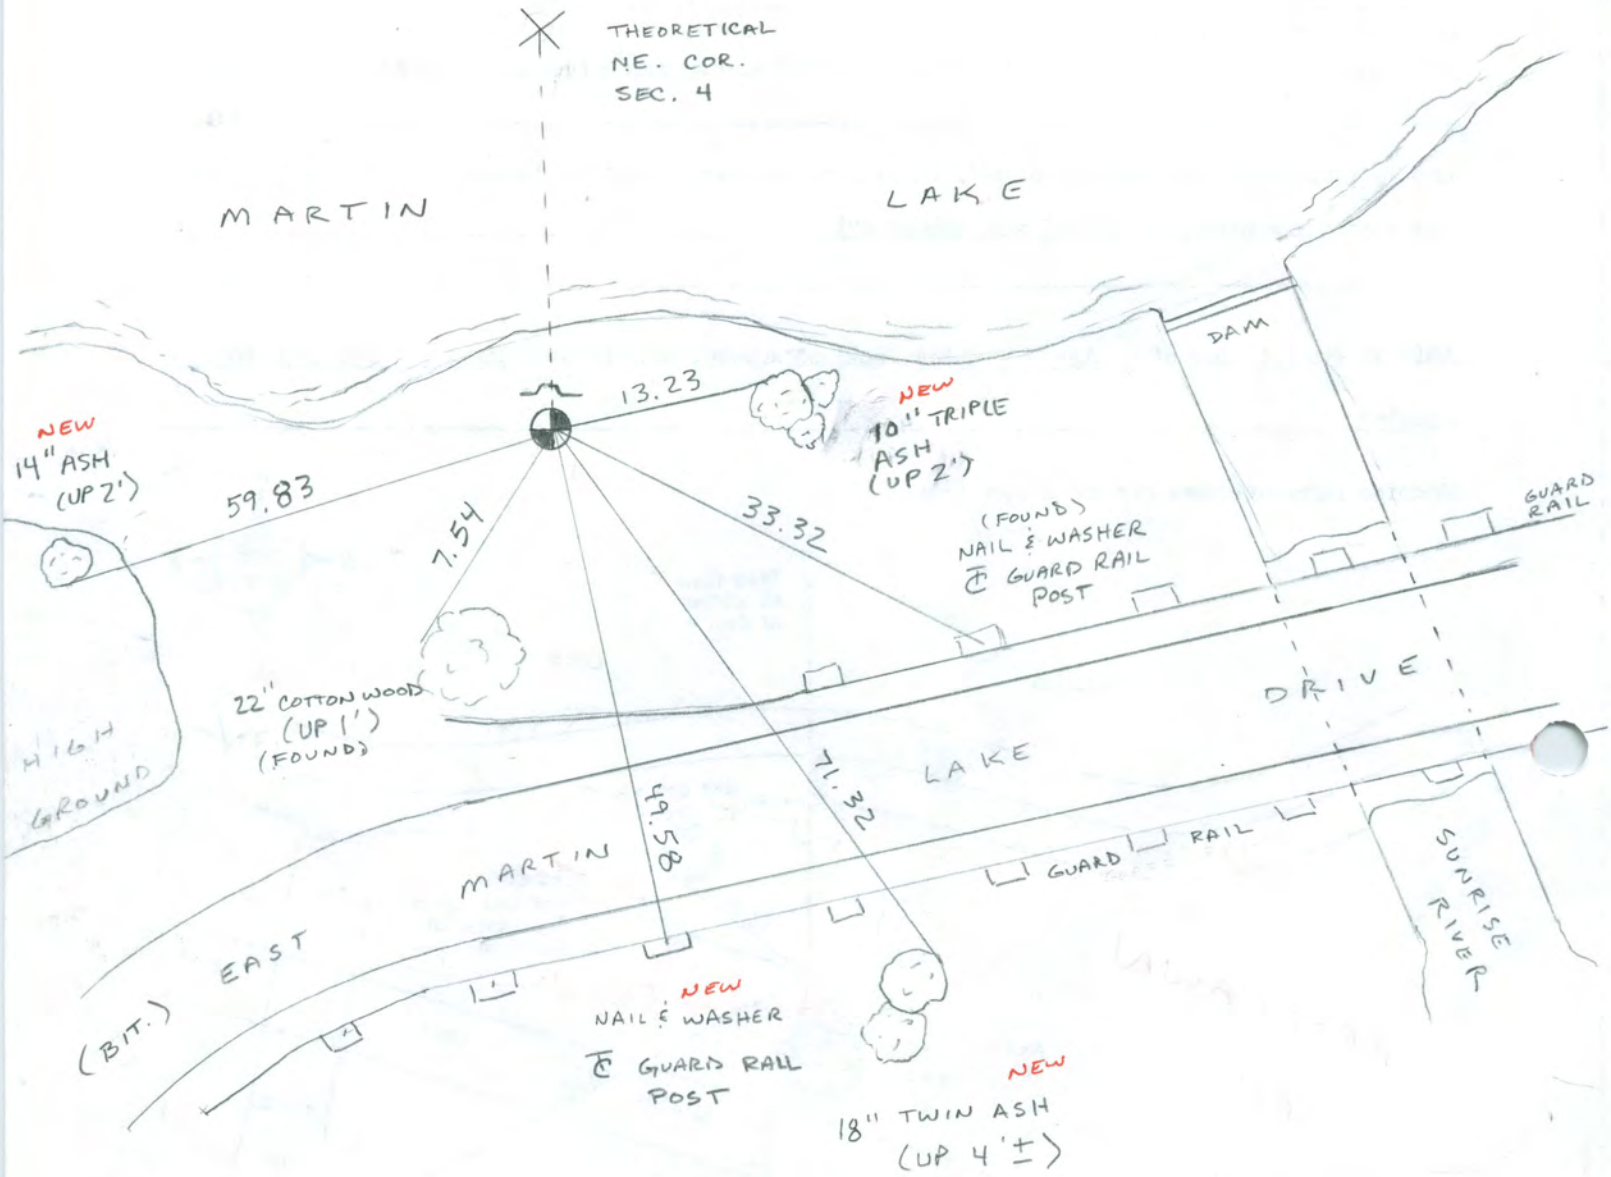

11-19-13

BK - SS

T/T - SIGN & POST ADDED ON N. SIDE FACING S.

* MON. DOWN 1' ±

CERTIFICATE OF LOCATION OF GOVERNMENT CORNER

County of Anoka State of Minnesota

WITNESS ON EAST LINE OF N.E. 1/4 Corner of Sec. 4 Township 33 Range 22

I hereby certify that on the 26 day of DEC., 1975, I found the described corner which was evidenced by AREA RESURVEY

and I further certify that to perpetuate the location of said corner, I did, at the exact location thereof, place a permanent marker consisting of CAST IRON MON.

which reference or witness monuments are located in the manner following:

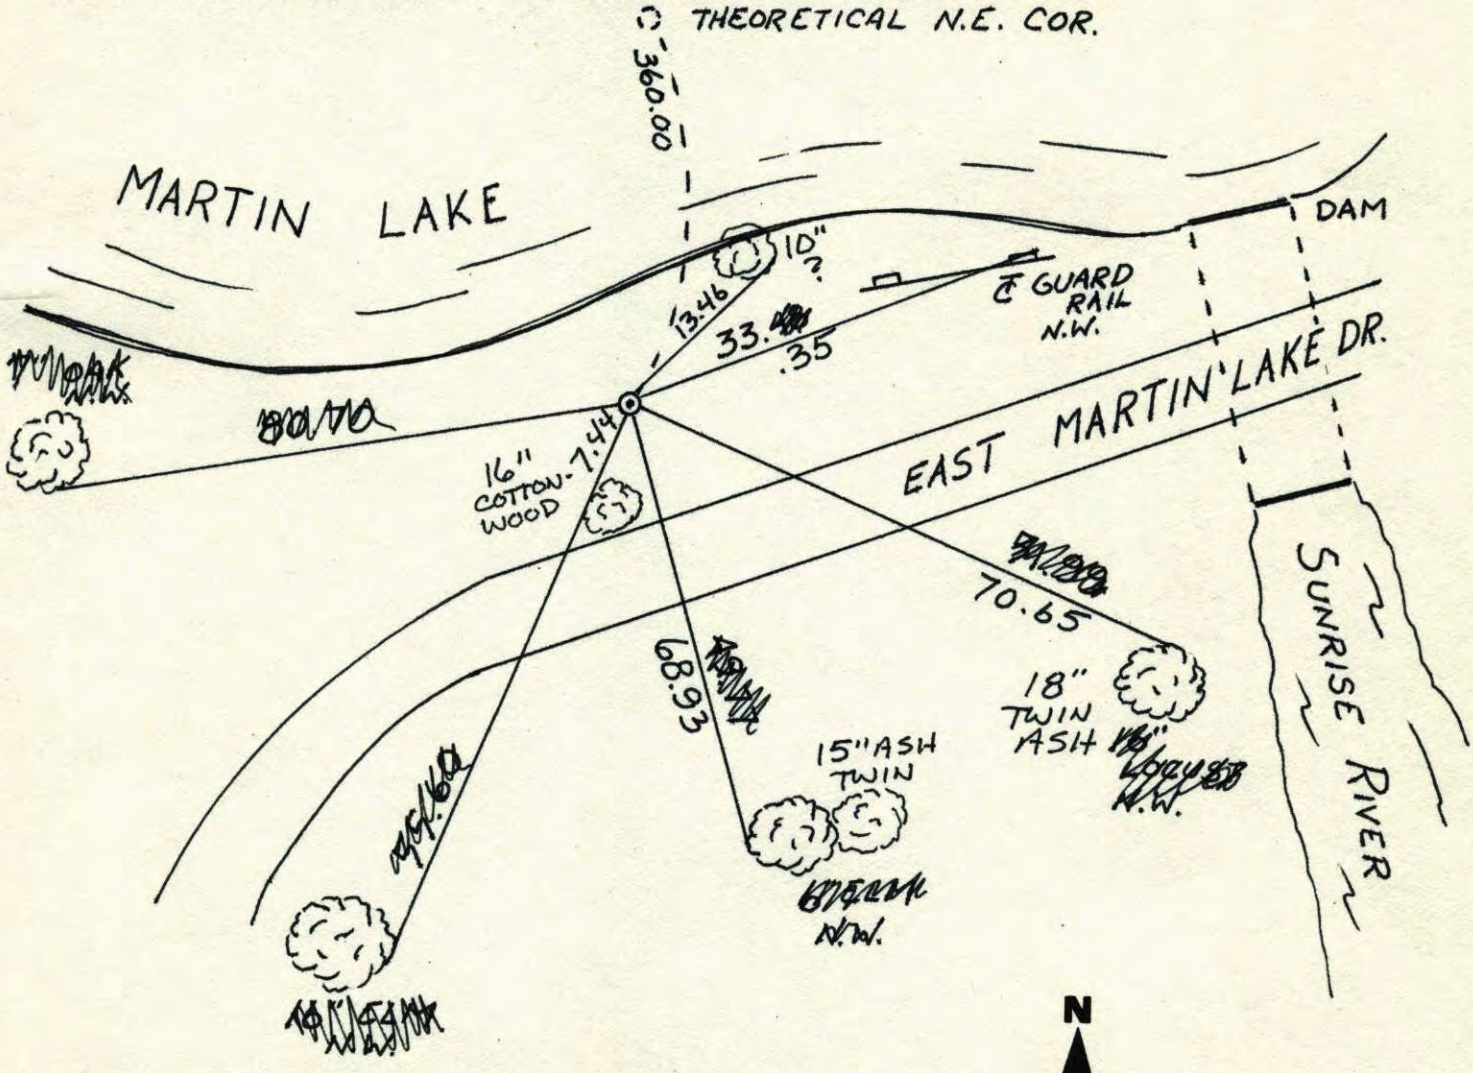

Revised date	Revised date	Revised date
8-11-87		
6-30-93		
4-1-04		

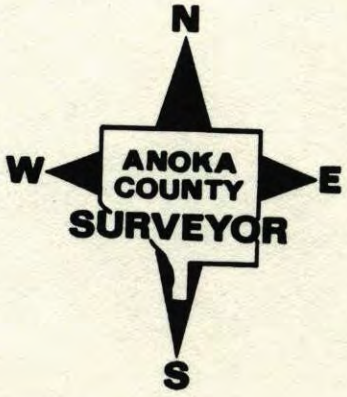

Redraw 8-23-84

7

W.C. ON EAST LINE OF N.E¼ SEC. 4 T33 R22

SET ½" IRON PIPE FROM AREA RESURVEY.

Set C.I. Monument Down .5'
5-6-76
H. Larson B. Guetzko

THEORETICAL N.E. COR.
360.00 N. OF W.C.

N
12-26-75
H. LARSON
J. BOETTCHER
B. GUETZKO

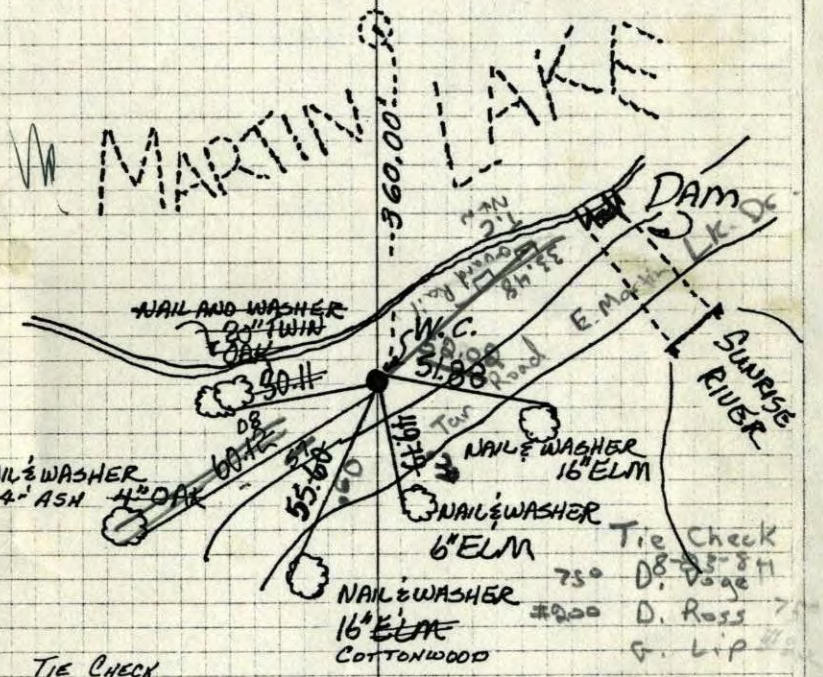

TIE CHECK
7-18-78
D. Dahl
B. Stephens

TIE CHECK
8-6-81
P. ROSS
P. HORNBY
G. NEFFANGER

Tie Check
D. Dodge
D. Ross
G. Lip

TEMPERATURE CORRECTED
AND HORIZONTALLY
TAPED MEASUREMENTS

ROLAND W. ANDERSON
COUNTY SURVEYOR
ANOKA COUNTY, MINNESOTA



















7

W.C. on E. Line of NE¼ Sec. 4, T33 R22

Set ½" iron pipe from area resurvey.

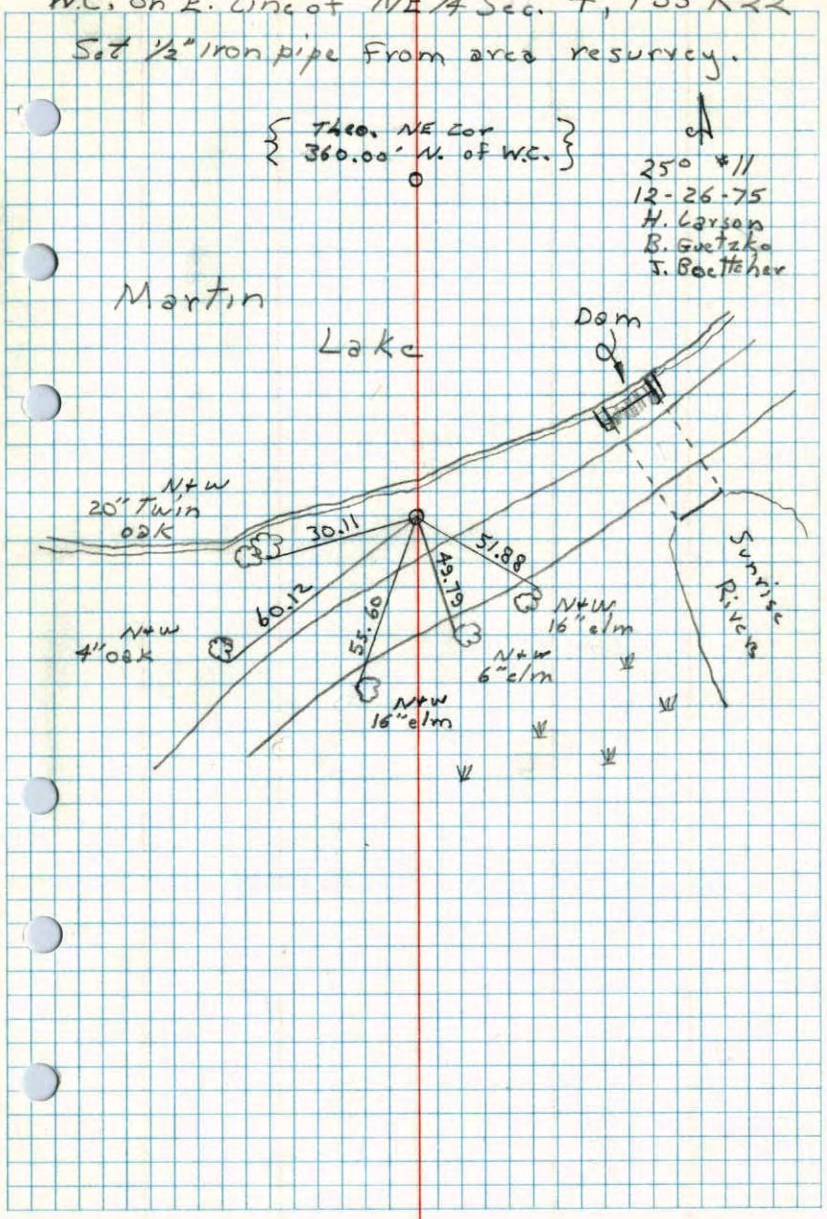

W.C. On E. Line Of NE¼ Sec. 4 - T33 - R22

Set Cast Iron Monument From Area Resurvey
C.I. Monument Down 0.5'±

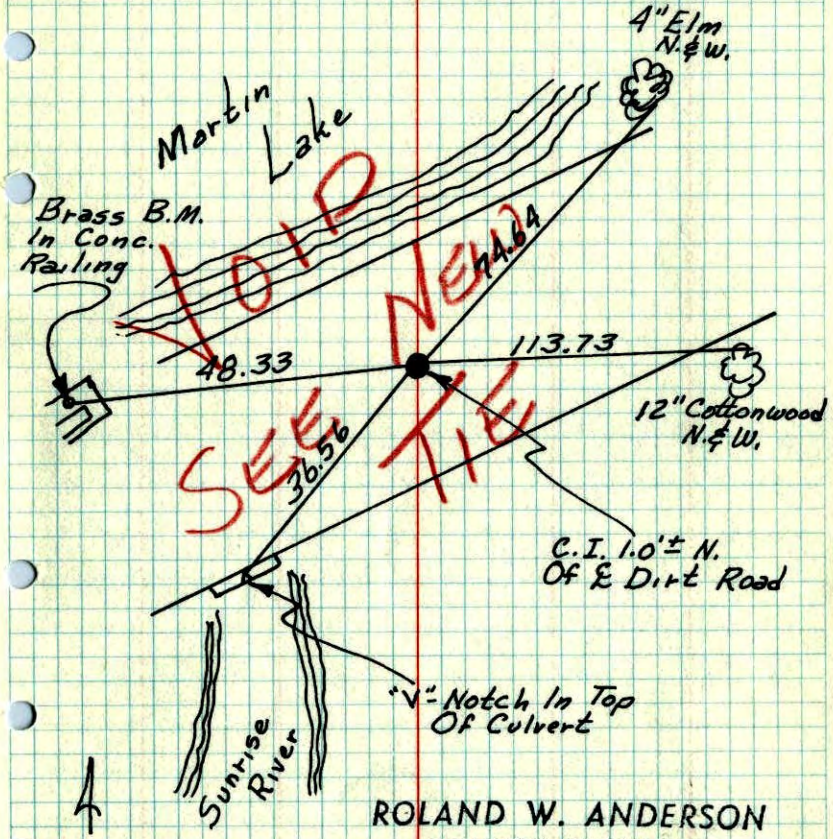

8-12-1974
H. Larson
J. Boettcher
Tape #14
Temp. 72°

ROLAND W. ANDERSON
COUNTY SURVEYOR
ANOKA COUNTY, MINNESOTA

TEMPERATURE CORRECTED AND HORIZONTALLY TAPED MEASUREMENTS

WC on East Line of NE¼ Sec. 4, T33, R22

Set cast iron monument from area resurvey. mon. down .5'±
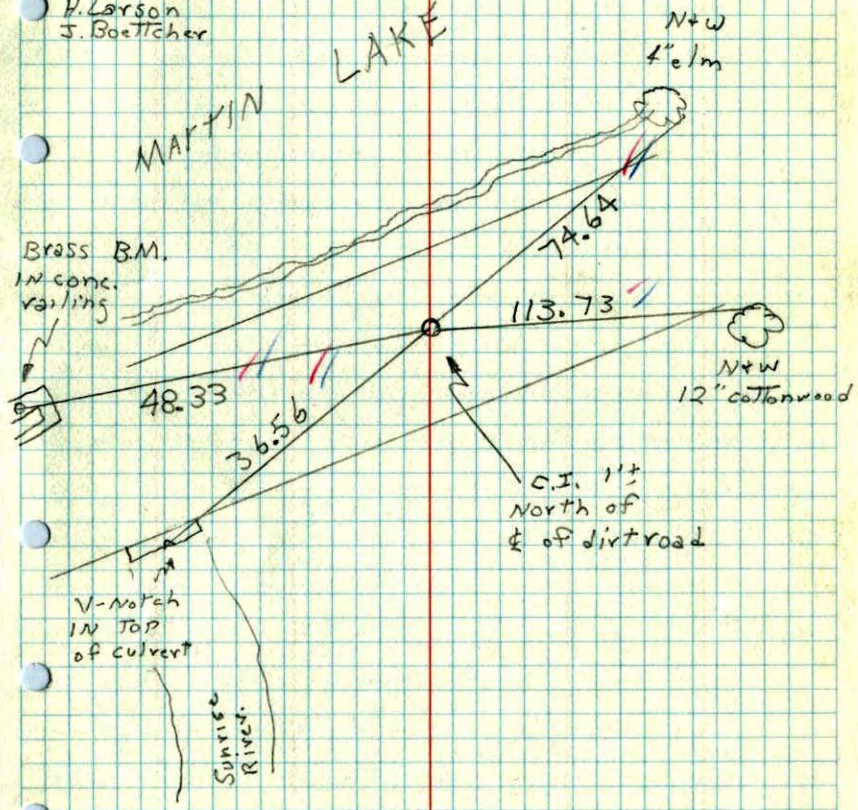
8-12-74
72° #14
H. Larson
J. Boettcher