CERTIFICATE OF LOCATION OF GOVERNMENT CORNER

County of Anoka State of Minnesota

SOUTHWEST Corner of Sec. 16 Township 33 Range 22

I hereby certify that on the 15 day of August, 19 75, I found the described corner which was evidenced by Concrete MONUMENT

and I further certify that to perpetuate the location of said corner, I did, at the exact location thereof, place a permanent marker consisting of CAST IRON MON

which reference or witness monuments are located in the manner following:

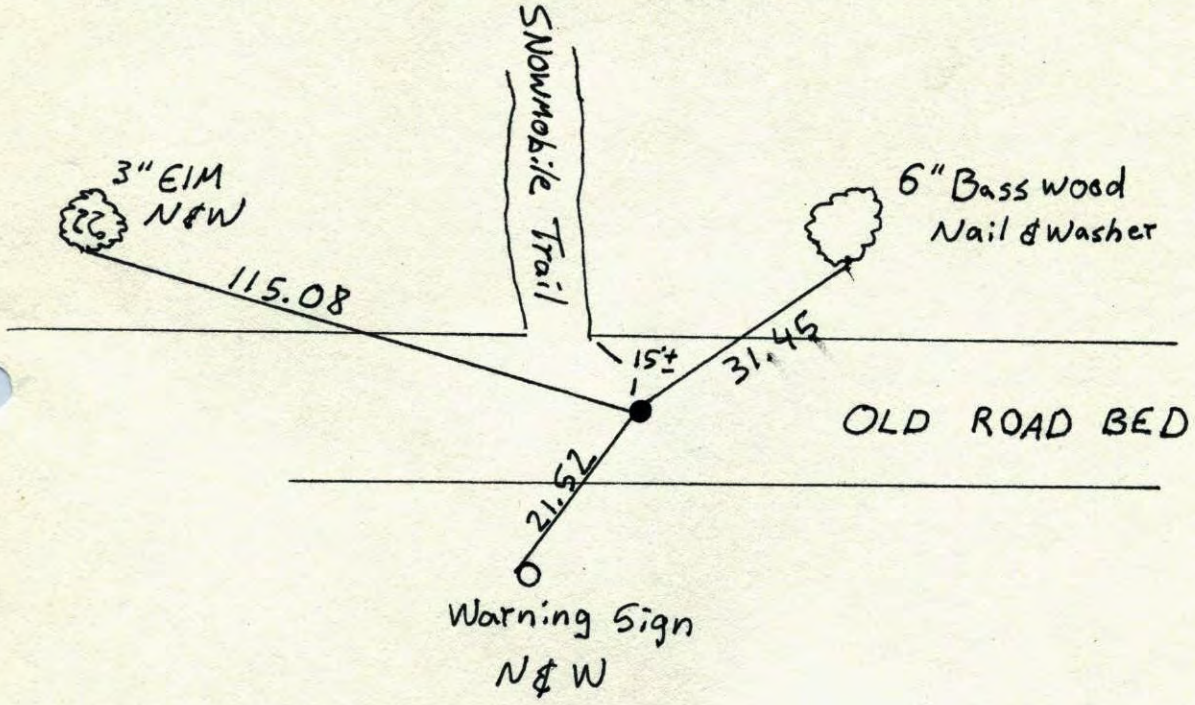

Revised date	Revised date	Revised date
7-2-93		

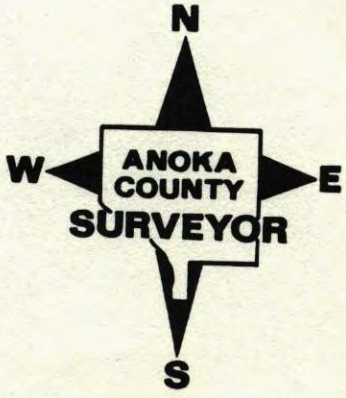

Southwest corner Sec. 16 T33 R22

Retie Cast Iron Mon

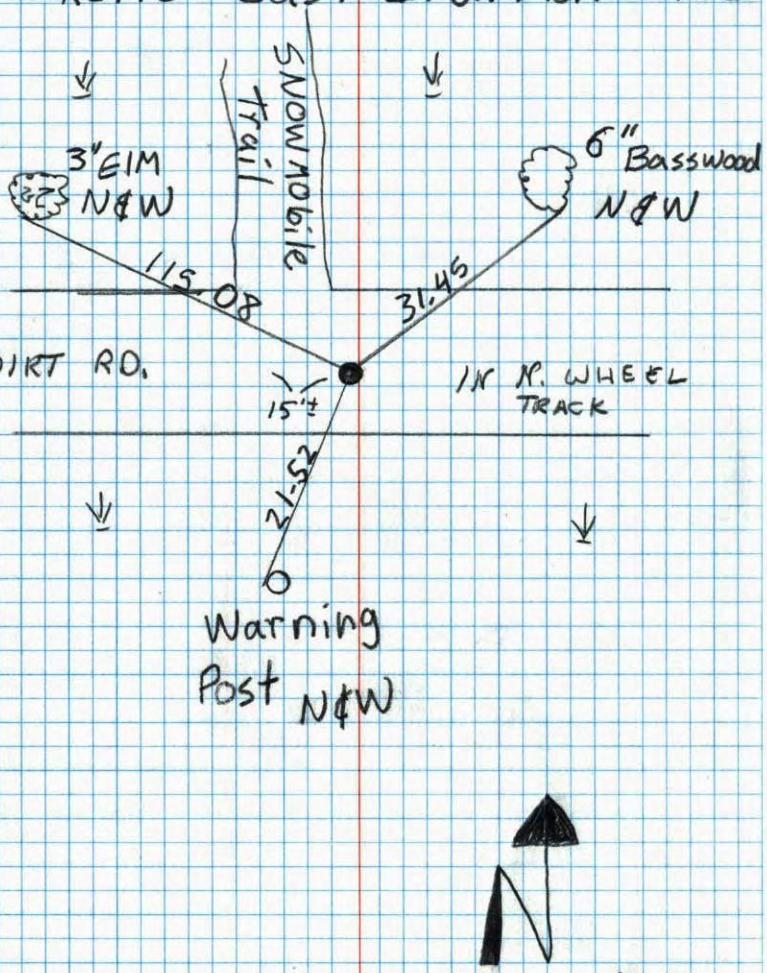

Jayme Anderson
Josh Anderson

S.W. Cor. Sec. 16 T33 R22

Found Old Remains Of Concrete Monument. Also Found Iron 33' South. Concrete Down 1.5'± Placed Spike At Surface. Replaced with Cast Iron Dow 0.5'±
Aug. 75
D. Dahl

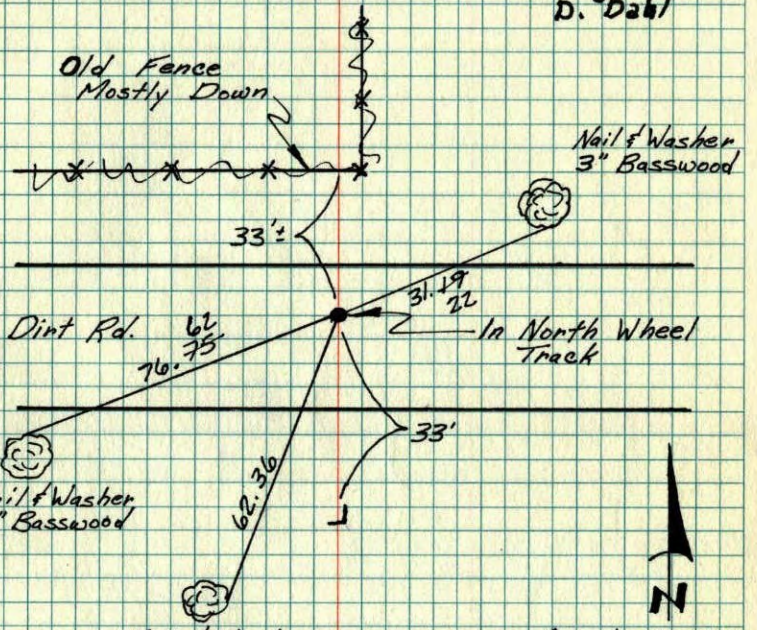

TIE CHECK
8-18-81
P. ROSS
P. HORNBY
G. NEFFINGER

August 15, 1975
H. Larson
R. Guetzko
J. Beattcher

TEMPERATURE CORRECTED AND HORIZONTALLY TAPED MEASUREMENTS

ROLAND W. ANDERSON
COUNTY SURVEYOR
ANOKA COUNTY, MINNESOTA

NO. 448 TELEDYNE

SW Cor. Sec. 16 T33 R22
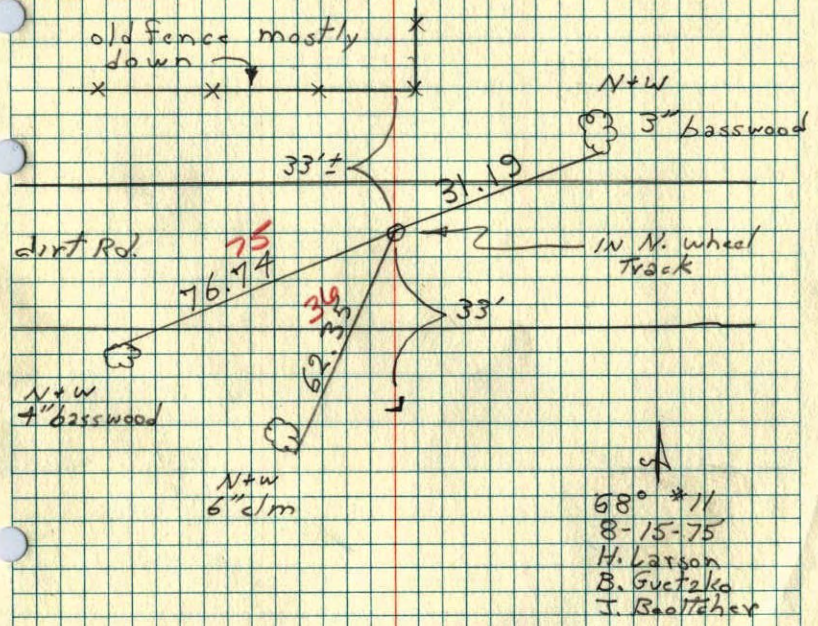
Found old remains of concrete monument. also found iron 33.' south. conc. dow 1.5'± placed spike at surface.