Page No. 81

CERTIFICATE OF LOCATION OF GOVERNMENT CORNER

County of Anoka State of Minnesota

North 1/4 Corner of Sec. 19 Township 33 Range 22

On the 3rd day of November, 1970, the described corner was evidenced by area resurvey

and to perpetuate the location of said corner, at the exact location thereof, a permanent marker was placed consisting of a cast iron monument with a sign and post on the north side (MON DOWN 1'±) SIGN & POST WAS GONE – REPLACED 12-5-13 ON N. SIDE AGAIN

AND on the ___ day of _____, ____, said permanent marker was _____

Updated reference ties are as shown below.

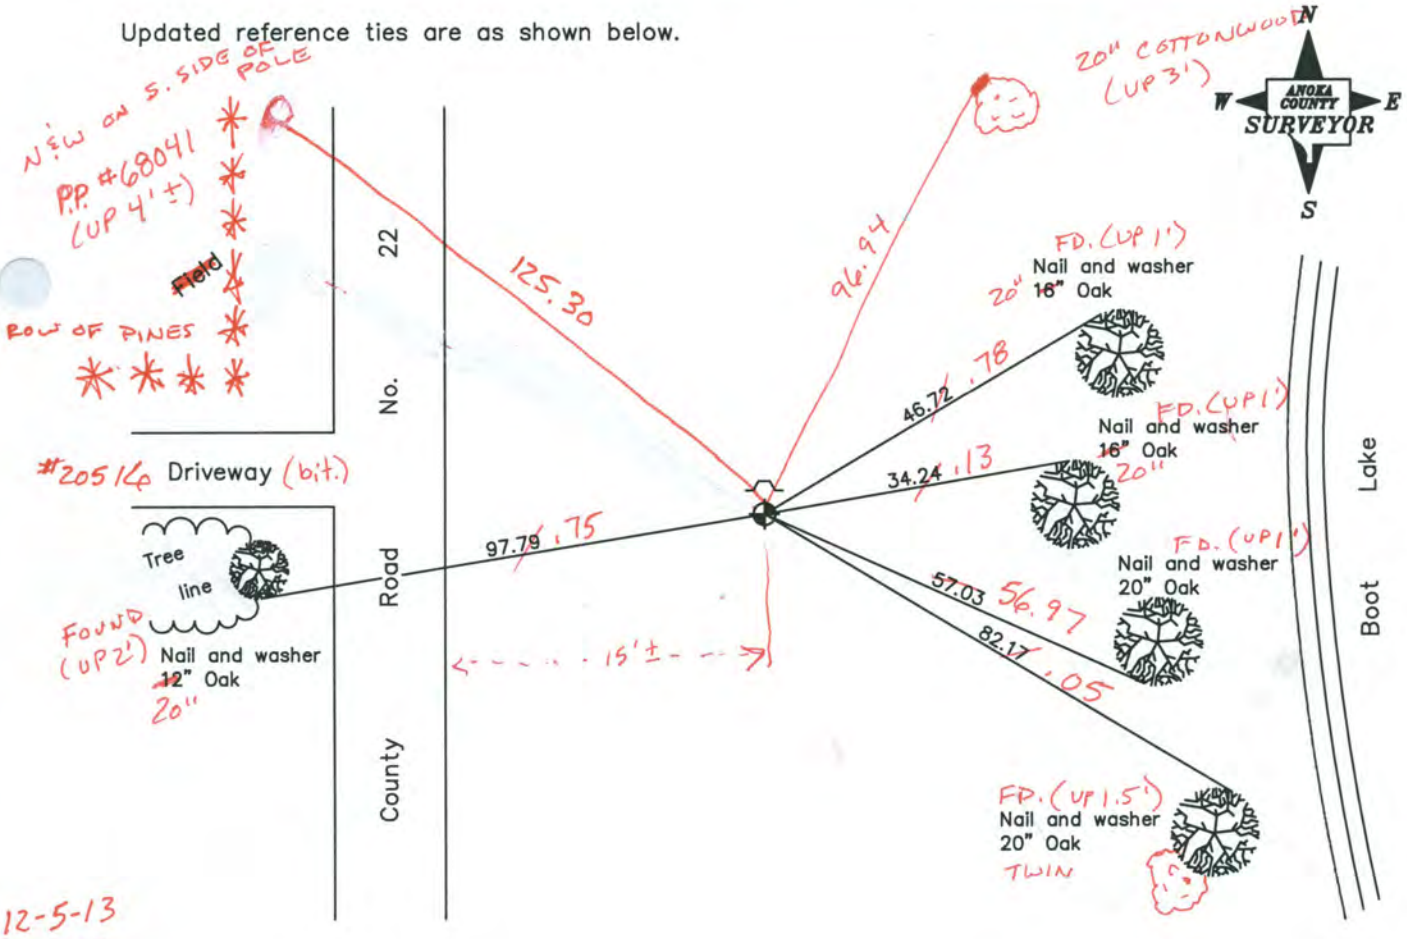

12-5-13
BK-55
T/T-VRS

Revised date
6/15/93

N.A.D. 1983 Coordinates (1996 Adjustment)

County Project Coordinates	
Northing	211443.6519
Easting	534107.8938
Date	4/12/04

I hereby certify that this United States public land survey monument record is correct and complete to the best of my knowledge and belief.

_____ Date _____

_____, Anoka County Surveyor

Minnesota License Number _____

VRS 3DQ = 0.10 N = 211443.6064 E = 534107.8059

CERTIFICATE OF LOCATION OF GOVERNMENT CORNER

County of Anoka State of Minnesota

NORTH 1/4 Corner of Sec. 19 Township 33 Range 22

I hereby certify that on the 3 day of NOV, 19 70, I found the described corner which was evidenced by AREA RESURVEY

and I further certify that to perpetuate the location of said corner, I did, at the exact location thereof, place a permanent marker consisting of CAST IRON MON.

which reference or witness monuments are located in the manner following:

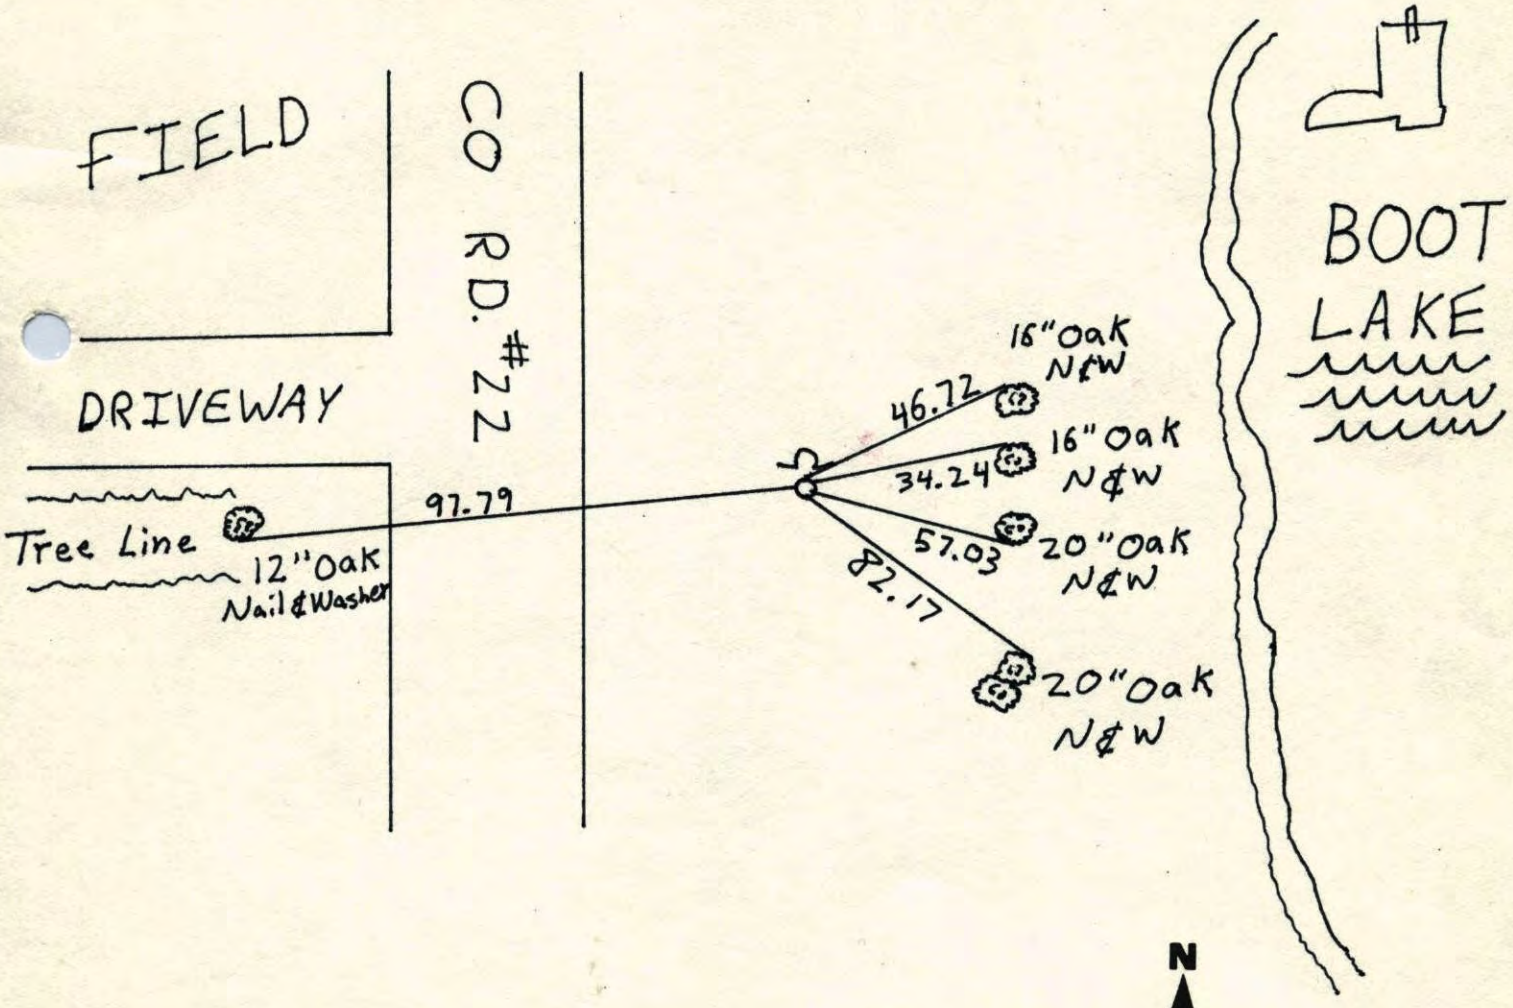

Revised date	Revised date	Revised date
6-15-93		

N
W ANOKA COUNTY SURVEYOR E
S

North 1/4 of Sec 19 T33 R22

CAST IRON MONUMENT RETIE
SIGN AND POST ON N SIDE

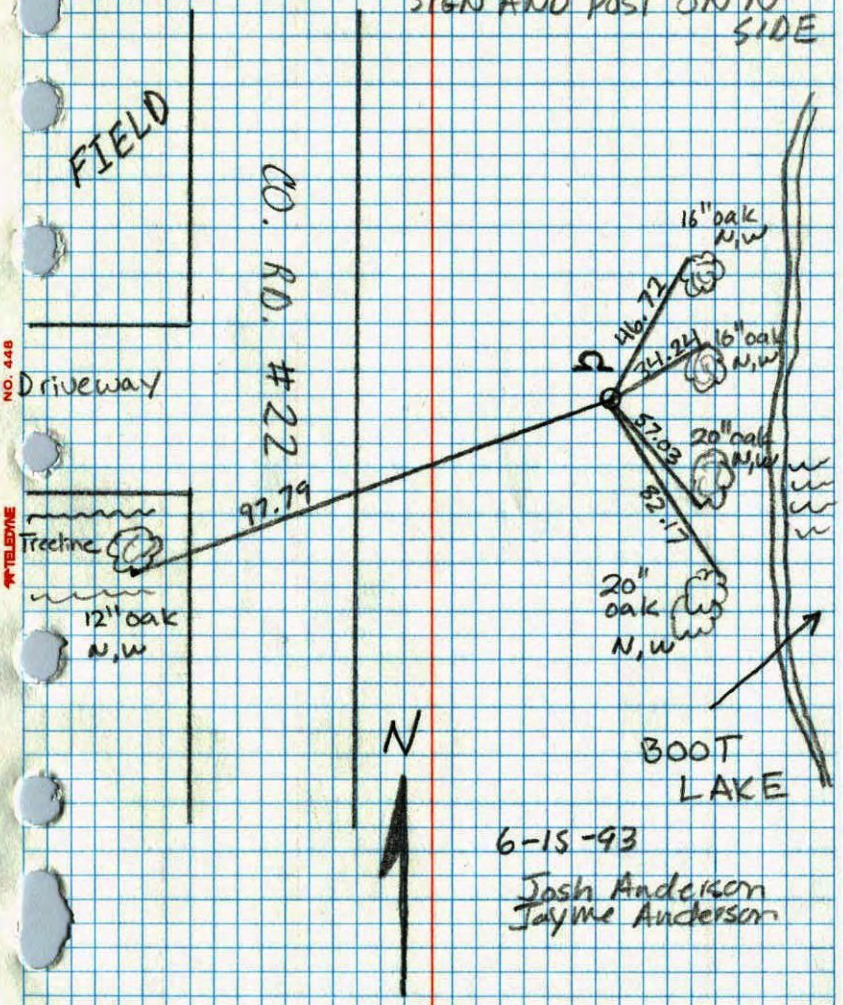

6-15-93
Josh Anderson
Jayme Anderson

NORTH 1/4 SEC. 19 T33 R22

RESET CAST IRON MON. AFTER GAS PIPE LINE CONSTRUCTION C.I. DOWN .5' ±
COR. IN BOTTOM OF DITCH

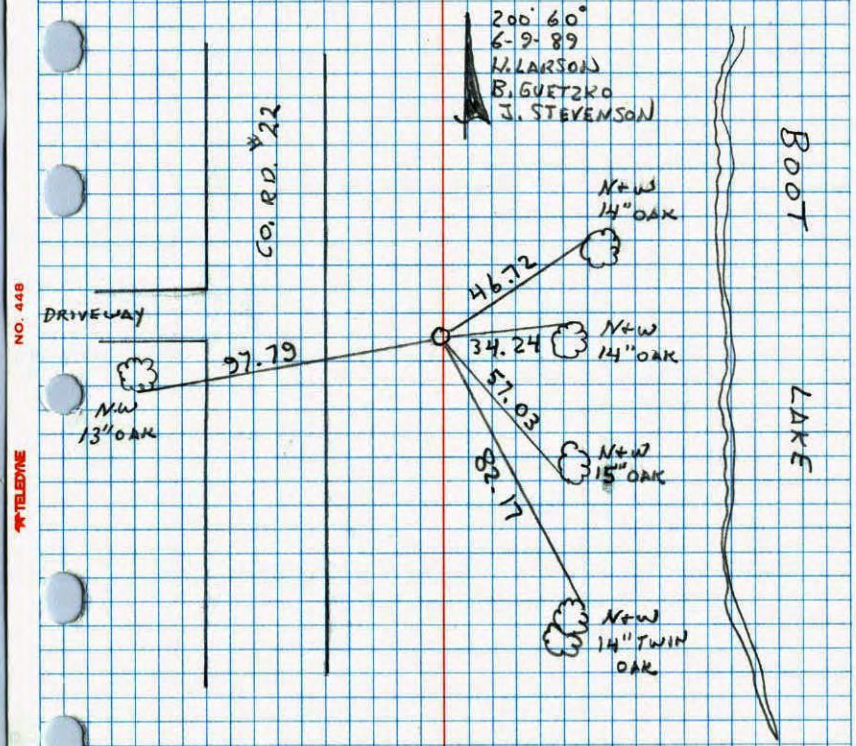

N¼ Cor. Sec. 19-T33-R22

Set Cast Iron Monument down 0.4'± in bottom of ditch from area resurvey. Placed steel sign post + warning sign ½'± North of Monument.

Nov. 3, 1970
M. D. Anderson
H. J. Larson
W. Weslander

Tie Check
June 24, 1971
R. Brien
J. Boettcher
B. Olson

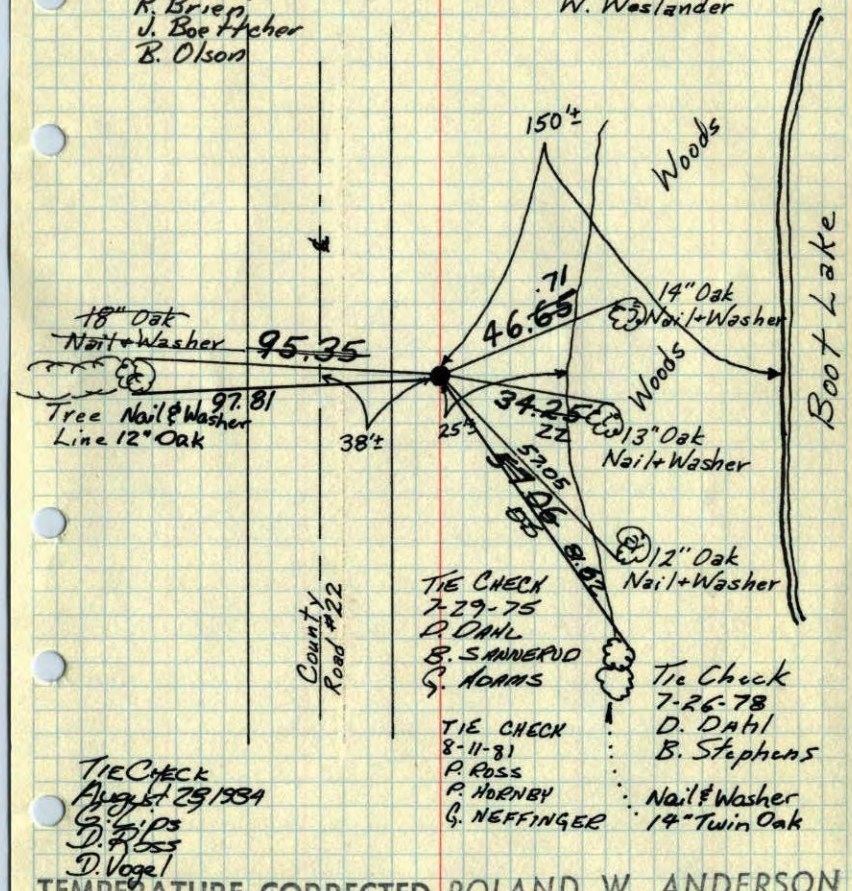

Tie Check
August 29, 1984
G. Fips
D. Ross
D. Vogel

TEMPERATURE CORRECTED AND HORIZONTALLY TAPED MEASUREMENTS

ROLAND W. ANDERSON
COUNTY SURVEYOR
ANOKA COUNTY, MINNESOTA

N¼ Cor. Sec. 19-T33-R22

Set C.I. Mon. down 0.4'± in bottom of ditch
Set C.I. Mon. from area resurvey
Placed steel sign post & warning sign ½'± N of Mon.
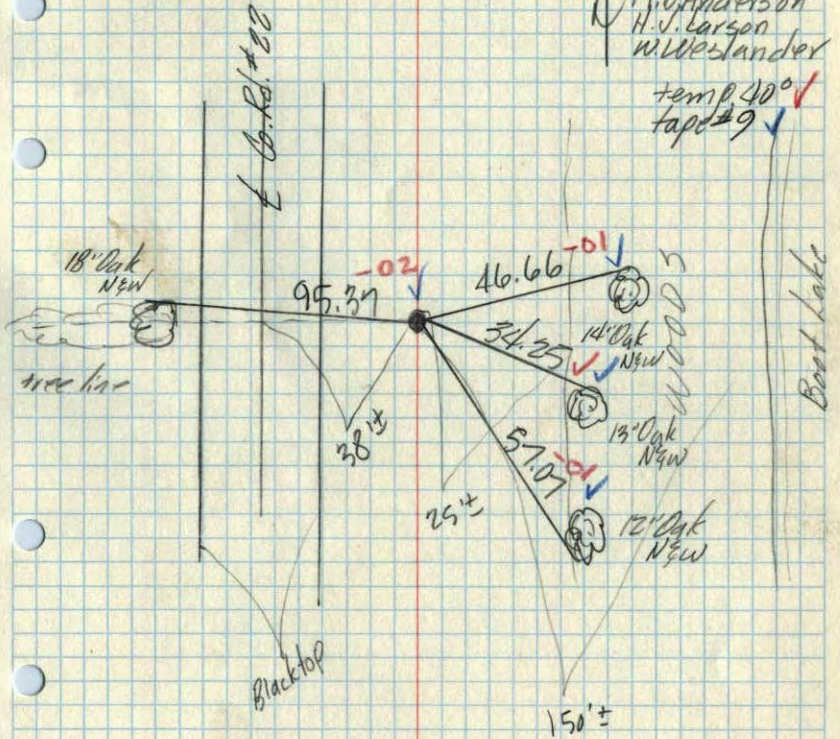
Nov. 3, 1970
M. D. Anderson
H. J. Larson
W. Weslander
temp 40° ✓
tape #9 ✓