W 1/4 Cor. Sec. 19-T33-R22

Found ~~1" Iron Rod~~ flush from ties

by Roy Carlson.
Replaced with Cast Iron Monument and steel sign post with warning sign ½"± No. of Mon.
11/5/70

March 16, 1970
M. D. Anderson
H. J. Larson
R. A. Olson

Nov. 5, 1970
M. D. Anderson
H. J. Larson
W. Weslander

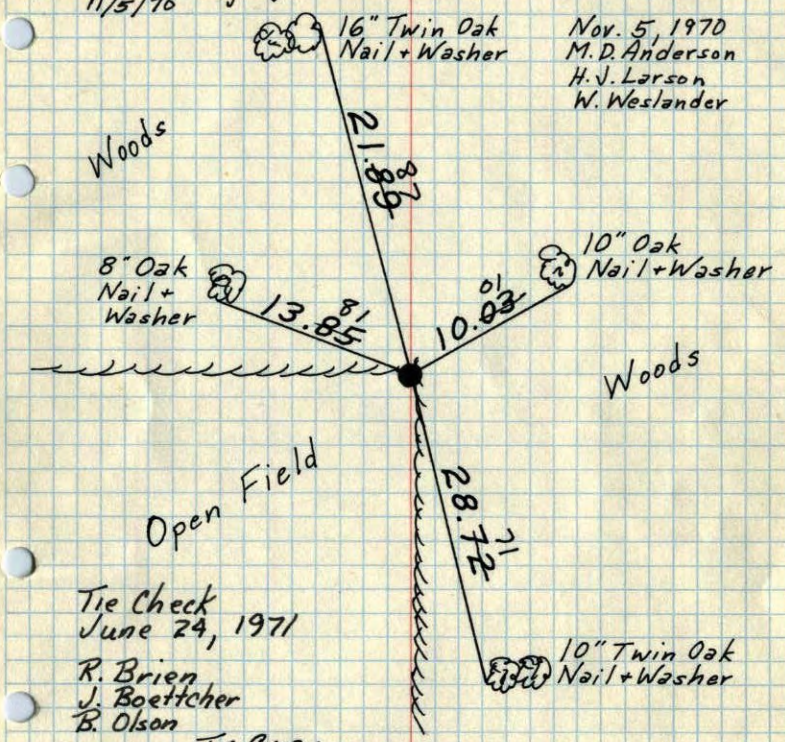

Tie Check
June 24, 1971
R. Brien
J. Boettcher
B. Olson

TIE CHECK
7-29-75
D. DAHL
B. SANNEROD
G. ADAMS

Tie Check
8-3-78
D. Dahl
M. Kisrow
B. Stephens

TIE CHECK
8-17-81
P. ROSS
P. HORNBY
G. NEFFINGER

TEMPERATURE CORRECTED AND HORIZONTALLY TAPED MEASUREMENTS

W 1/4 Cor. Sec. 19-T33-R22

found 1" Iron Rod flush
found from ties by Roy Carlson

March 16 1970
M. D. Anderson
H. J. Larson
R. A. Olson
temp. 25°
tape 77 (new) #10

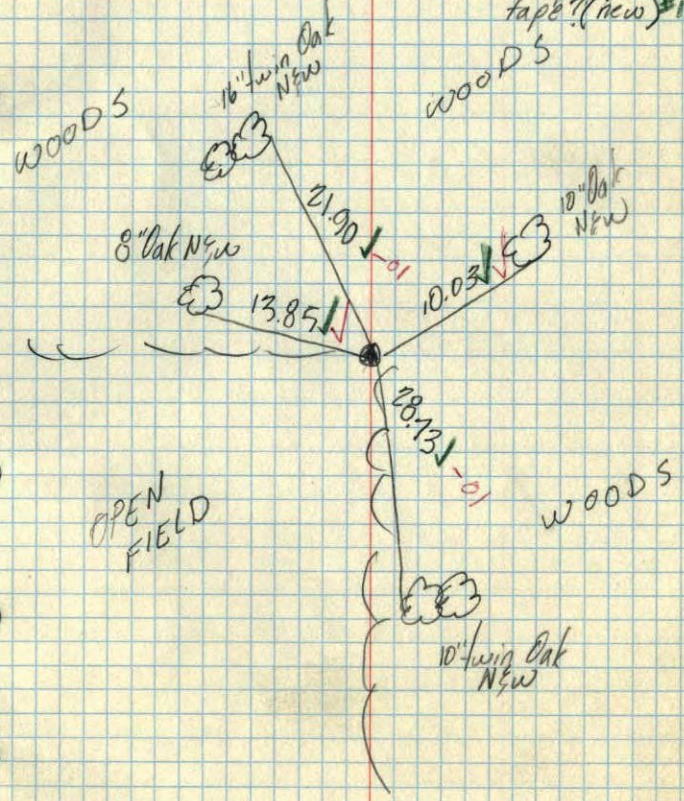

W 1/4 Corn. Sec. 19, T33, R22
Wooded

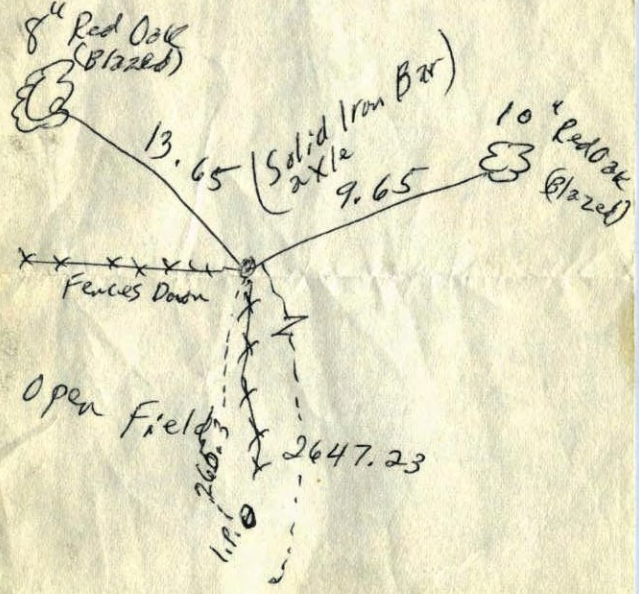

Roy Carlson