CERTIFICATE OF LOCATION OF GOVERNMENT CORNER

County of Anoka State of Minnesota

Northwest Corner of Sec. 4 Township 33 Range 22

On the 27th day of February, 1961, the described corner was evidenced by a stone monument

and to perpetuate the location of said corner, at the exact location thereof, a permanent marker was placed consisting of a cast iron monument (MON. 2' +/- E. OF ℄)

AND on the ___ day of _____, ____, said permanent marker was _____

Updated reference ties are as shown below.

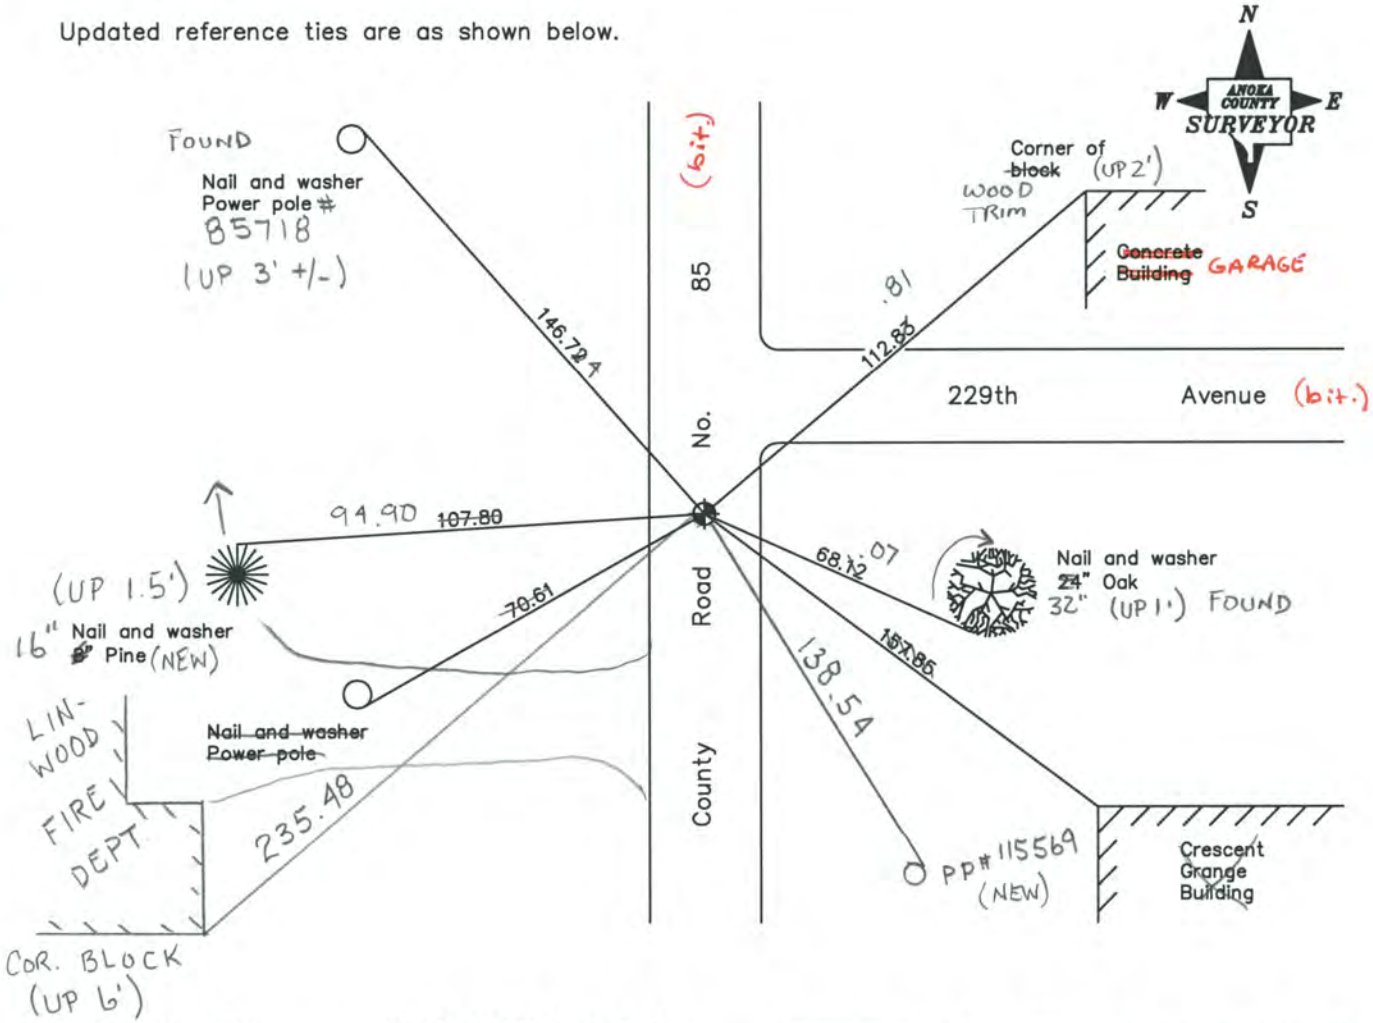

Revised date

6/16/93
11-18-13
T.T.
BK - 55

N.A.D. 1983 Coordinates
(1996 Adjustment)

County Project Coordinates	
Northing	227474.1642
Easting	542740.0433
Date	6/05/03

I hereby certify that this United States public land survey monument record is correct and complete to the best of my knowledge and belief.

_____ Date _____

_____, Anoka County Surveyor

Minnesota License Number _____

Page No. 9

CERTIFICATE OF LOCATION OF GOVERNMENT CORNER

County of Anoka State of Minnesota

Northwest Corner of Sec. 4 Township 33 Range 22

On the 27th day of February, 1961, the described corner was evidenced by a stone monument

and to perpetuate the location of said corner, at the exact location thereof, a permanent marker was placed consisting of a cast iron monument

AND on the ___ day of _____, ____, said permanent marker was 9-10-12 JS SH ~~RESET C.I.M. & SWING TIES ARE~~ CIRCLED

Updated reference ties are as shown below.

3-25-12 JS. SH. T/T + SWING REMOVED CIM FOR CONST.

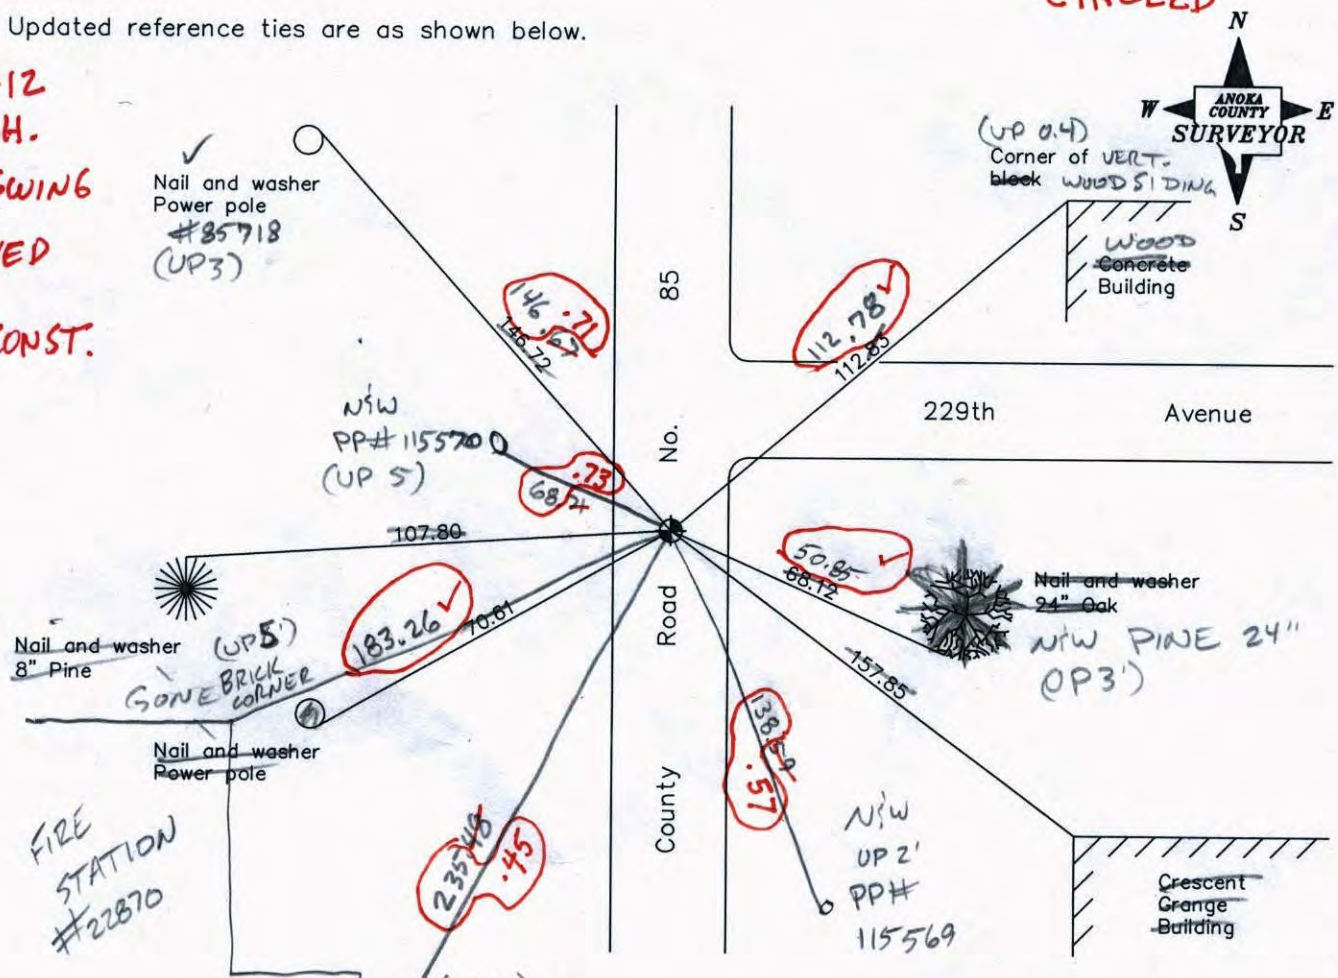

S · 0.03

Revised date
6/16/93

VRS BEFORE REMOVAL

N.A.D. 1983 Coordinates (1996 Adjustment)

County Project Coordinates	
Northing	227474.1642
Easting	542740.0433
Date	6/05/03

I hereby certify that this United States public land survey monument record is correct and complete to the best of my knowledge and belief.

_____ Date _____

_____, Anoka County Surveyor

Minnesota License Number _____

3DQ = 0.05 N: 227474.1229 E: 542739.9435

NW COR SEC 4 T33 R22

TRANSIT TIE + SWING TIES

REMOVED C.I.M FOR CONST.

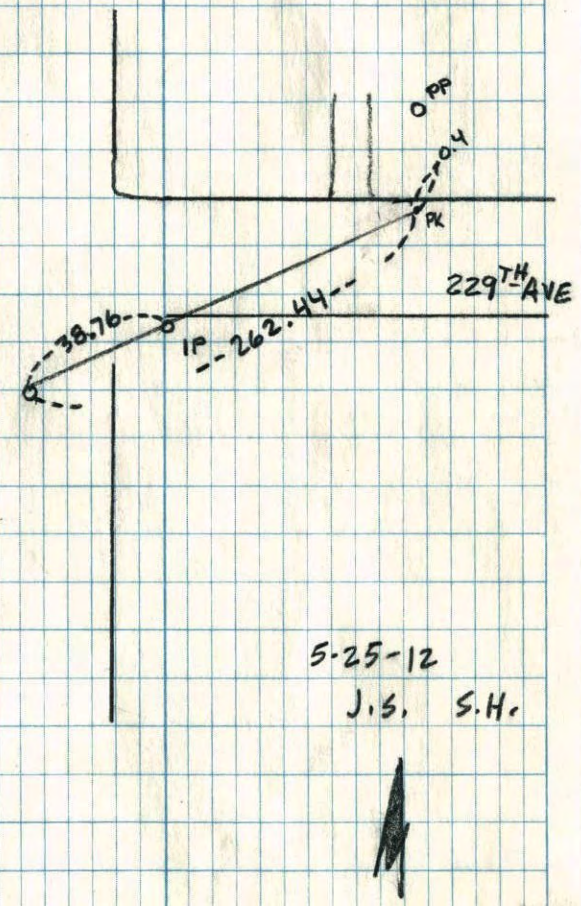

5-25-12

J.S. S.H.

CERTIFICATE OF LOCATION OF GOVERNMENT CORNER

County of Anoka State of Minnesota

Northwest Corner of Sec. 4 Township 33 Range 22

On the 27th day of February, 1961, the described corner was evidenced by a stone monument

and to perpetuate the location of said corner, at the exact location thereof, a permanent marker was placed consisting of a cast iron monument

AND on the ___ day of _____, ____, said permanent marker was _____

Updated reference ties are as shown below.

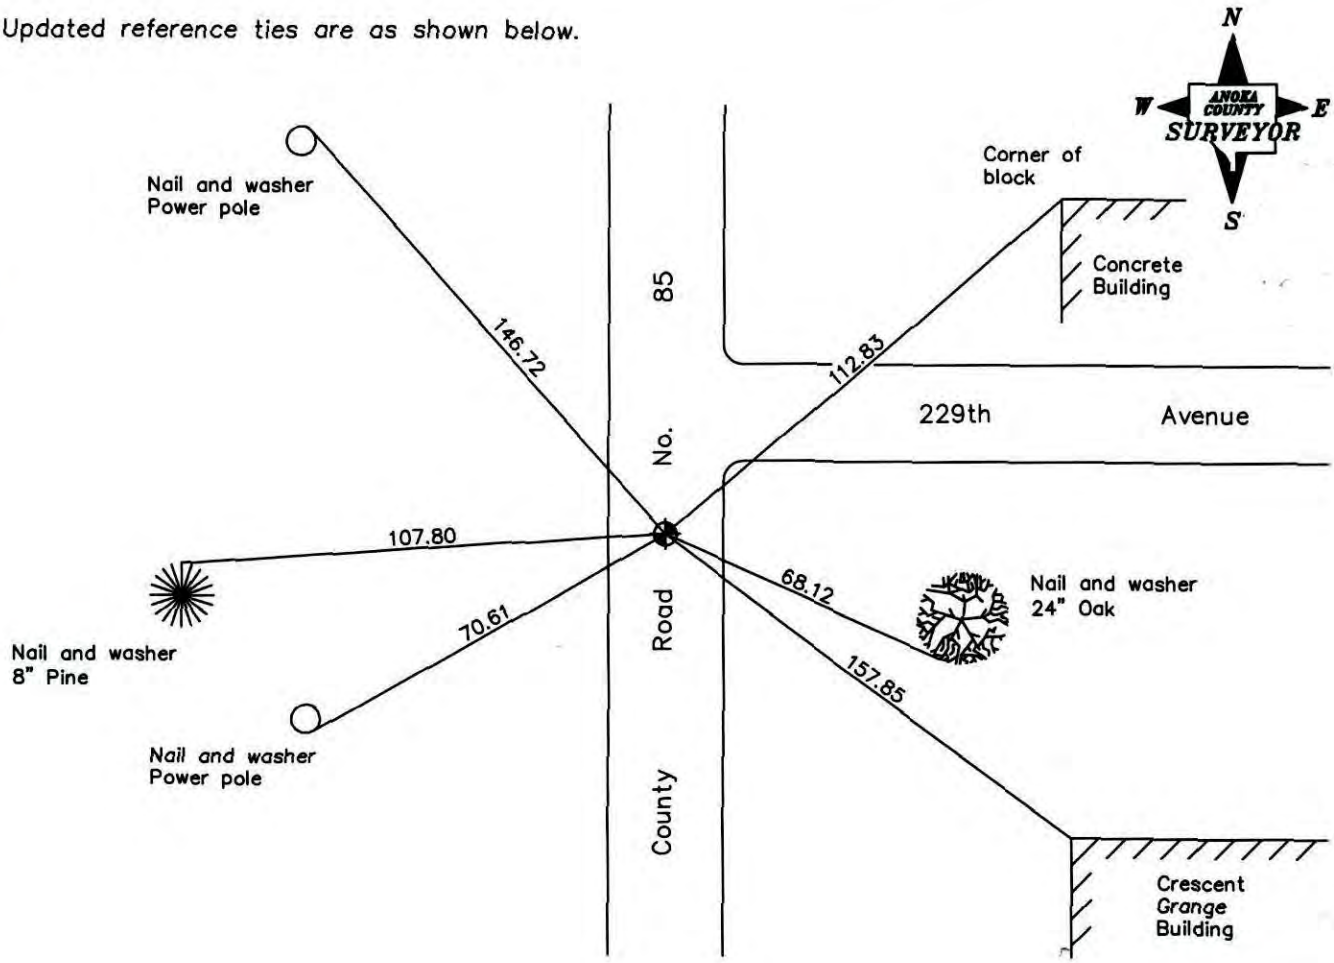

Revised date
6/16/93

N.A.D. 1983 Coordinates
(1996 Adjustment)

County Project Coordinates	
Northing	227474.1642
Easting	542740.0433
Date	6/05/03

I hereby certify that this United States public land survey monument record is correct and complete to the best of my knowledge and belief.

_____ Date _____

_____, Anoka County Surveyor

Minnesota License Number _____

CERTIFICATE OF LOCATION OF GOVERNMENT CORNER

County of Anoka State of Minnesota

NORTHWEST Corner of Sec. 4 Township 33 Range 22

I hereby certify that on the 27 day of FEB., 1961, I found the described corner which was evidenced by STONE

and I further certify that to perpetuate the location of said corner, I did, at the exact location thereof, place a permanent marker consisting of CAST IRON

which reference or witness monuments are located in the manner following:

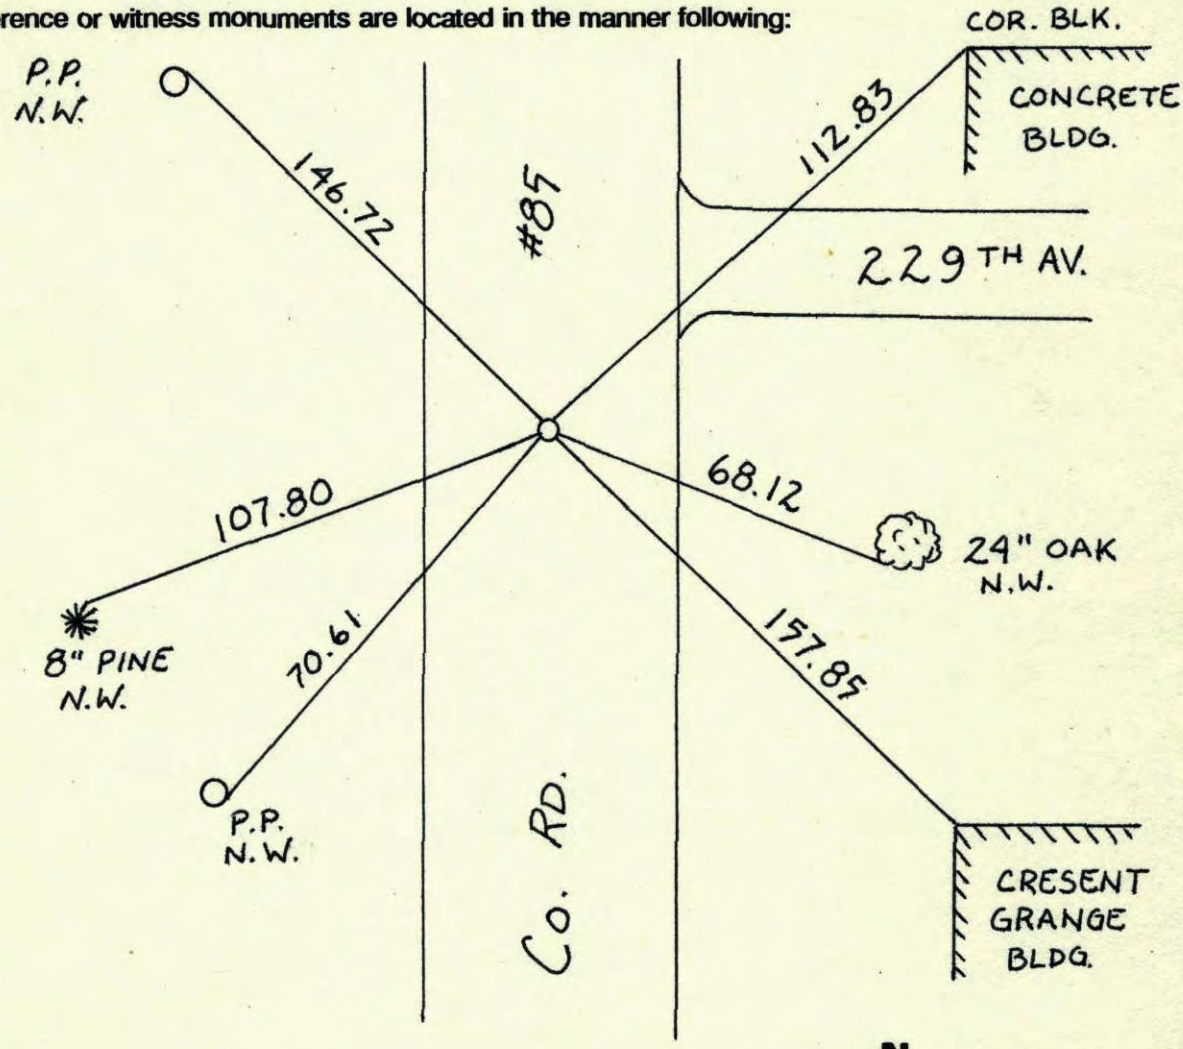

Revised date	Revised date	Revised date
6-16-93		

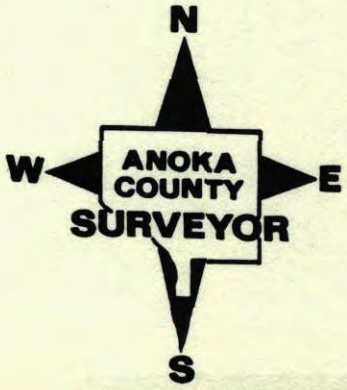

9

N.W. Cor. Sec. 4 - T33 - R22

Replace Broken Cast Iron. Down .5'±

REMOVED FOR CONST. AND RETIED
5-8-84 N. LARSON
B. GUETZKO
T. RIEMENSNIDER

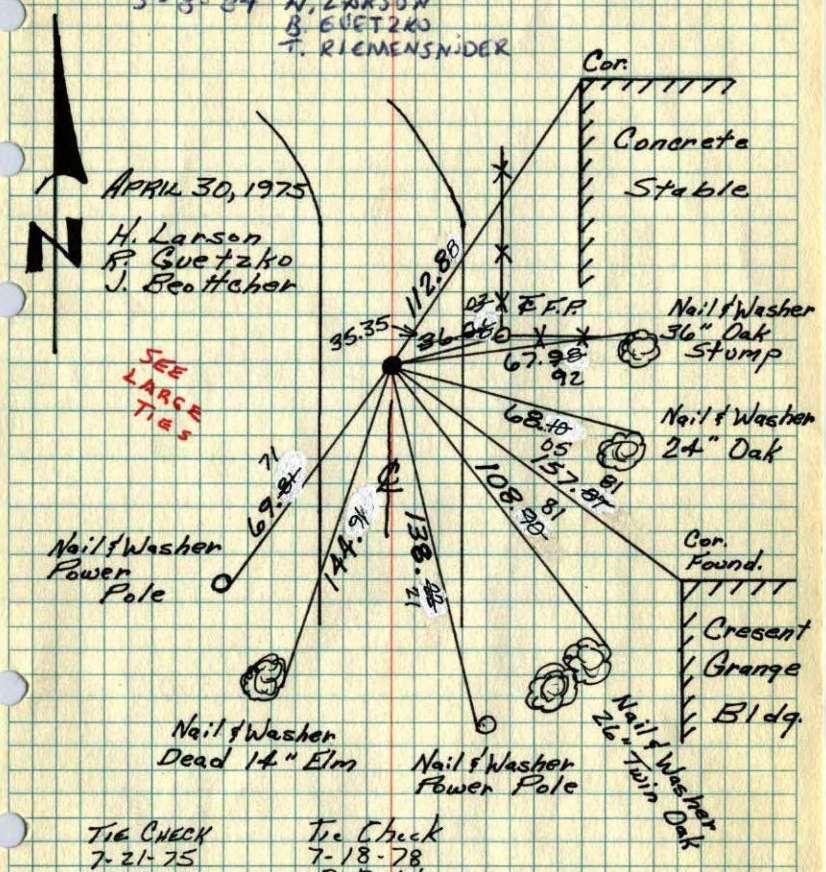

TIE CHECK
7-21-75
D. DAHL
B. SAWERUD

Tie Check
7-18-78
D. Dahl
B. Stephens

TIE CHECK
8-4-81
P. ROSS
P. HORNBY
G. NEFFINGER

TEMPERATURE CORRECTED AND HORIZONTALLY TAPED MEASUREMENTS

ROLAND W. ANDERSON
COUNTY SURVEYOR
ANOKA COUNTY, MINNESOTA

NW COR. SECTION 4 T33 R22

TOOK ADDITIONAL TIES AND REMOVED CAST IRON FOR CONSTRUCTION

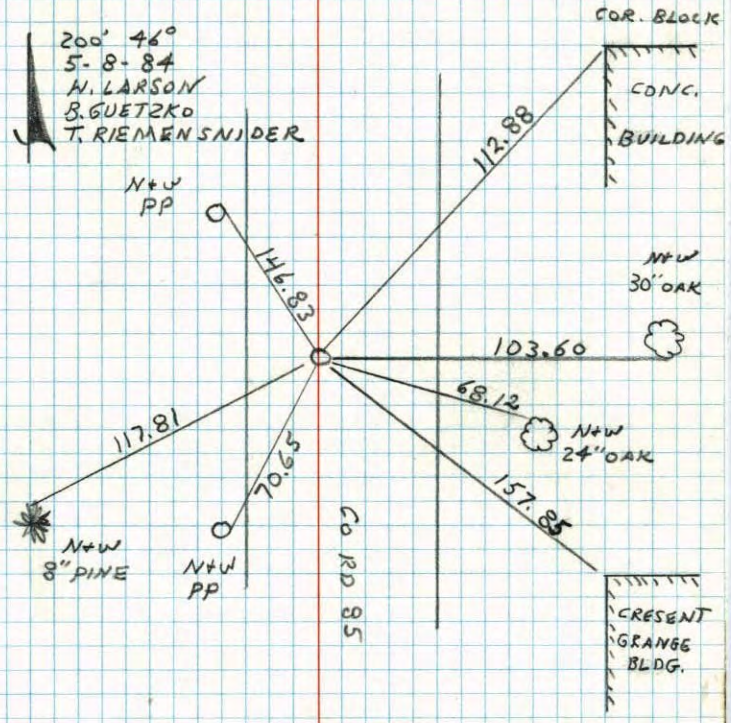

NO. 448 TELEDYNE

NW Cor. Sec. 4 T33 R22

Replaced broken cast iron. down .5'±

Using same ties

TAPE

4-30-75
H. Larson
B. Guteko
J. Bottcher

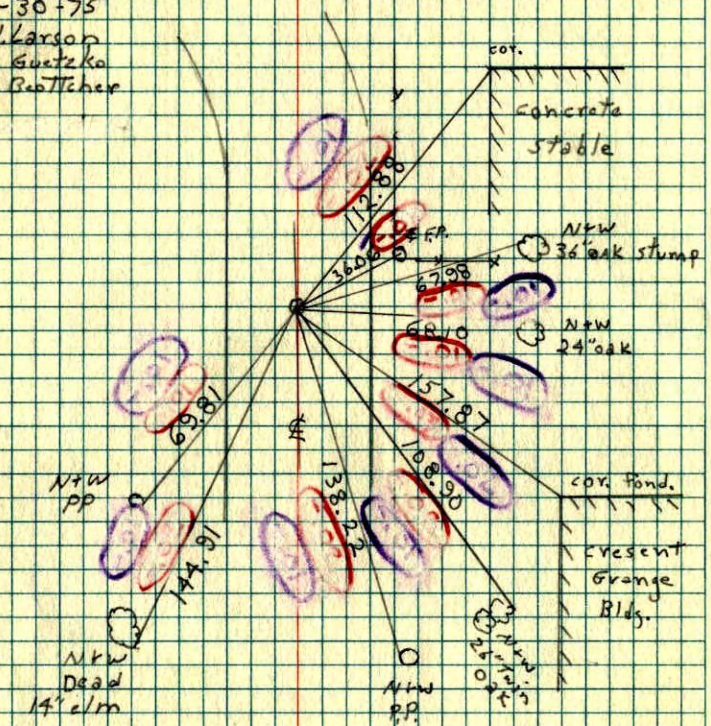

NW Cor Sec 4-33-22

Cast Iron Monument Over Stone

Down 0.1' in traveled ℄ of Dirt Road

July 8, 1980

R. Biren

J. Bottcher

B. Olson

#10-80°

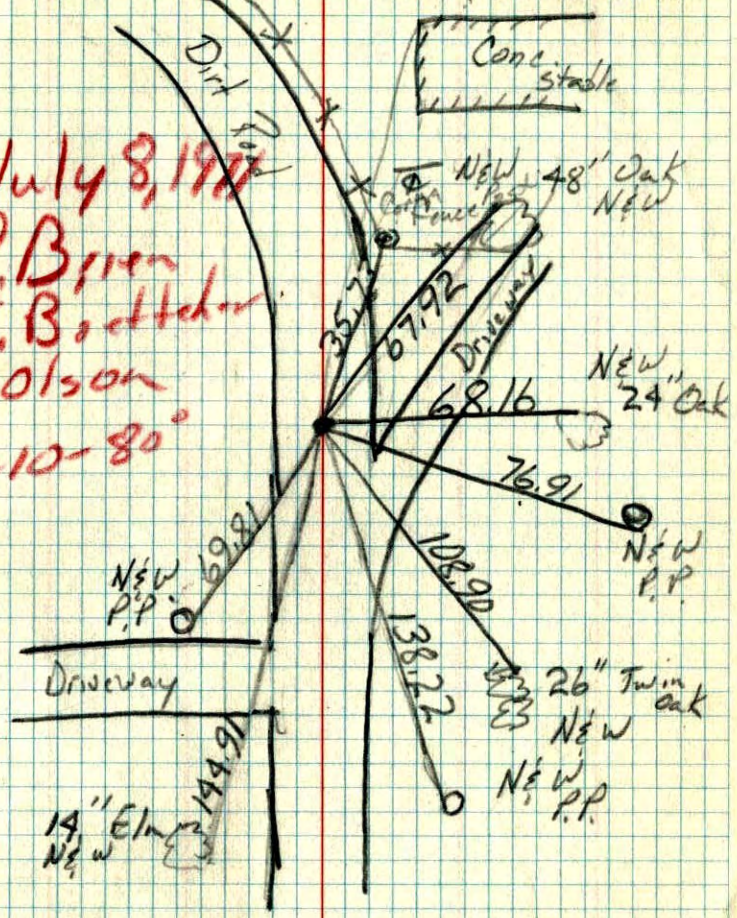

9

N.W. Cor. Sec. 4-33-22

CAST IRON MON. OVER STONE

DOWN 0.5'

IN DIRT ROAD

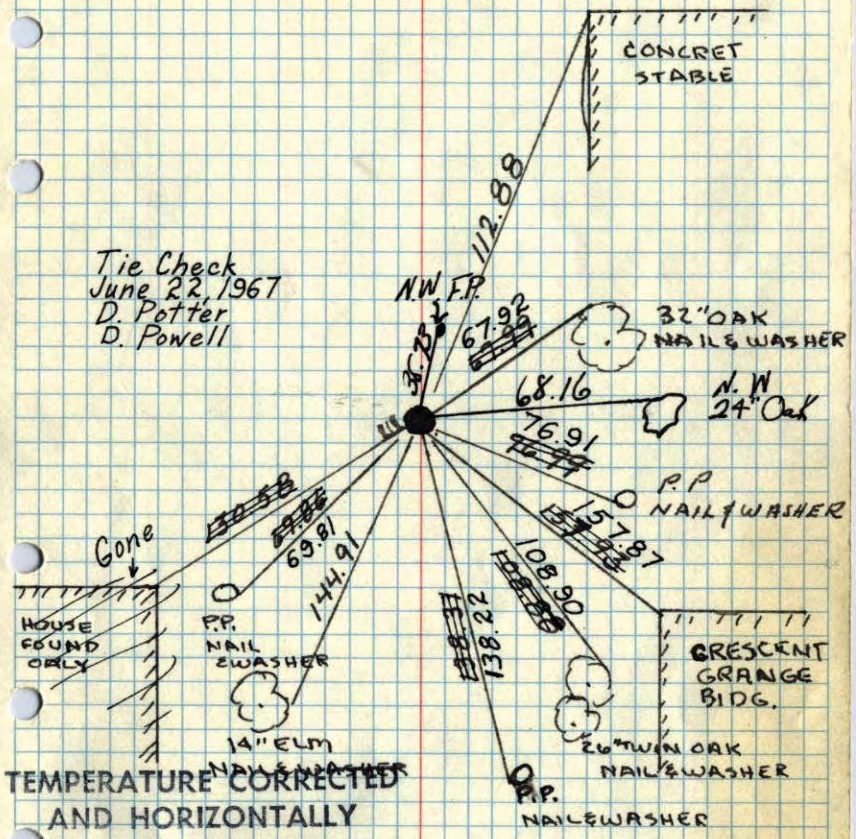

TEMPERATURE CORRECTED
AND HORIZONTALLY
TAPED MEASUREMENTS
27 Feb 1961
R. Freeman
M. Anderson

ROLAND W. ANDERSON
COUNTY SURVEYOR
ANOKA COUNTY, MINNESOTA

X

3

N.W. Cor. Sec. 4-33-22

CAST IRON MON. OVER STONE

DOWN ~~0.5'~~ 0.3'

IN DIRT ROAD

6/22/67
D. Potter
D. Powell
#7 74°F

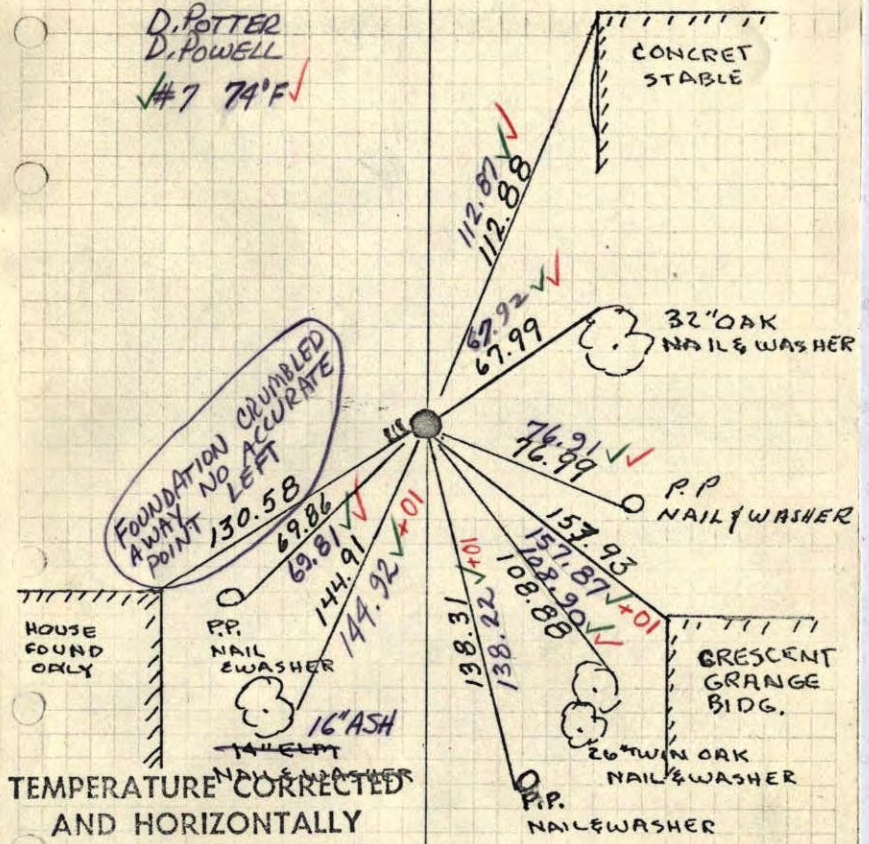

TEMPERATURE CORRECTED
AND HORIZONTALLY
TAPED MEASUREMENTS
27 Feb 1961
R. Freeman
M. Anderson

ROLAND W. ANDERSON
COUNTY SURVEYOR
ANOKA COUNTY, MINNESOTA

27 Feb 1961
Freeman Anderson
+47°
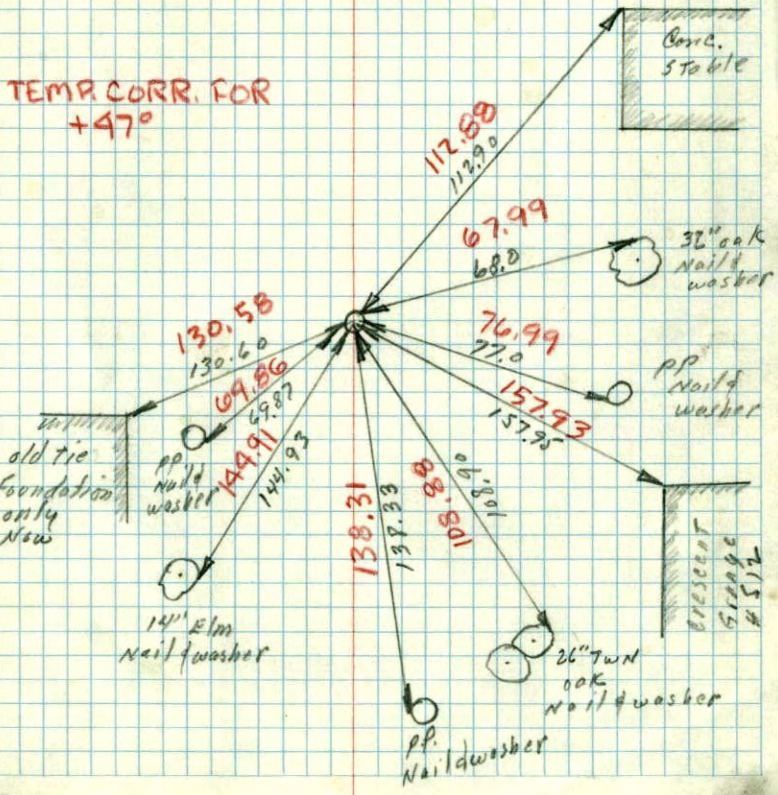
NW Cor Sec 4 - 33 - 32 - Linwood
Found Stone Mon. down 3.0' Found
from old HAC's Ties, But Found
No Conc. Mon. as per ties
Assum this to be same Stone Set
by County Surveyor Pratt in 1871
Set Cast iron Mon on top.