

# CERTIFICATE OF LOCATION OF GOVERNMENT CORNER

County of Anoka

State of Minnesota


Witness Corner of Sec. 3 Township 33 Range 22  
 (on north line of NW 1/4)

On the 5th day of May, 1976, the described corner was evidenced by area resurvey

and to perpetuate the location of said corner, at the exact location thereof, a permanent marker was placed consisting of a cast iron monument

AND on the 25th day of August, 2014, said permanent marker was found broken and was replaced with a solid cast iron monument. The ties were updated.

Updated reference ties are as shown below.

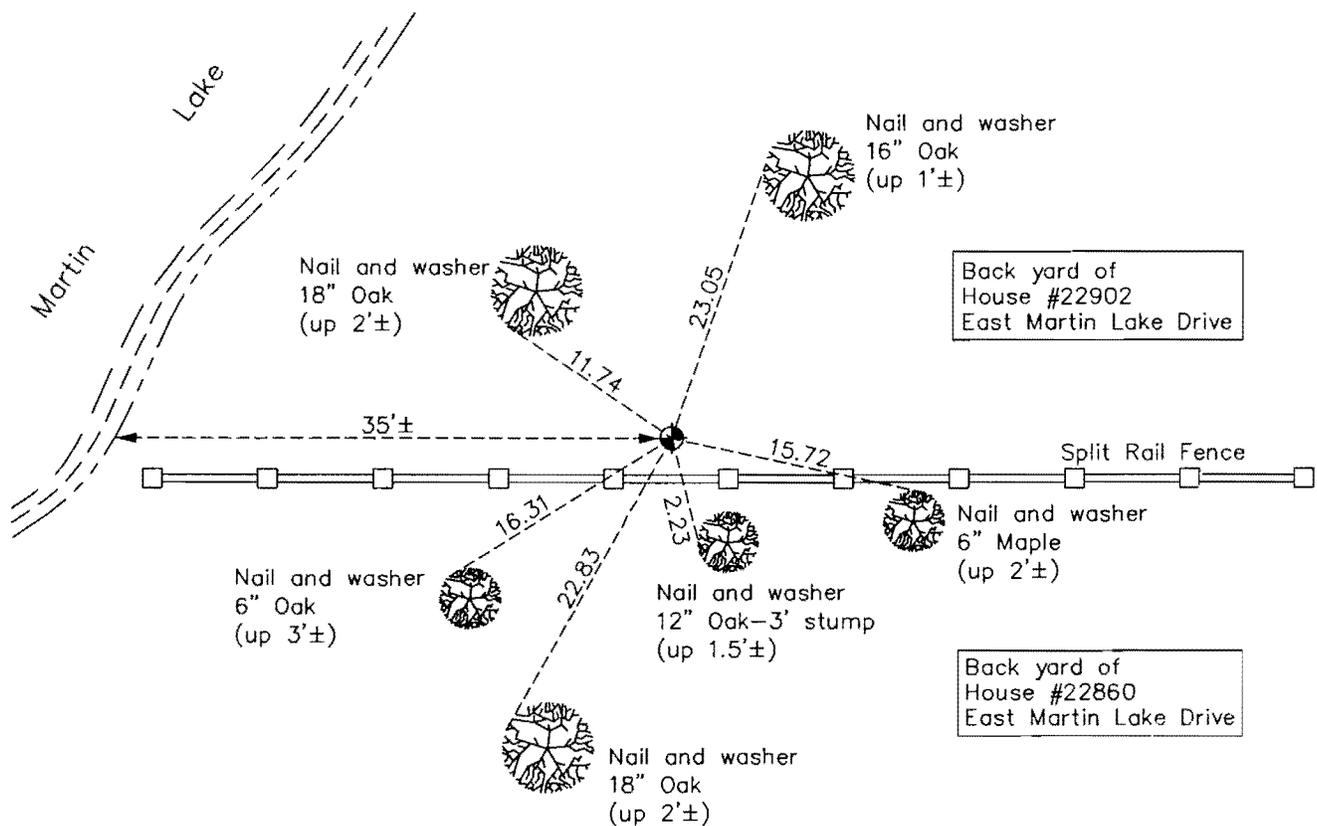

Back yard of House #22902 East Martin Lake Drive

Back yard of House #22860 East Martin Lake Drive

N

S

Revision Date

3/24/16

N.A.D. 1983 Coordinates  
(1996 Adjustment)

| County Project Coordinates |             |
|----------------------------|-------------|
| Northing                   | 227221.2942 |
| Easting                    | 548382.6690 |
| Date                       | 3/17/05     |

I hereby certify that this United States public land survey monument record is correct and complete to the best of my knowledge and belief.

*Larry D. Hoium* Date 3/24/16

Larry D. Hoium, Anoka County Surveyor

Minnesota License Number 18165