

CERTIFICATE OF LOCATION OF GOVERNMENT CORNER

County of Anoka

State of Minnesota

Witness Corner of Sec. 9 Township 33 Range 22



(on north line of NE 1/4)

On the 1st day of April, 1971, the described corner was evidenced by area resurvey

and to perpetuate the location of said corner, at the exact location thereof, a permanent marker was placed consisting of a cast iron monument with a sign and post on the north side

AND on the 25th day of November, 2013, said permanent marker was found and the ties were updated

Updated reference ties are as shown below.

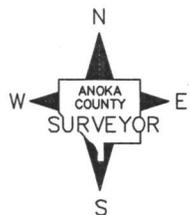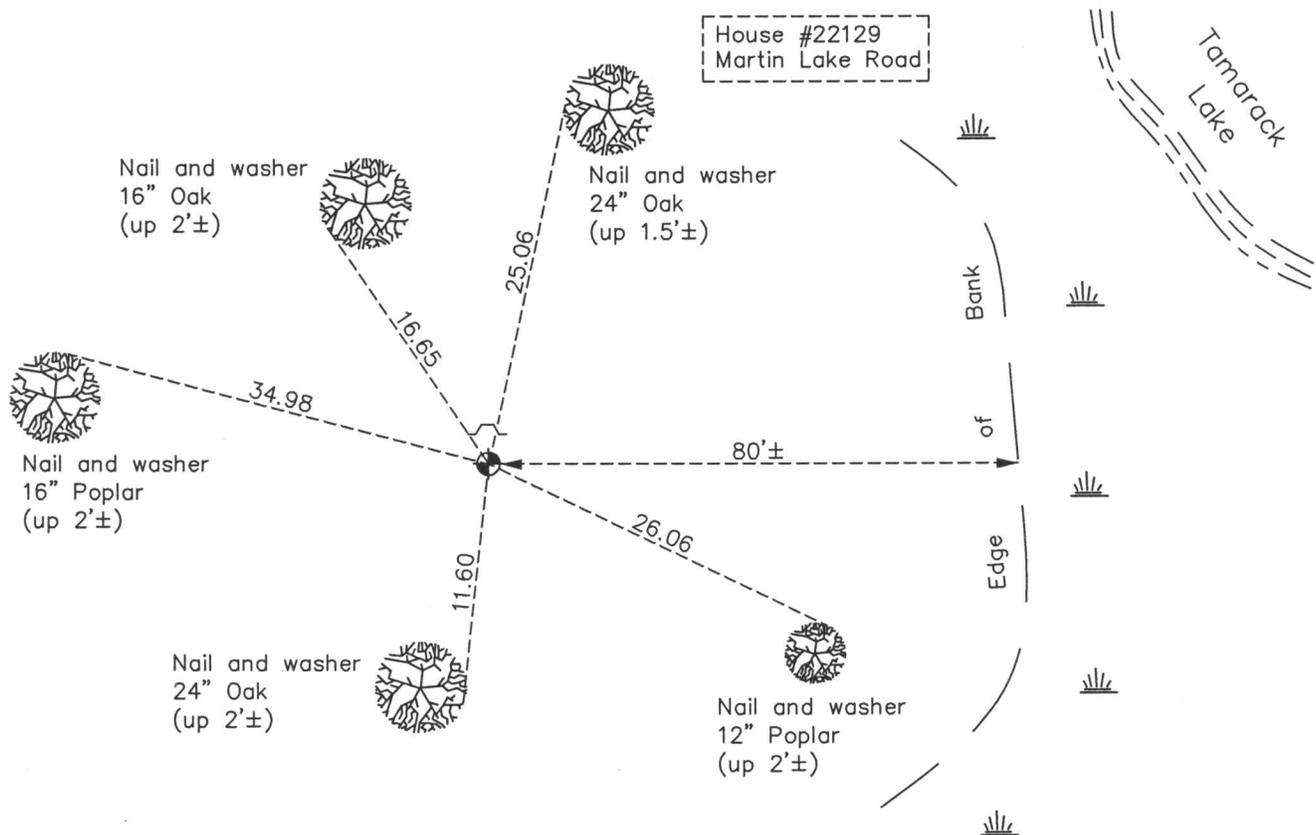

Revision Date

8/18/15

N.A.D. 1983 Coordinates
(1996 Adjustment)

County Project Coordinates	
Northing	222084.0626
Easting	546484.7568
Date	2/09/05

I hereby certify that this United States public land survey monument record is correct and complete to the best of my knowledge and belief.

Larry D. Hoium Date 8/18/15
 _____, Anoka County Surveyor
 Minnesota License Number 18165