

CERTIFICATE OF LOCATION OF GOVERNMENT CORNER

County of Anoka

State of Minnesota

Witness Corner of Sec. 9 Township 33 Range 22



(on east line of NE 1/4)

On the 25th day of January, 1973, the described corner was evidenced by area resurvey

and to perpetuate the location of said corner, at the exact location thereof, a permanent marker was placed consisting of a cast iron monument

AND on the 25th day of November, 2013, said permanent marker was found with a sign and post on the north side. The ties were updated.

Updated reference ties are as shown below.

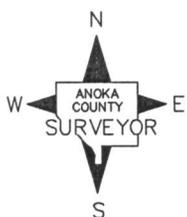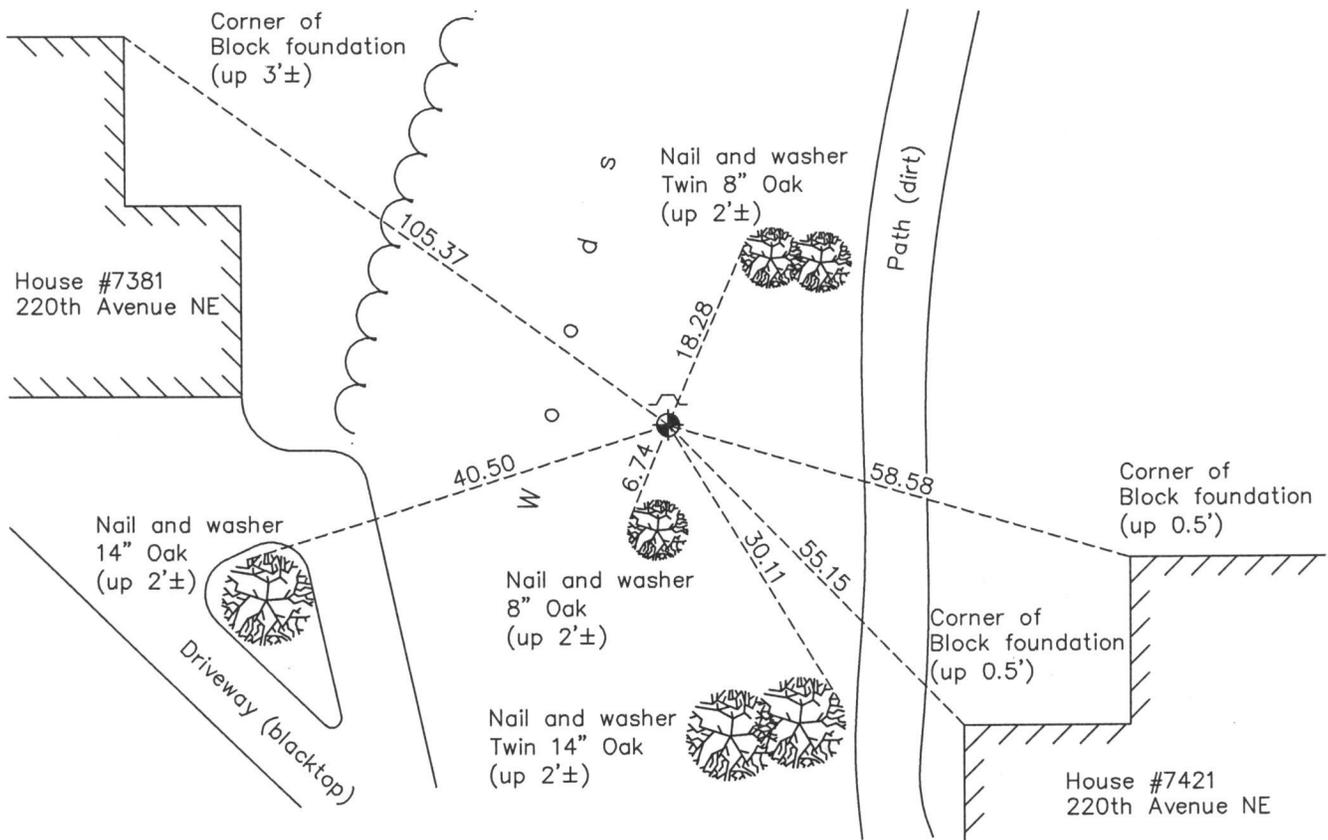

Revision Date
8/26/15

N.A.D. 1983 Coordinates
(1996 Adjustment)

County Project Coordinates	
Northing	<u>221403.7810</u>
Easting	<u>547866.6880</u>
Date	<u>4/07/04</u>

I hereby certify that this United States public land survey monument record is correct and complete to the best of my knowledge and belief.

Larry D. Hoium Date 8/26/15

Larry D. Hoium, Anoka County Surveyor

Minnesota License Number 18165