

CERTIFICATE OF LOCATION OF GOVERNMENT CORNER

County of Anoka

State of Minnesota


East 1/4 Corner of Sec. 9 Township 33 Range 22

On the 25th day of January, 1972, the described corner was evidenced by area resurvey

and to perpetuate the location of said corner, at the exact location thereof, a permanent marker was placed consisting of a cast iron monument with a sign and post on the north side

AND on the 6th day of December, 2013, said permanent marker was found and the ties were updated

Updated reference ties are as shown below.

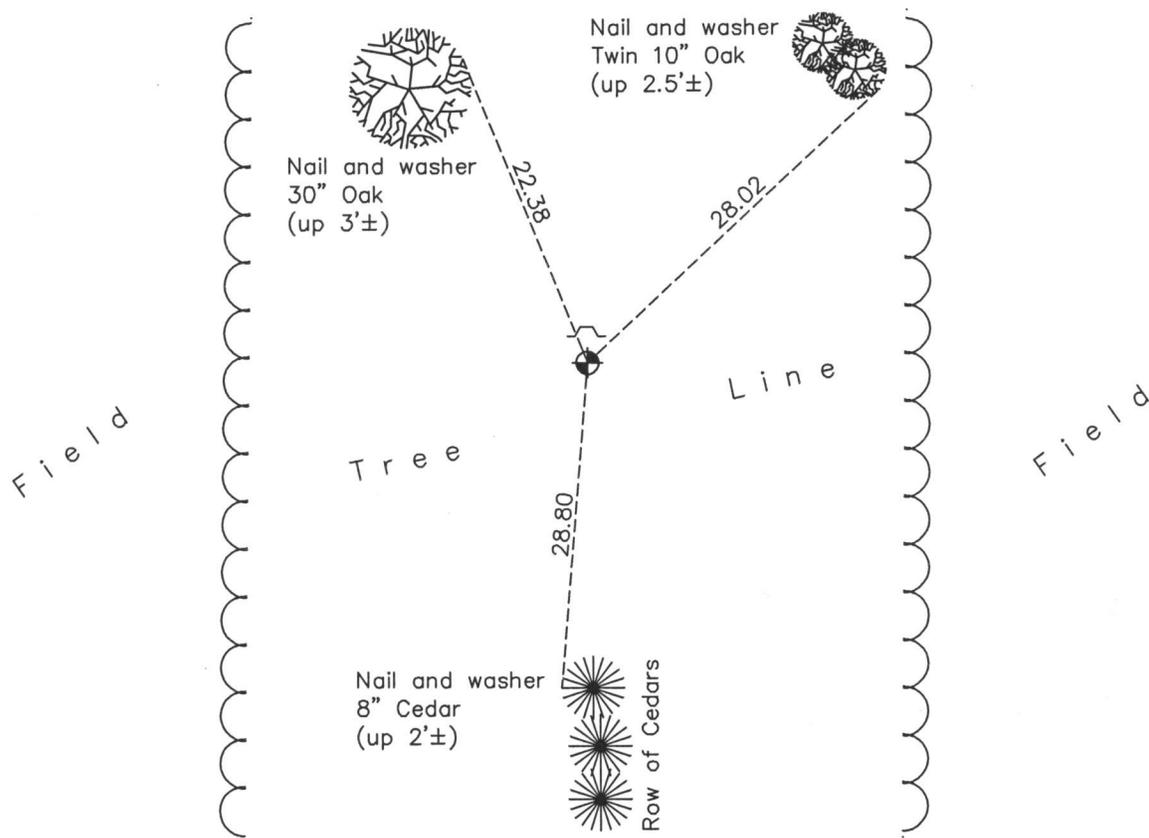

N

W ANOKA COUNTY SURVEYOR E

S

Revision Date

8/26/15

N.A.D. 1983 Coordinates
(1996 Adjustment)

County Project Coordinates	
Northing	219366.9110
Easting	547688.8950
Date	4/08/04

I hereby certify that this United States public land survey monument record is correct and complete to the best of my knowledge and belief.

Date 8/26/15

Larry D. Hoium, Anoka County Surveyor
 Minnesota License Number 18165