

CERTIFICATE OF LOCATION OF GOVERNMENT CORNER

County of Anoka

State of Minnesota


South 1/4 Corner of Sec. 12 Township 33 Range 22

On the 28th day of January, 1974, the described corner was evidenced by a granite monument

and to perpetuate the location of said corner, at the exact location thereof, a permanent marker was placed consisting of the same granite monument with a sign and post on the north side

AND on the 13th day of January, 2014, said permanent marker was found with an angle iron in concrete in between the monument and sign and post. The ties were updated.

Updated reference ties are as shown below.

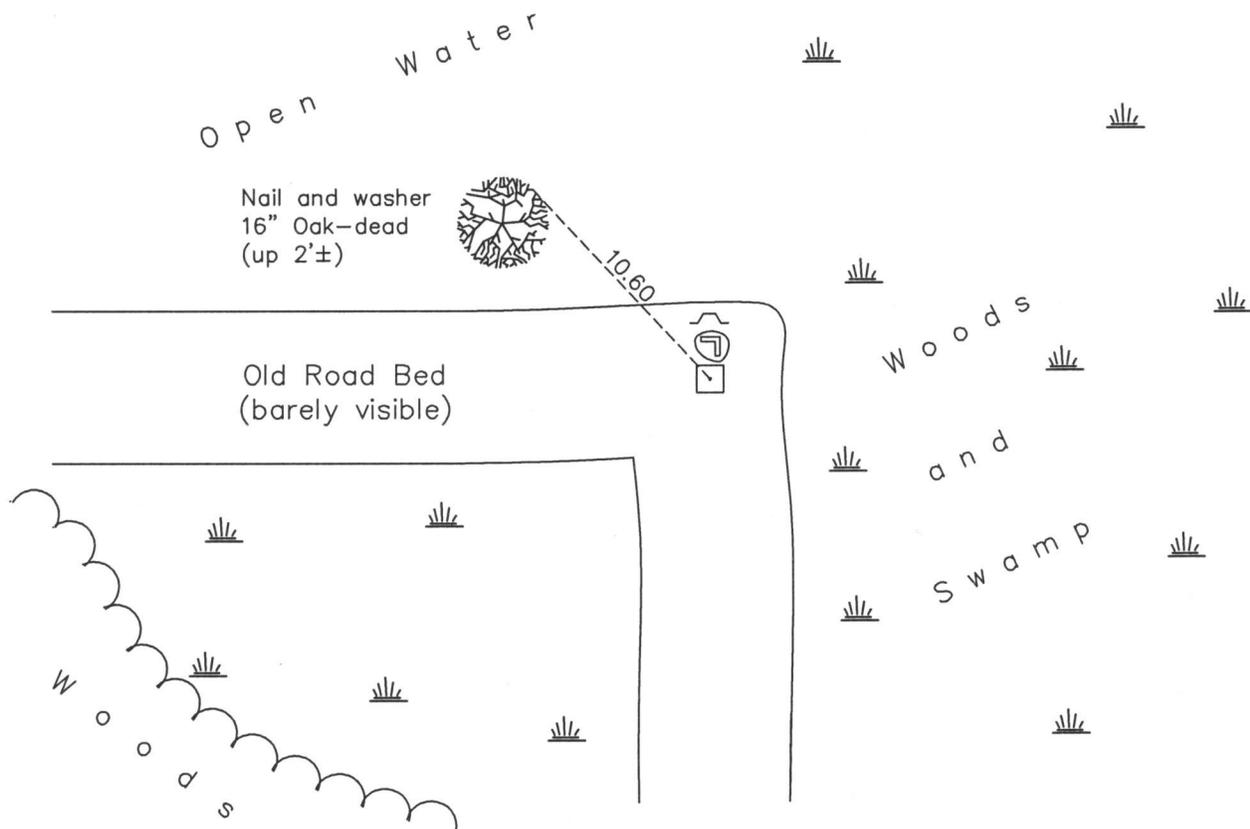

Revision Date
8/27/15

N.A.D. 1983 Coordinates
(1996 Adjustment)

County Project Coordinates	
Northing	<u>216579.9792</u>
Easting	<u>560902.7647</u>
Date	<u>3/22/05</u>

I hereby certify that this United States public land survey monument record is correct and complete to the best of my knowledge and belief.

Larry D. Hoium Date 8/27/15

Larry D. Hoium, Anoka County Surveyor

Minnesota License Number 18165