

CERTIFICATE OF LOCATION OF GOVERNMENT CORNER

County of Anoka

State of Minnesota


South 1/4 Corner of Sec. 7 Township 33 Range 22

On the 28th day of December, 1961, the described corner was evidenced by a well point

and to perpetuate the location of said corner, at the exact location thereof, a permanent marker was placed consisting of the same well point

AND on the ___ day of _____, _____, said permanent marker was _____

Updated reference ties are as shown below.

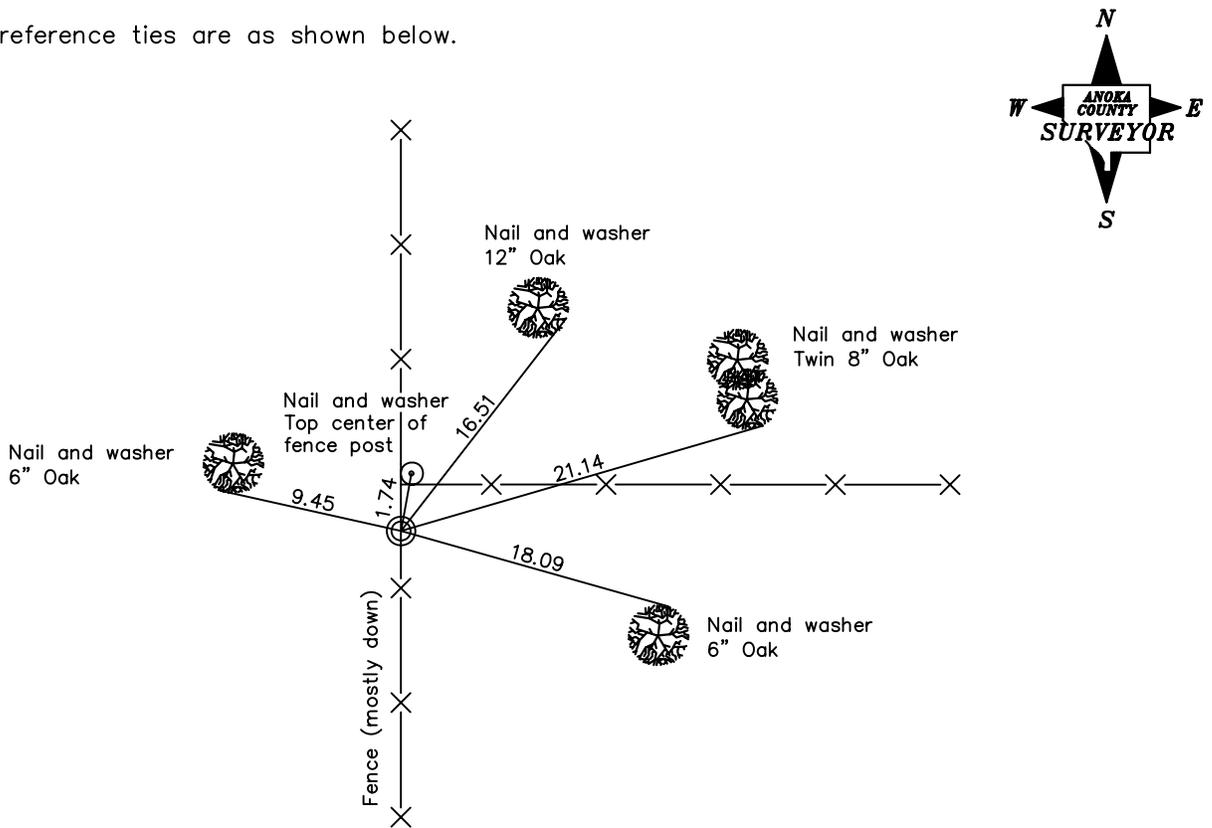

Revised date

10/18/90
6/30/93

N.A.D. 1983 Coordinates
(1996 Adjustment)

County Project Coordinates
Northing <u>216740.1898</u>
Easting <u>534096.5567</u>
Date <u>5/11/04</u>

I hereby certify that this United States public land survey monument record is correct and complete to the best of my knowledge and belief.

_____ Date _____
 _____, Anoka County Surveyor
 Minnesota License Number _____