

CERTIFICATE OF LOCATION OF GOVERNMENT CORNER

County of Anoka

State of Minnesota



Southeast Corner of Sec. 22 Township 33 Range 22

On the 10th day of September, 1975, the described corner was evidenced by a concrete monument with a steel post

and to perpetuate the location of said corner, at the exact location thereof, a permanent marker was placed consisting of the same concrete monument with steel post

AND on the 18th day of February, 2016, said permanent marker was replaced w/ 2"X8' sq. steel Telespar mont. w/ 'County Surveyor' cap & punchmark. Ties updated, sign & post north side.

Updated reference ties are as shown below.

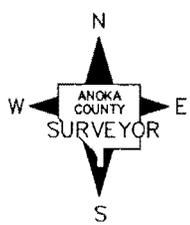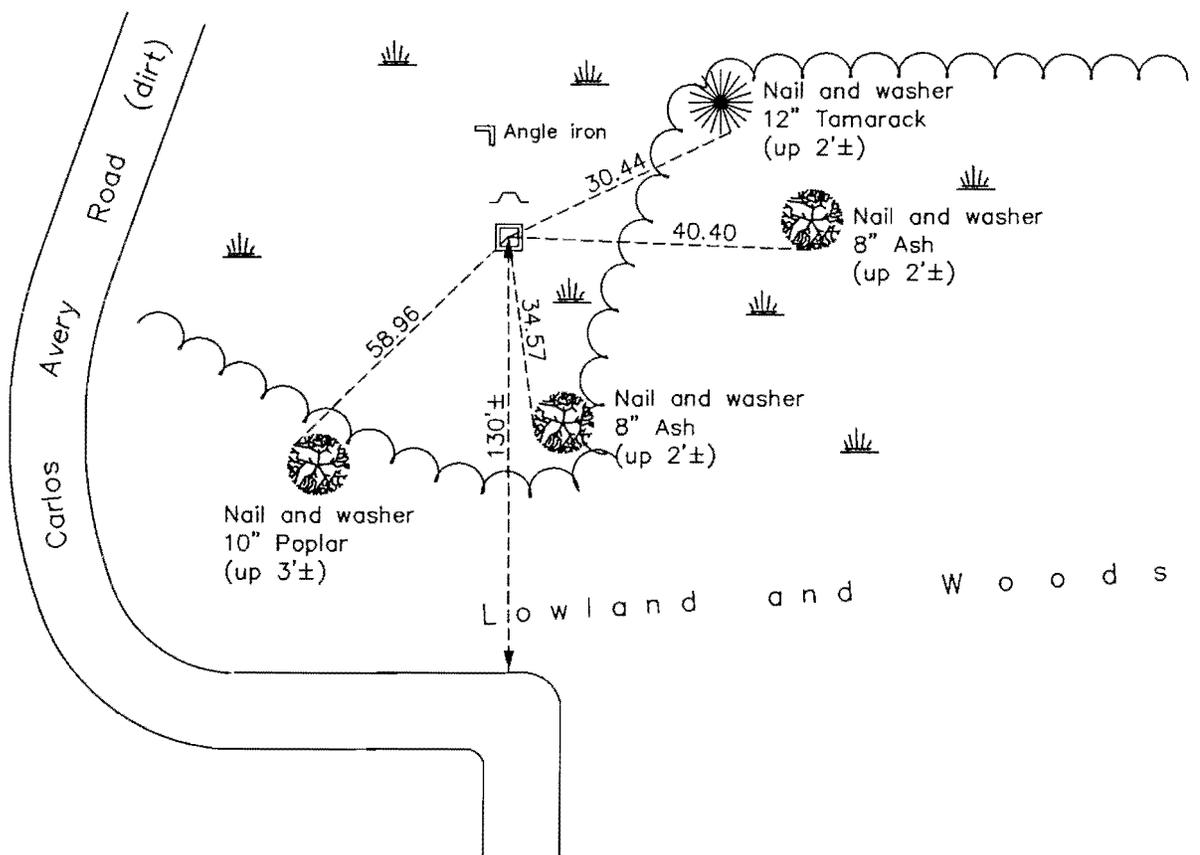

Revision Date
3/24/16

N.A.D. 1983 Coordinates
(1996 Adjustment)

County Project Coordinates	
Northing	206041.7561
Easting	552931.7478
Date	5/25/04

I hereby certify that this United States public land survey monument record is correct and complete to the best of my knowledge and belief.

Larry D. Hoium Date 3/24/16
 Larry D. Hoium, Anoka County Surveyor
 Minnesota License Number 18165