

CERTIFICATE OF LOCATION OF GOVERNMENT CORNER

County of Anoka

State of Minnesota



Northeast Corner of Sec. 30 Township 33 Range 22

On the 23rd day of August, 1966, the described corner was evidenced by an iron pipe
set by N.C. Hoium

and to perpetuate the location of said corner, at the exact location thereof, a permanent marker
 was placed consisting of a cast iron monument down 0.5'±

AND on the 23rd day of April, 2014, said permanent marker was found down 1'± and
the ties were updated

Updated reference ties are as shown below.

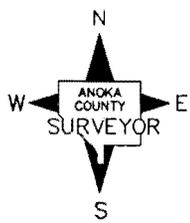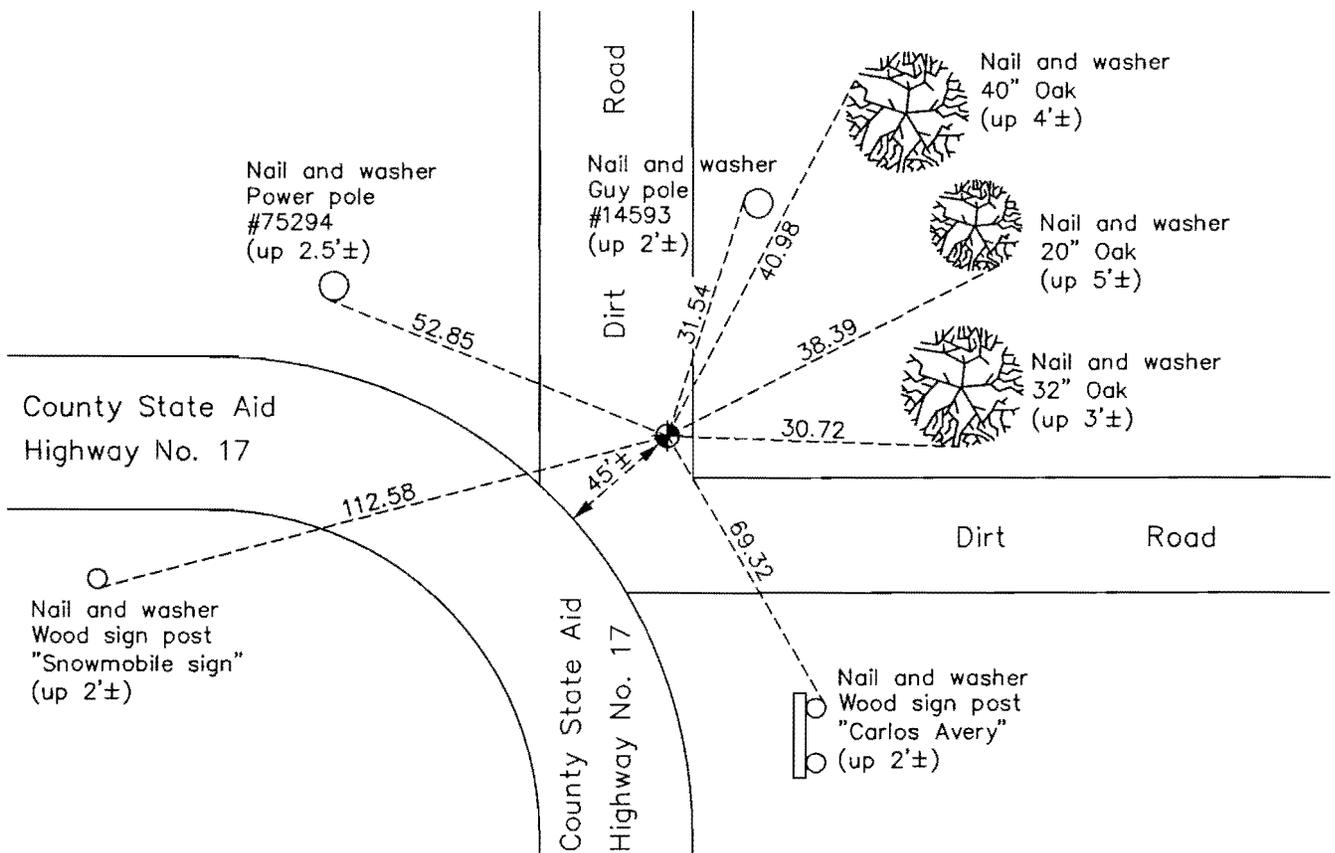

Revision Date

3/25/16

N.A.D. 1983 Coordinates
(1996 Adjustment)

County Project Coordinates	
Northing	206143.4410
Easting	536931.6409
Date	7/01/03

I hereby certify that this United States public land survey monument record is correct and complete to the best of my knowledge and belief.

Larry D. Hoium Date 3/25/16

Larry D. Hoium, Anoka County Surveyor
 Minnesota License Number 18165