

# CERTIFICATE OF LOCATION OF GOVERNMENT CORNER

County of Anoka

State of Minnesota


## North 1/4 Corner of Sec. 30 Township 33 Range 22

On the 23rd day of August, 1966, the described corner was evidenced by an iron pipe set by N.C. Hoium

and to perpetuate the location of said corner, at the exact location thereof, a permanent marker was placed consisting of a cast iron monument

AND on the 6th day of October, 2014, said permanent marker was found and raised to flush with the surface and the ties were updated

Updated reference ties are as shown below.

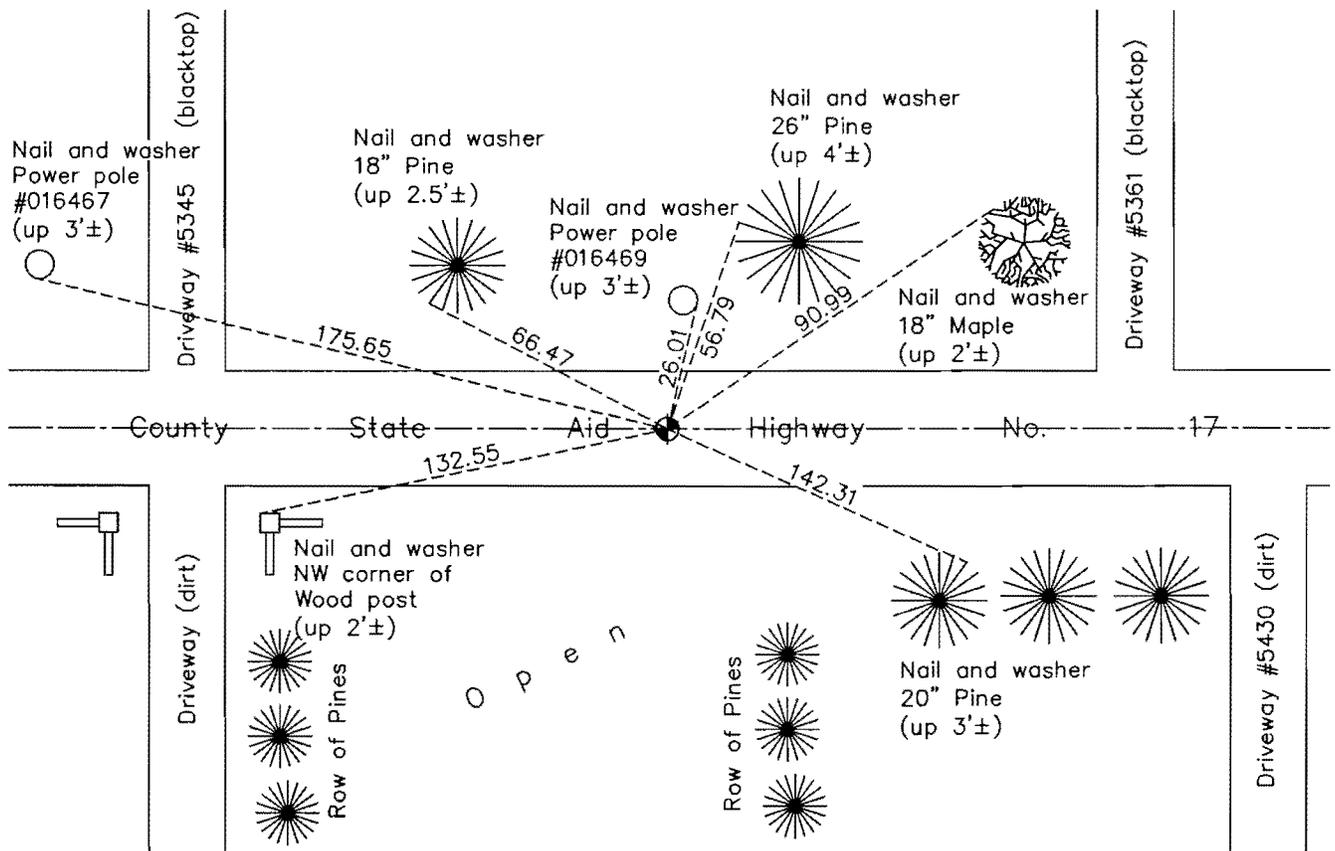

N

S

Revision Date

3/25/16

N.A.D. 1983 Coordinates  
(1996 Adjustment)

County Project Coordinates	
Northing	206155.3437
Easting	534272.2630
Date	7/02/03

I hereby certify that this United States public land survey monument record is correct and complete to the best of my knowledge and belief.

Date 3/25/16

Larry D. Hoium, Anoka County Surveyor  
 Minnesota License Number 18165