

CERTIFICATE OF LOCATION OF GOVERNMENT CORNER

County of Anoka

State of Minnesota


East 1/4 Corner of Sec. 26 Township 33 Range 22

On the 26th day of August, 1968, the described corner was evidenced by a 1" iron pipe and Don Hult ties

and to perpetuate the location of said corner, at the exact location thereof, a permanent marker was placed consisting of a cast iron monument

AND on the 7th day of November, 2014, said permanent marker was found broken and down 1'± leaning NE'y. Set new CIM on top of found mont. using GPS coord.'s. Ties were updated.

Updated reference ties are as shown below.

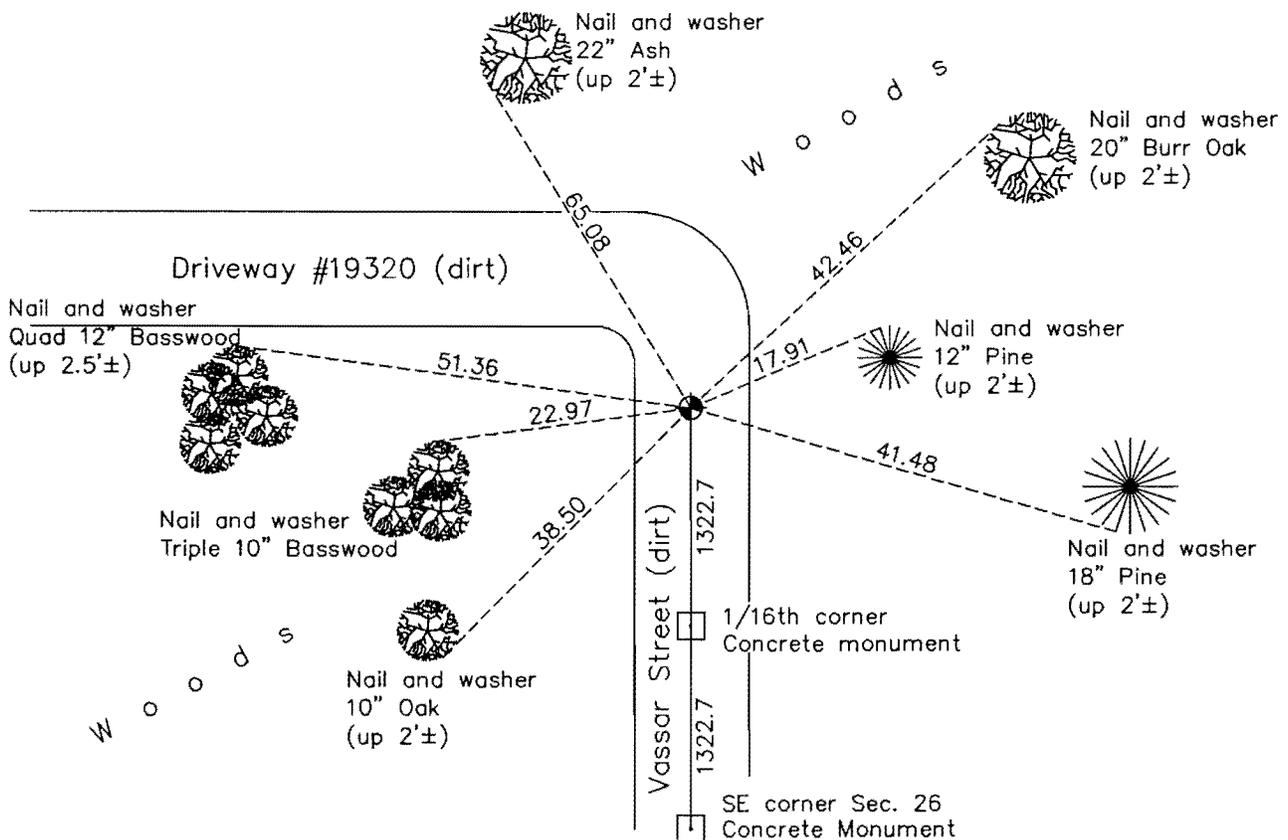

ANOKA COUNTY SURVEYOR

Revision Date

4/11/16

N.A.D. 1983 Coordinates
(1996 Adjustment)

County Project Coordinates	
Northing	203459.5232
Easting	558254.5868
Date	5/25/04

I hereby certify that this United States public land survey monument record is correct and complete to the best of my knowledge and belief.

Date 4/11/16

Larry D. Hoium
 Anoka County Surveyor

Minnesota License Number 18165