

CERTIFICATE OF LOCATION OF GOVERNMENT CORNER

County of Anoka

State of Minnesota



North 1/4 Corner of Sec. 36 Township 33 Range 22

On the 10th day of September, 1968, the described corner was evidenced by a 3/4" iron pipe set by Don Hult

and to perpetuate the location of said corner, at the exact location thereof, a permanent marker was placed consisting of a cast iron monument

AND on the 23rd day of October, 2014, said permanent marker was found down 1.6'± and the top 1/2 of a cast iron monument was set on top of found monument. Ties were updated.

Updated reference ties are as shown below.

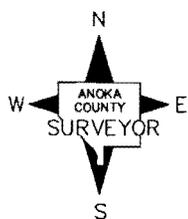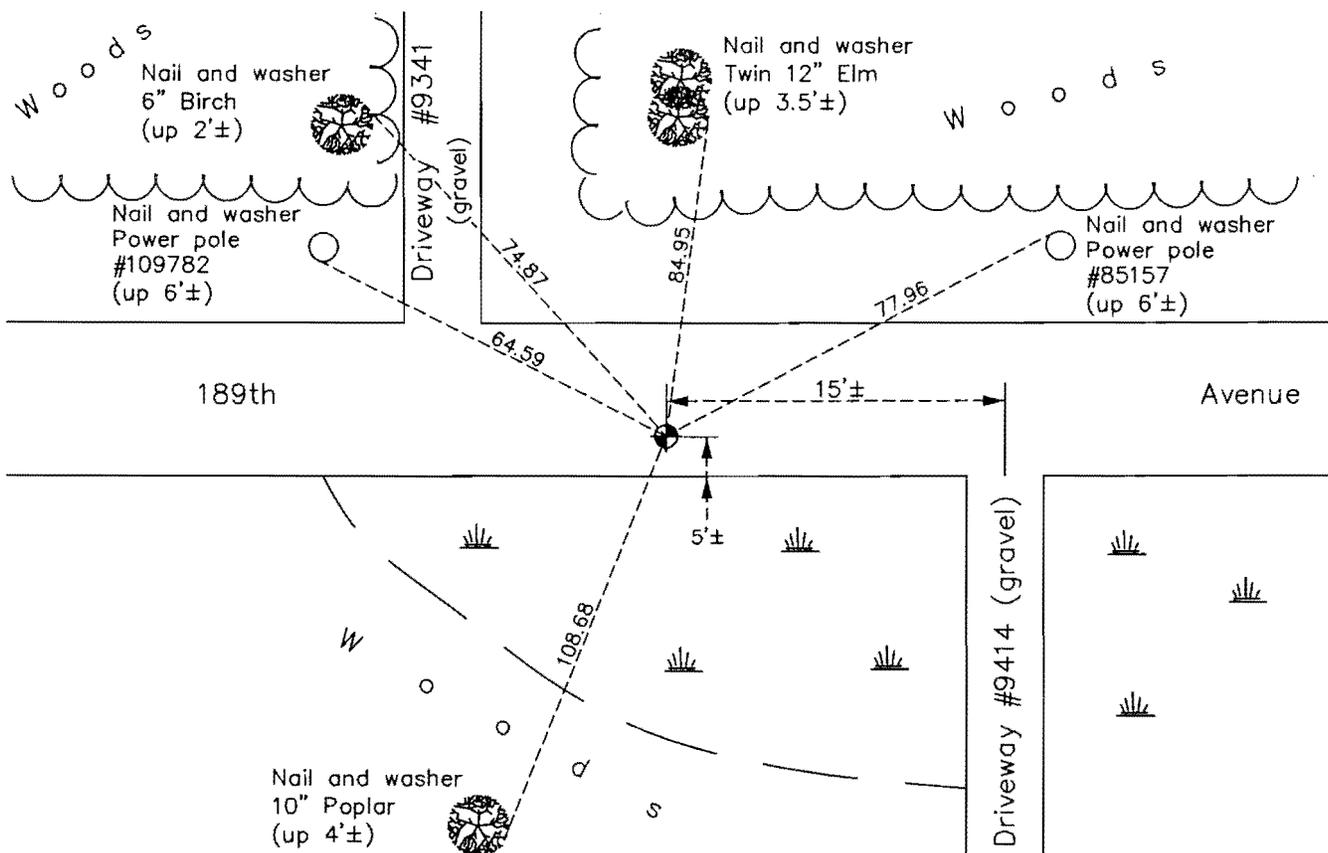

Revision Date
4/11/16

N.A.D. 1983 Coordinates
(1996 Adjustment)

County Project Coordinates	
Northing	200746.9564
Easting	560920.4343
Date	7/02/03

I hereby certify that this United States public land survey monument record is correct and complete to the best of my knowledge and belief.

Larry D. Hoium Date 4/11/16

Larry D. Hoium, Anoka County Surveyor
Minnesota License Number 18165