

# CERTIFICATE OF LOCATION OF GOVERNMENT CORNER

County of Anoka

State of Minnesota



## South 1/4 Corner of Sec. 30 Township 33 Range 22

On the 8th day of December, 1967, the described corner was evidenced by area resurvey

and to perpetuate the location of said corner, at the exact location thereof, a permanent marker was placed consisting of a cast iron monument

AND on the 1st day of October, 2014, said permanent marker was reset after road construction and position was verified using VRS GPS methods. Ties were updated.

Updated reference ties are as shown below.

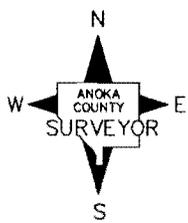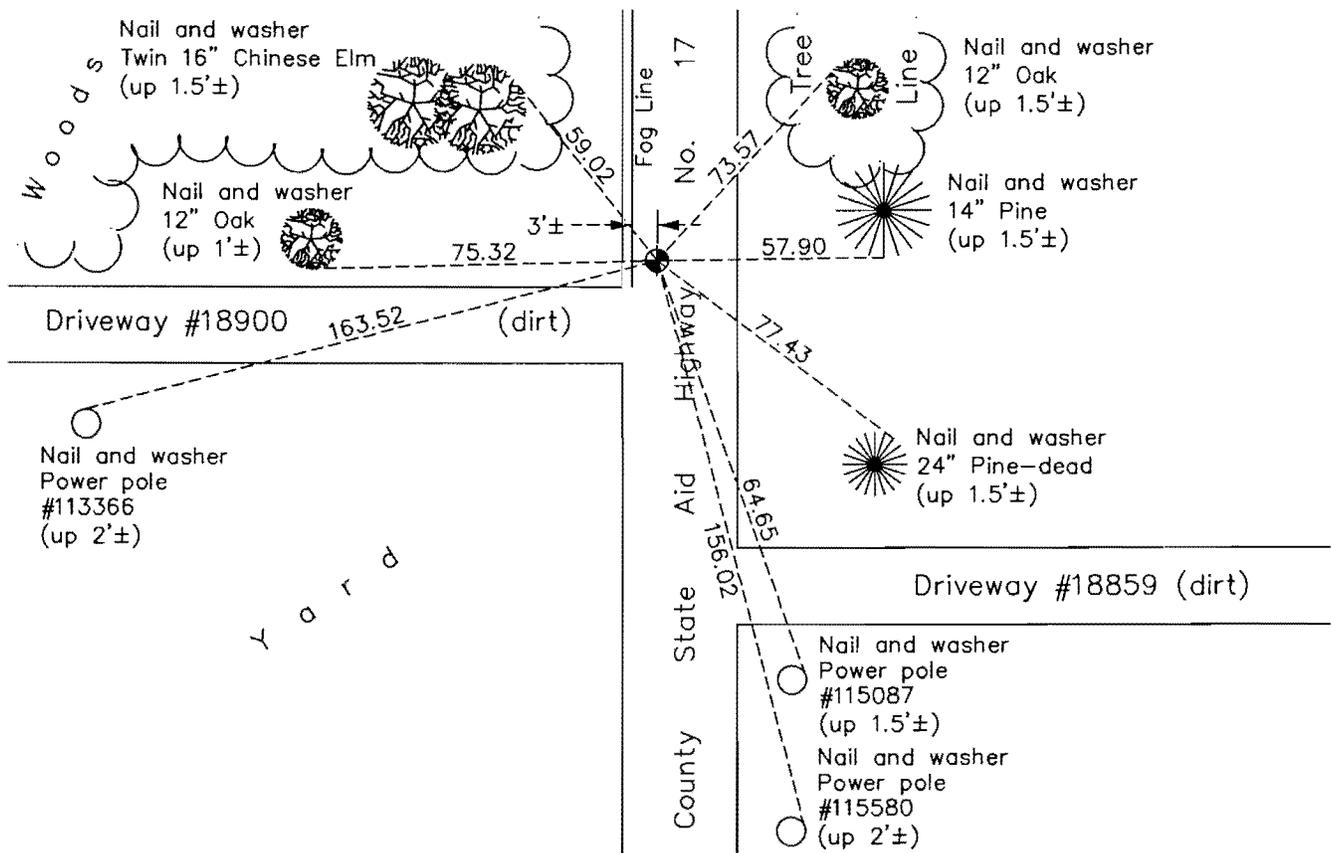

Revision Date  
3/25/16

N.A.D. 1983 Coordinates  
(1996 Adjustment)

County Project Coordinates	
Northing	200859.0836
Easting	534480.0245
Date	7/01/03

I hereby certify that this United States public land survey monument record is correct and complete to the best of my knowledge and belief.

*Larry D. Hoium* Date 3/25/16

Larry D. Hoium, Anoka County Surveyor

Minnesota License Number 18165