

CERTIFICATE OF LOCATION OF GOVERNMENT CORNER

County of Anoka

State of Minnesota



West 1/4 Corner of Sec. 35 Township 33 Range 22

On the 28th day of October, 1971, the described corner was evidenced by a concrete monument

and to perpetuate the location of said corner, at the exact location thereof, a permanent marker was placed consisting of the same concrete monument

AND on the 24th day of October, 2014, said permanent marker was Replaced w/ 2"X6.5' sq. steel Telespar mont. w/ 'County Surveyor' cap & punchmark. Sign & post on east side. Updated ties.

Updated reference ties are as shown below.

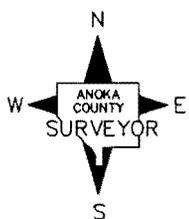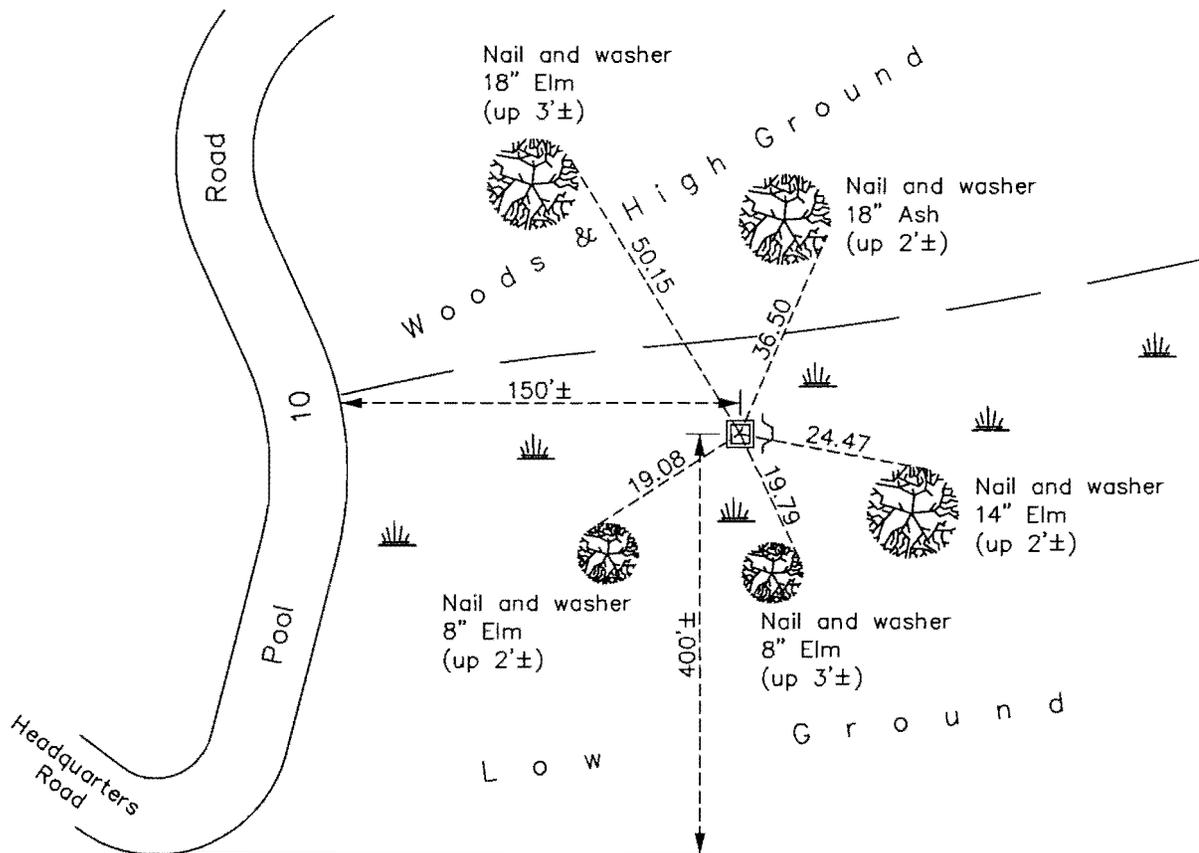

Revision Date

4/06/16

N.A.D. 1983 Coordinates
(1996 Adjustment)

County Project Coordinates

Northing 198133.6045

Easting 553022.0571

Date 5/04/05

I hereby certify that this United States public land survey monument record is correct and complete to the best of my knowledge and belief.

Larry D. Hoium Date 4/06/16

Larry D. Hoium, Anoka County Surveyor

Minnesota License Number 18165