

CERTIFICATE OF LOCATION OF GOVERNMENT CORNER

County of Anoka State of Minnesota

Northeast Corner of Sec. 25 Township 34 Range 22



On the 16th day of April, 1964, the described corner was evidenced by a sandstone monument

and to perpetuate the location of said corner, at the exact location thereof, a permanent marker was placed consisting of the same sandstone monument with a 1/2" iron pipe on the north side (down $\gamma \pm$)

1.5±

AND on the 5th day of June, 2003, said permanent marker was found and the ties were updated

Updated reference ties are as shown below.

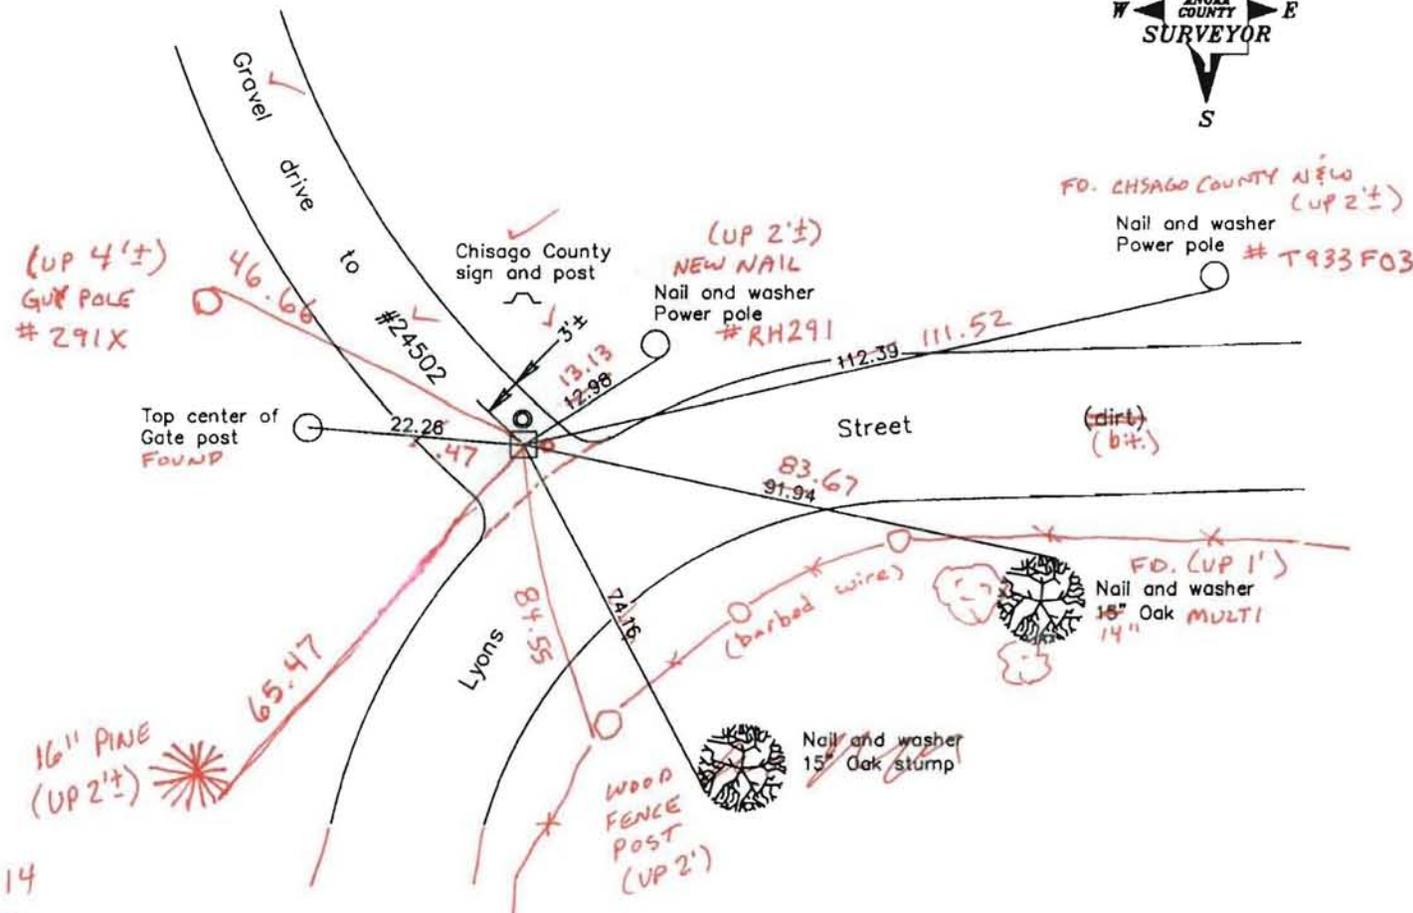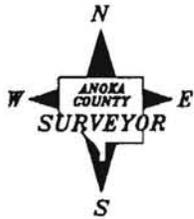

4-25-14
BK-SS
T/T

Revised date
10/17/90
6/14/93
6/05/03

N.A.D. 1983 Coordinates (1996 Adjustment)	
County Project Coordinates	
Northing	237364.8326
Easting	563461.7493
Date	6/05/03

I hereby certify that this United States public land survey monument record is correct and complete to the best of my knowledge and belief.

Larry D. Hoium Date 6/05/03

Larry D. Hoium, Anoka County Surveyor

Minnesota License Number 18165

VRS-3DR = 0.08 N = 237364.8282 E = 563461.6991

CERTIFICATE OF LOCATION OF GOVERNMENT CORNER

County of Anoka


State of Minnesota

N.E. 1/4 Corner of Sec. 25 Township 34 Range 22


I hereby certify that on the 16 day of APRIL, 1964 I found the described corner which was evidenced by SANDSTONE MON.

and I further certify that to perpetuate the location of said corner, I did, at the exact location thereof, place a permanent marker consisting of SAME 1/2" I.P. ON NORTH SIDE
DOWN 1' +/-

which reference or witness monuments are located in the manner following:

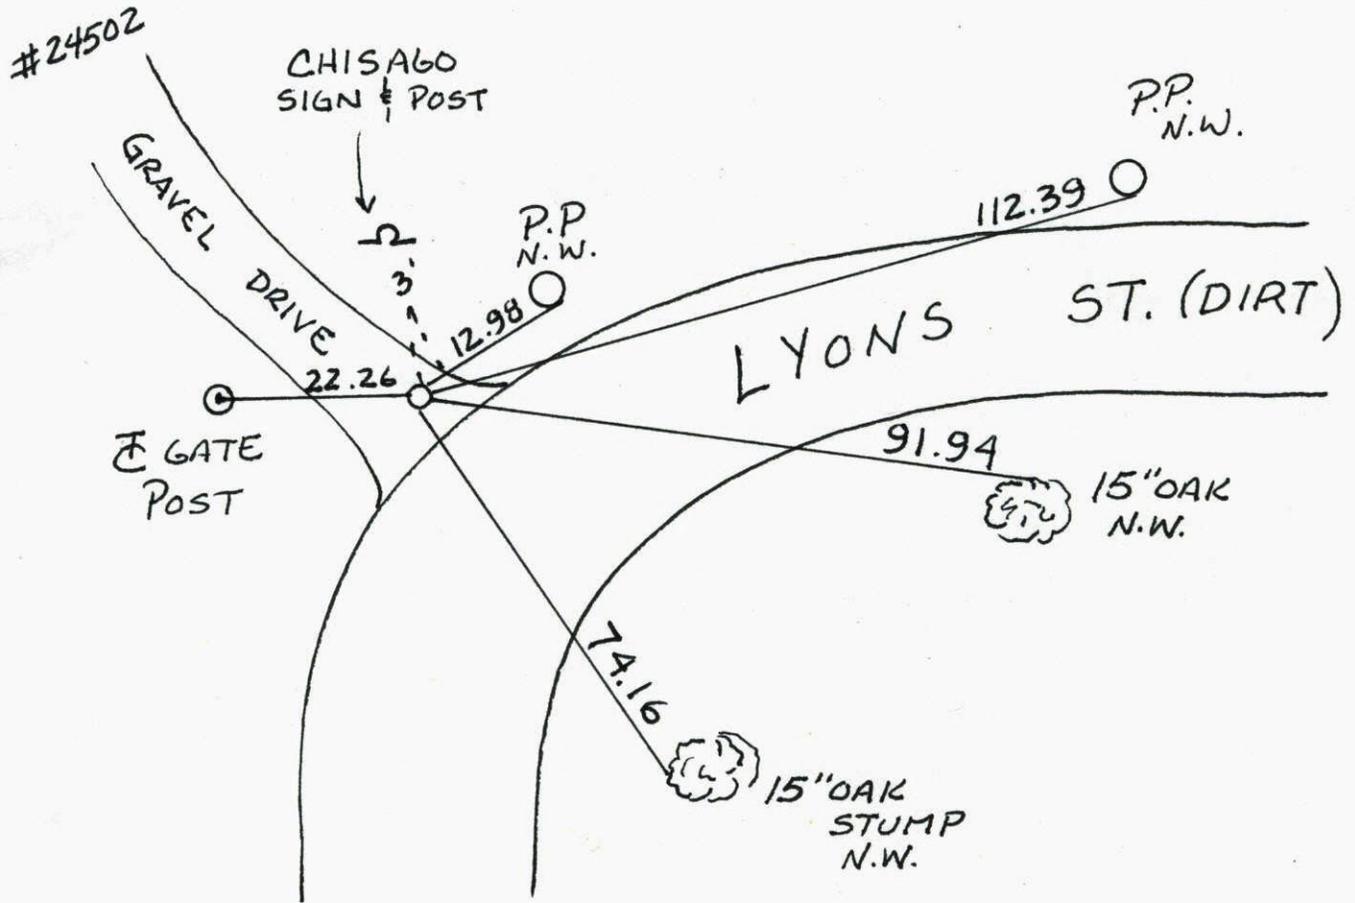


Revised date	Revised date	Revised date
10-17-90		
6-14-93		
6-5-03		

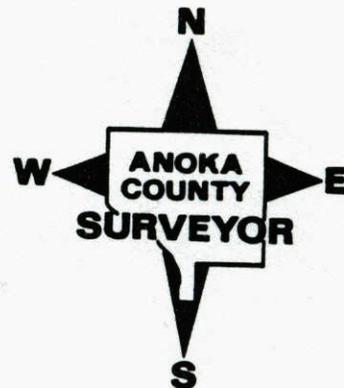

NORTH EAST 1/4 SEC 25 T34 R 22

RETIE SANDSTONE MONUMENT
DOWN 1' ±

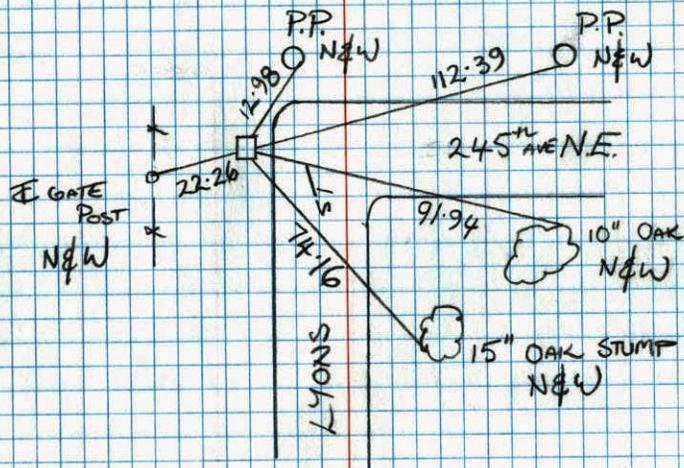

6-14-93


JAMIE ANDERSON

JOSH ANDERSON

NE CORNER SECTION 25-T34-R22

8 1/2" x 7" RED SANDSTONE MONUMENT. 1/2" HOLE DRILLED IN TOP CENTER. FOUND 8 1/2" x 5 1/2" PIECE WITH 1 1/2" HOLE UPSIDE DOWN, SITTING ON 3 BRICKS. BRICKS SITTING ON SANDSTONE MONUMENT. SET IRONS 1/2" ON WEST SIDE, 2" ON SOUTH SIDE, AND 1/2" ON NORTH SIDE. MONUMENT DOWN 1' ±.

17 AUG 66
D. POTTER
H. LARSON
G. REIMER

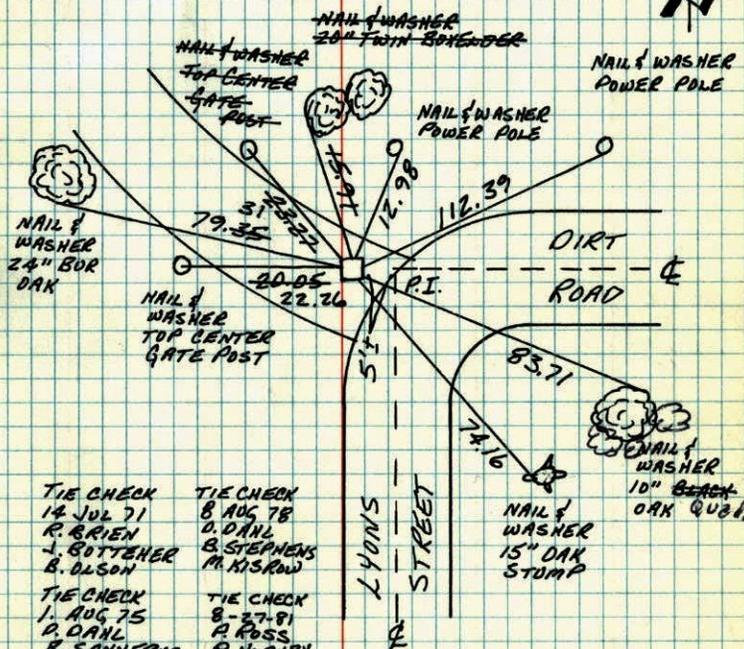

TIE CHECK
14 JUL 71
R. BRIEN
J. BOTTNER
B. OLSON

TIE CHECK
8 AUG 78
D. DANL
B. STEPHENS
M. KISKROW

TIE CHECK
1 AUG 75
D. DANL
B. SANNERPOD
G. ADAMS


TIE CHECK
8-27-81
A. ROSS
P. HORNBY

TEMPERATURE CORRECTED ROLAND W. ANDERSON
AND HORIZONTALLY COUNTY SURVEYOR
TAPED MEASUREMENTS ANOKA COUNTY, MINNESOTA

NE Corner Sec 25 T34 R22

8 1/2 x 7" Red Sandstone, 1/2" hole drilled
in top center

24" Oak
Nail & Washer

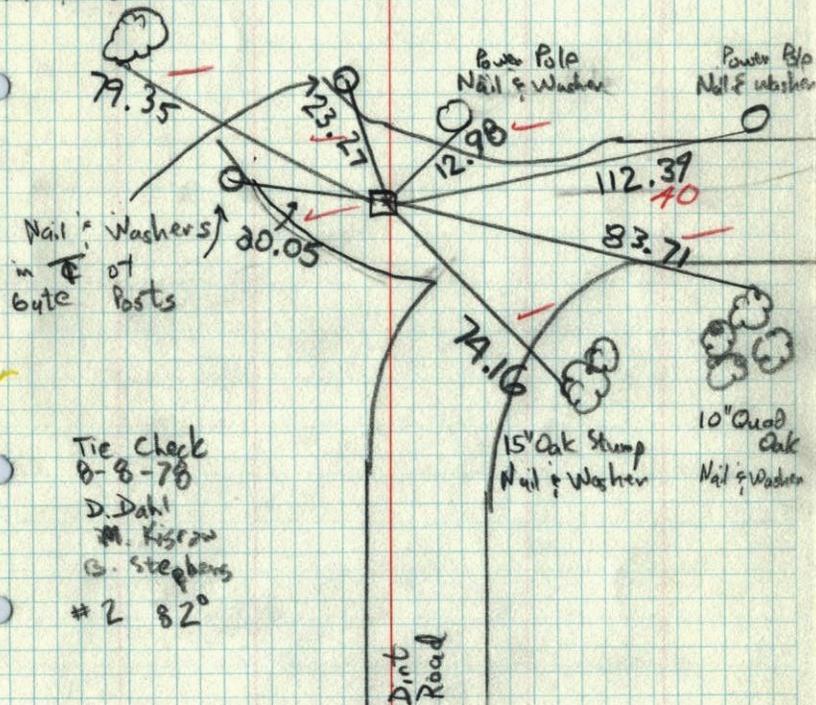

Tie Check
8-8-78
D. Dahl
M. Kiser
G. Stephens
#2 82°

NE Corner Sec. 25, T34 R22

8 1/2 x 7" Red Sandstone
1/2" Hole Drilled in Top Center


Down
1.0±

Found 2 1/2" x 5 1/2" Piece
With 1 1/2" Hole Upside
Down, Sitting on 3
Bricks, Bricks sitting
on Sandstone Mon.

Set Iron 1/2" on West Side
Iron 2" on South Side
Iron 1/2" Pin North Side

Check
New
Ties
8-8-78

D. Dahl

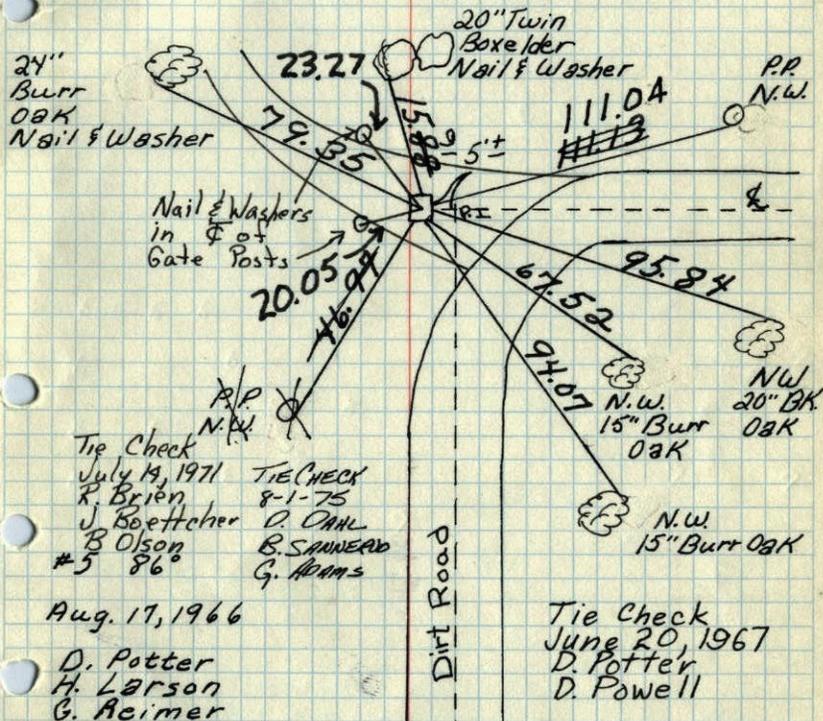

Tie Check
July 19, 1971
R. Brien
J. Boettcher
B. Olson
#5 86°

TIE CHECK
8-1-75
D. DAHL
B. SANDHEAD
G. ADAMS

Aug. 17, 1966

D. Potter
H. Larson
G. Reimer

Tie Check
June 20, 1967
D. Potter
D. Powell

TEMPERATURE CORRECTED
AND HORIZONTALLY
TAPED MEASUREMENTS

ROLAND W. ANDERSON
COUNTY SURVEYOR
ANOKA COUNTY, MINNESOTA


NE Corner Sec. 25, T34 R22

8 1/2" x 7" Red Sandstone
1/2" Hole Drilled in Top
Center

DOWN
1ft. ±

Found 8 1/2" x 5 1/2" Piece
With 1 1/2" Hole Upside
Down, Sitting on 3
Bricks, Bricks sitting
on Sandstone Mon.

Set Iron 1/2" on West Side DOWN 3" ±
Iron 2" on South Side
Iron 1/2" Pin North Side

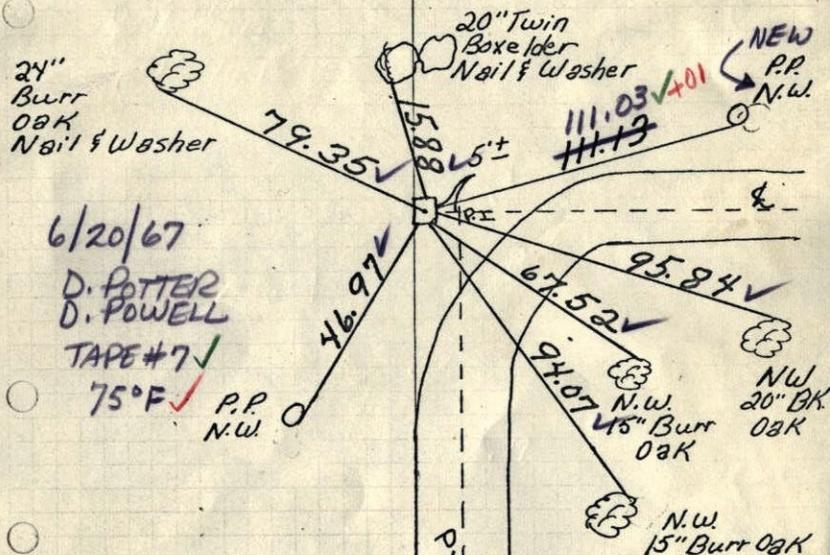

6/20/67

D. POTTER
D. POWELL

TAPE #7

75°F

P.P.
N.W.

#5 86°

Aug. 17, 1966

D. Potter
H. Larson
G. Reimer

TEMPERATURE CORRECTED
AND HORIZONTALLY
TAPED MEASUREMENTS


ROLAND W. ANDERSON
COUNTY SURVEYOR
ANOKA COUNTY, MINNESOTA

NE CORNER SEC 25, T34, R22

8 1/2" x 7" RED SANDSTONE
1/2" HOLE DRILLED IN TOP
CENTER

FOUND 8 1/2" x 5 1/2" PIECE
WITH 1 1/2" HOLE UPSIDE
DOWN, SITTING ON 3
BRICKS, BRICKS SITTING
ON SANDSTONE MON.

SET IRON 1/2" ON WEST SIDE
IRON 2" ON SOUTH SIDE
IRON 1/2" PIN NORTH SIDE

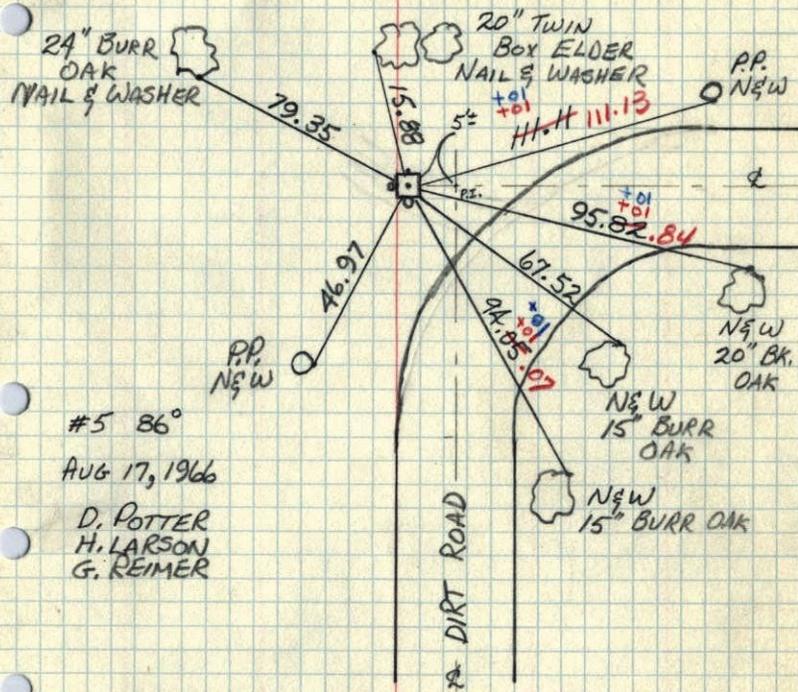

#5 86°

AUG 17, 1966

D. POTTER
H. LARSON
G. REIMER

NE Cor. Sec. 25, T34, R22

12" x 12" Red Sandstone, 1/2" hole drilled
in center of stone. 2" and 1/2" Iron Pipes
alongside Sandstone.

Minn. State Plane Co-ordinates



Don Hult
4/16/64

Y 152,608.33 X 2,316,072.55

