

CERTIFICATE OF LOCATION OF GOVERNMENT CORNER

County of Anoka

State of Minnesota


Witness Corner of Sec. 28 Township 34 Range 22
 (on north line of section)

On the 12th day of February, 1979, the described corner was evidenced by area resurvey

and to perpetuate the location of said corner, at the exact location thereof, a permanent marker was placed consisting of a cast iron monument * FOUND SIGN & POST ON N. SIDE OF MON. FACING SOUTH

AND on the ___ day of _____, _____, said permanent marker was _____

Updated reference ties are as shown below.

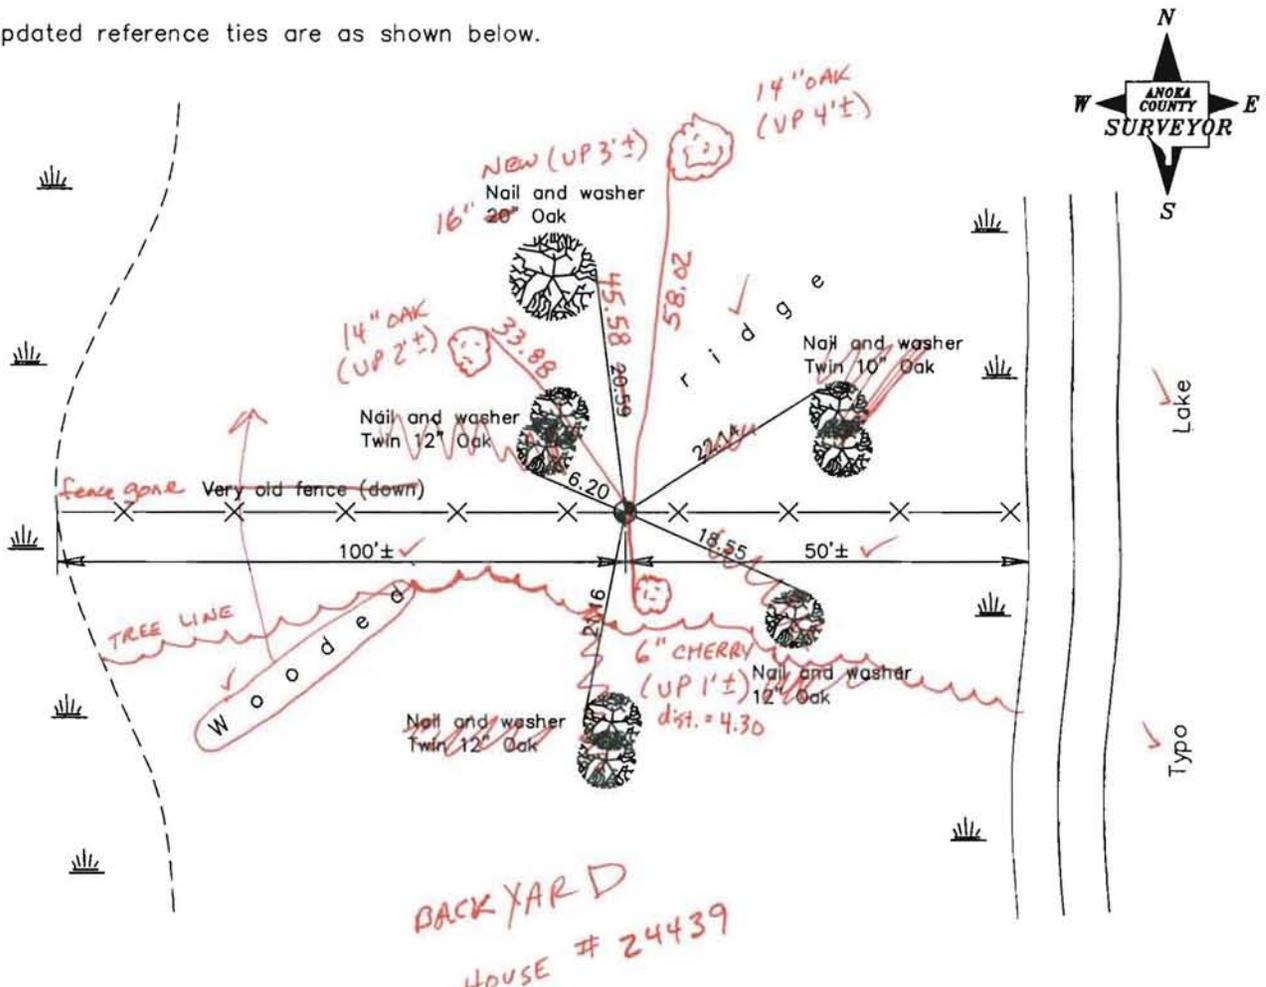

5-2-14
BK-55
TAPED

Revised date	7/07/93

N.A.D. 1983 Coordinates (1996 Adjustment)	
County Project Coordinates	
Northing	237911.5119
Easting	544529.0008
Date	1/12/04

I hereby certify that this United States public land survey monument record is correct and complete to the best of my knowledge and belief.

_____, Anoka County Surveyor

Minnesota License Number _____

CERTIFICATE OF LOCATION OF GOVERNMENT CORNER

County of Anoka


State of Minnesota

WITNESS Corner of Sec. 28 Township 34 Range 22
NORTH LINE


I hereby certify that on the 12 day of FEB., 1979, I found the described corner which was evidenced by AREA RE-SURVEY

and I further certify that to perpetuate the location of said corner, I did, at the exact location thereof, place a permanent marker consisting of CAST IRON MON.

which reference or witness monuments are located in the manner following:

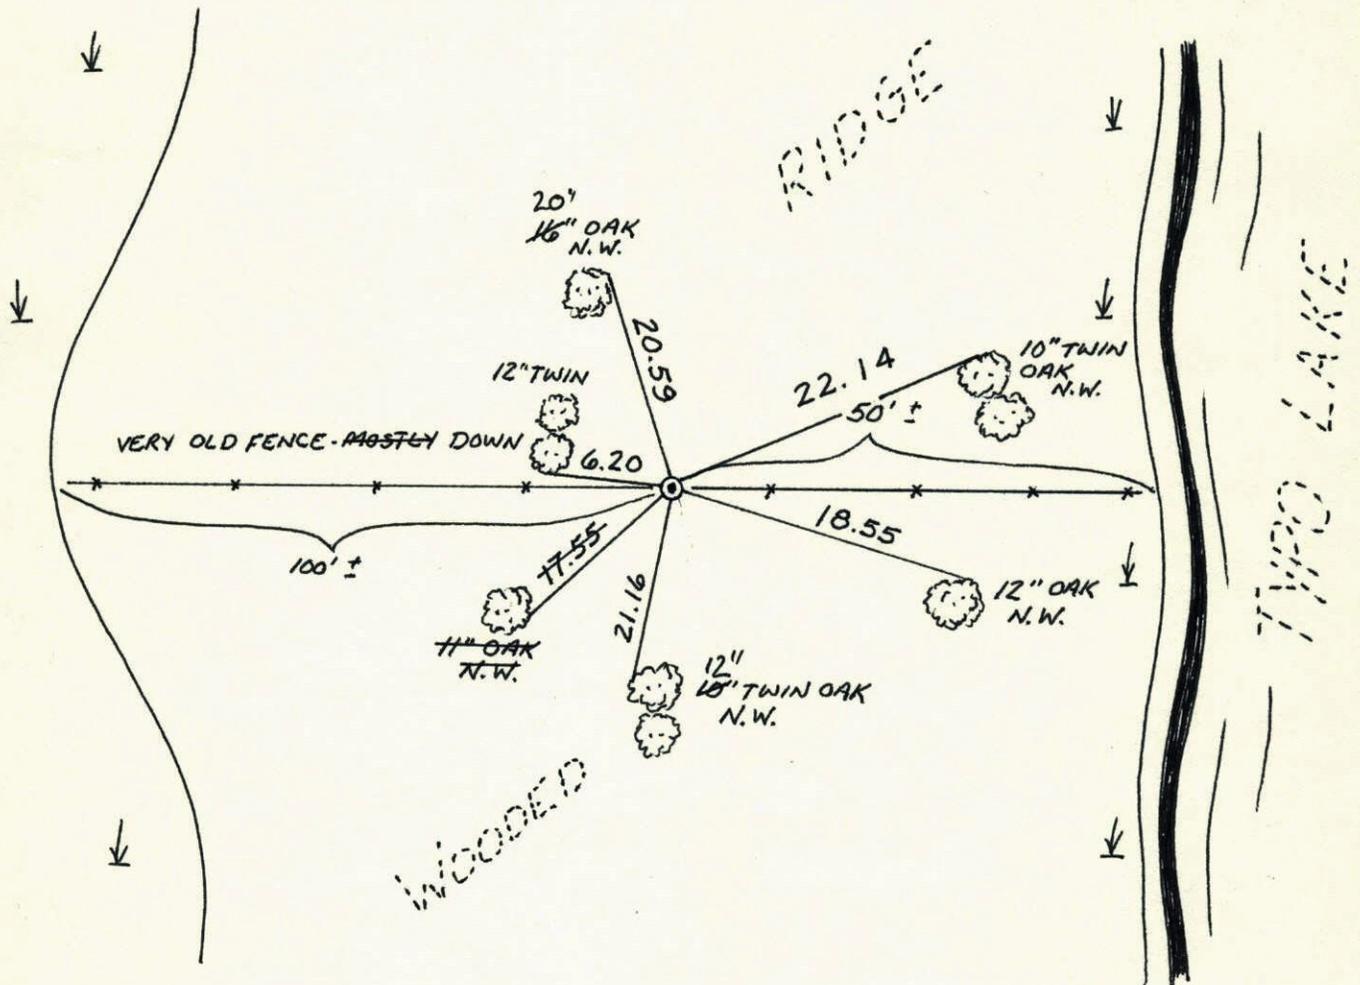

Revised date	Revised date	Revised date
7-7-93		

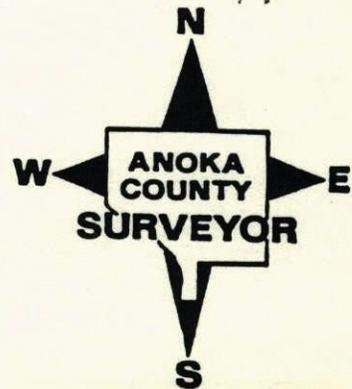

CERTIFICATE OF LOCATION OF GOVERNMENT CORNER

County of Anoka


State of Minnesota

Witness Corner of Sec. 28 Township 34 Range 22
on North Line

I hereby certify that on the 12 day of February, 1979, I found the described corner which was evidenced by Area resurvey

and I further certify that to perpetuate the location of said corner, I did, at the exact location thereof, place a permanent marker consisting of cast iron monument

which reference or witness monuments are located in the manner following:

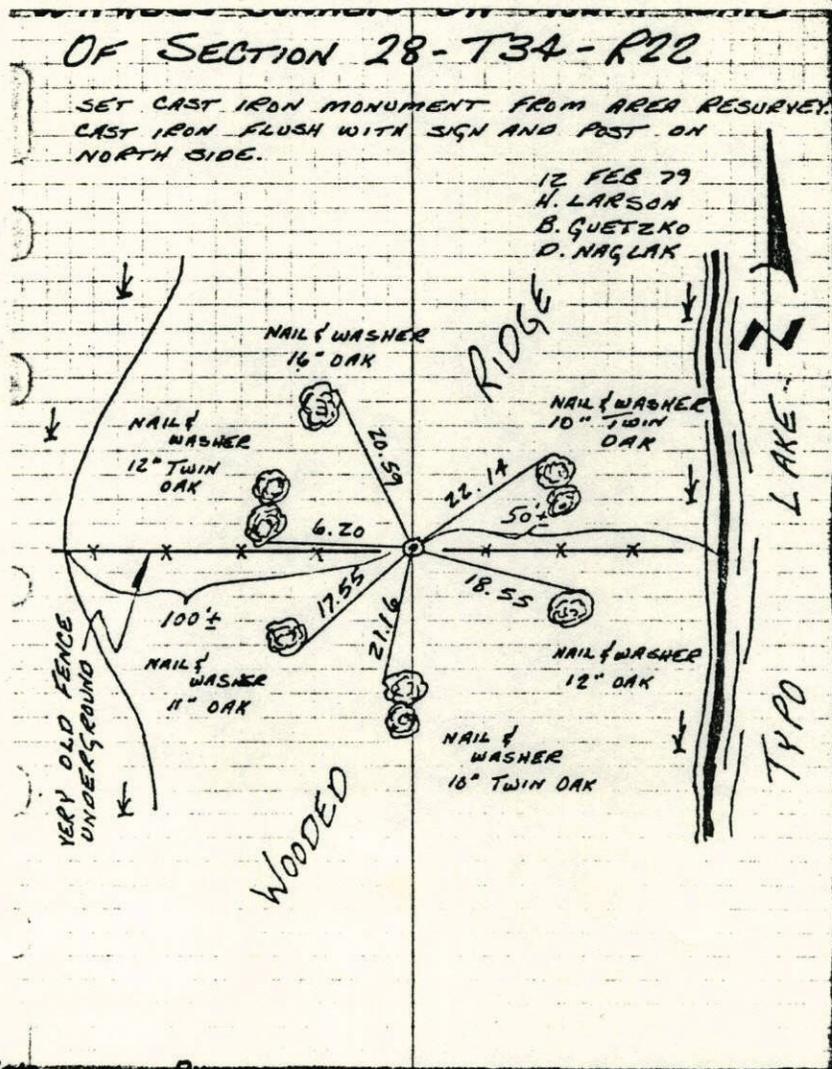

Revised date

By

Minnesota State Plane Coordinates
South Zone

Y _____ X _____

County Surveyor _____ Date _____


Registered Land Surveyor No. _____

10

WITNESS CORNER ON NORTH LINE OF SECTION 28-T34-R22

SET CAST IRON MONUMENT FROM AREA RESURVEY.
CAST IRON FLUSH WITH SIGN AND POST ON
NORTH SIDE.

12 FEB 79
H. LARSON
B. GUETZKO
D. NAGLAK

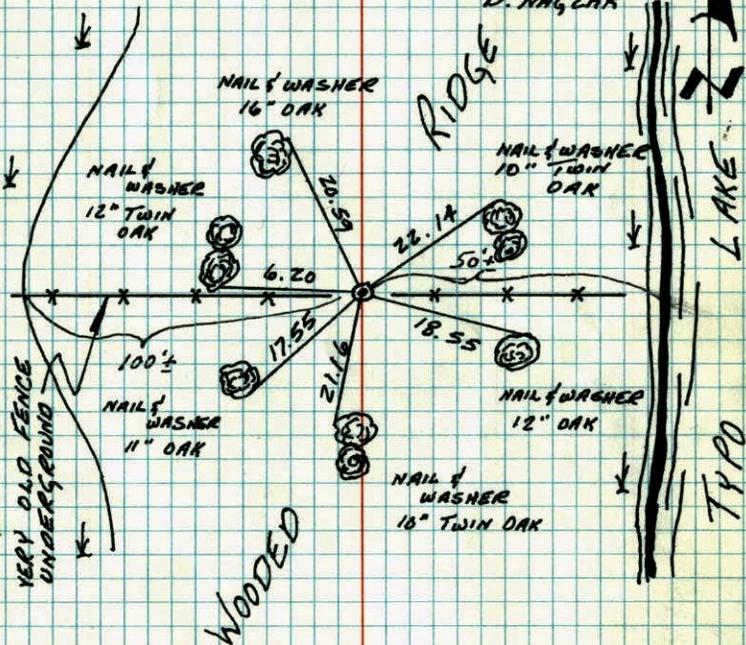


TEMPERATURE CORRECTED
AND HORIZONTALLY
TAPED MEASUREMENTS

ROLAND W. ANDERSON
COUNTY SURVEYOR
ANOKA COUNTY, MINNESOTA

W.C. on North Line of Sec. 28 T34 R22

Set cast iron monument from area
resurvey. c.i. flush with sign & post
on North side

2-12-79
H. Larson
B. Guetzko
D. Naglak

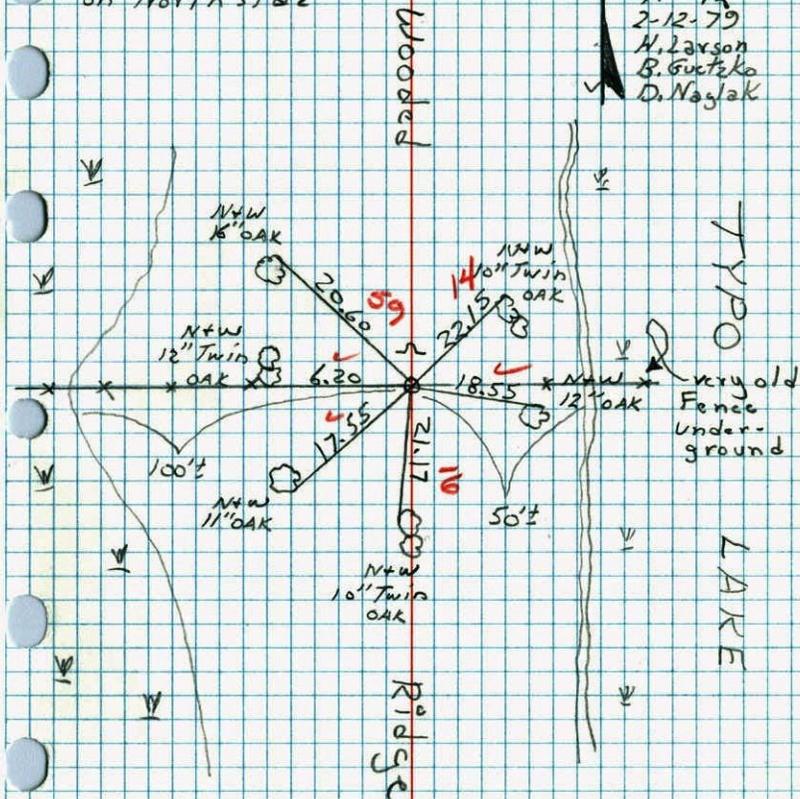


very old
Fence
Under-
ground

LAKE