NORTH 1/4 CORNER SECTION 35 T33 R23

FOUND CAST IRON BROKEN AND OUT OF GROUND BECAUSE OF CONSTRUCTION REPLACED AND RETIED. C.I. DOWN .2'±

REMOVED AXLE SHAFT

4-2-91
K. LARSON
B. KLENZ
M. STEWART

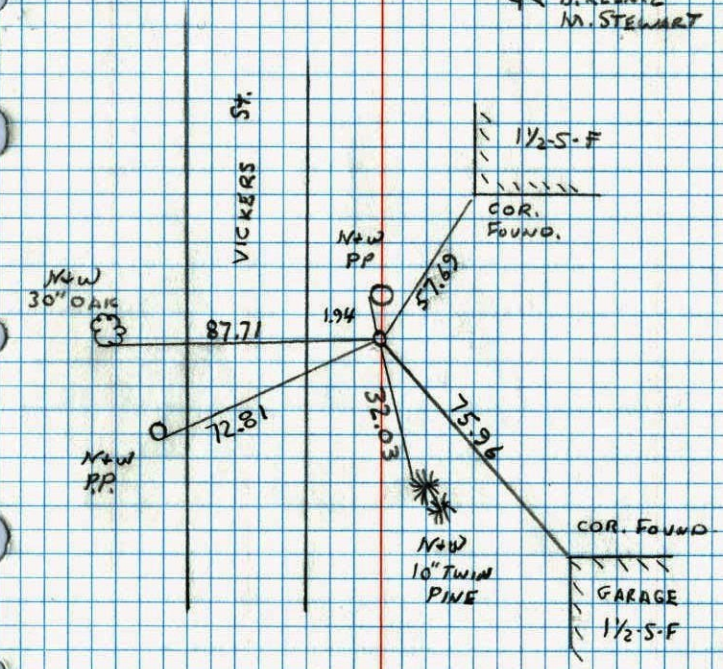

NO. 448 TELEDYNE