

CERTIFICATE OF LOCATION OF GOVERNMENT CORNER

County of Anoka


State of Minnesota

CENTER Corner of Sec. 34 Township 33 Range 23


I hereby certify that on the 9 day of JUNE, 19 65, I found the described corner which was evidenced by IRON PIPE SET BY R.M. KNUDSON

and I further certify that to perpetuate the location of said corner, I did, at the exact location thereof, place a permanent marker consisting of SAME

which reference or witness monuments are located in the manner following:

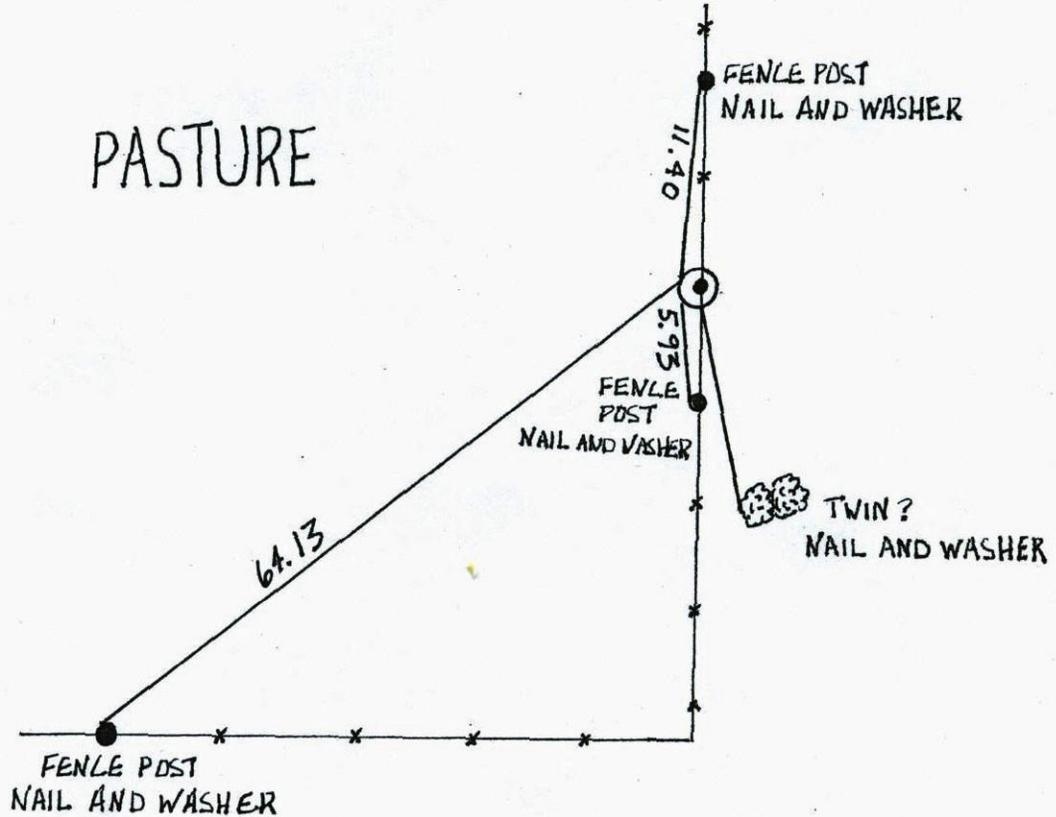


| Revised date | Revised date | Revised date |
|--------------|--------------|--------------|
| 6-4-87 | | |
| 8-26-92 | | |
| 8-15-97 | | |
| | | |
| | | |
| | | |
| | | |

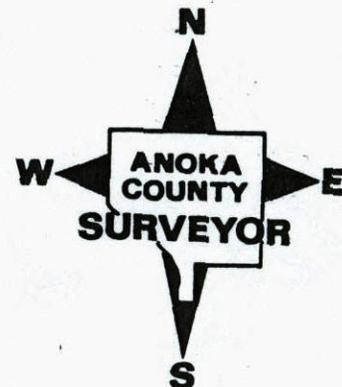

Center Corner of Section 34 T33 R23 P.114
Retied Iron Pipe


PASTURE

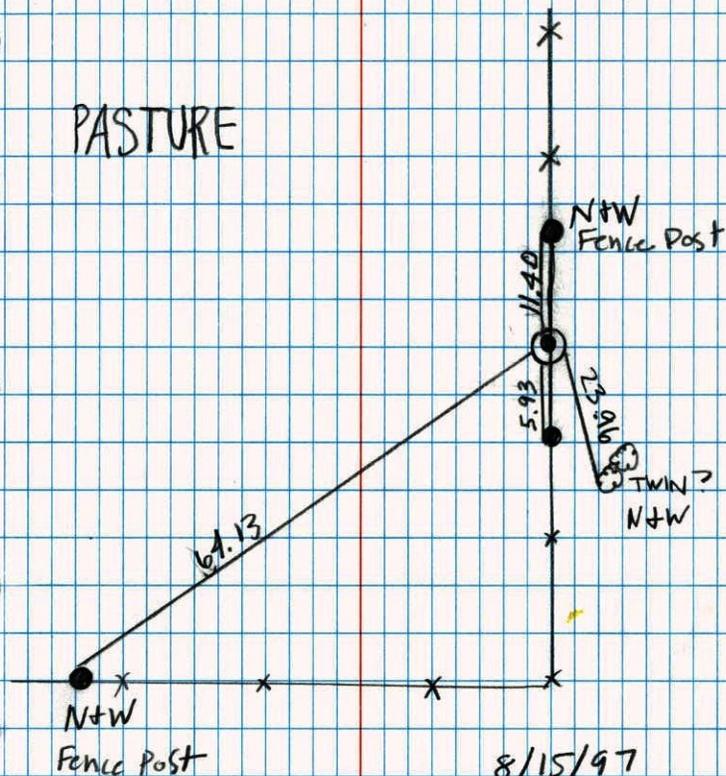

8/15/97
J. Simmer
H. Askew

CENTER SECTION 34 T33 R23
RETIED 1/2" IRON PIPE CAP # 12251

PASTURE

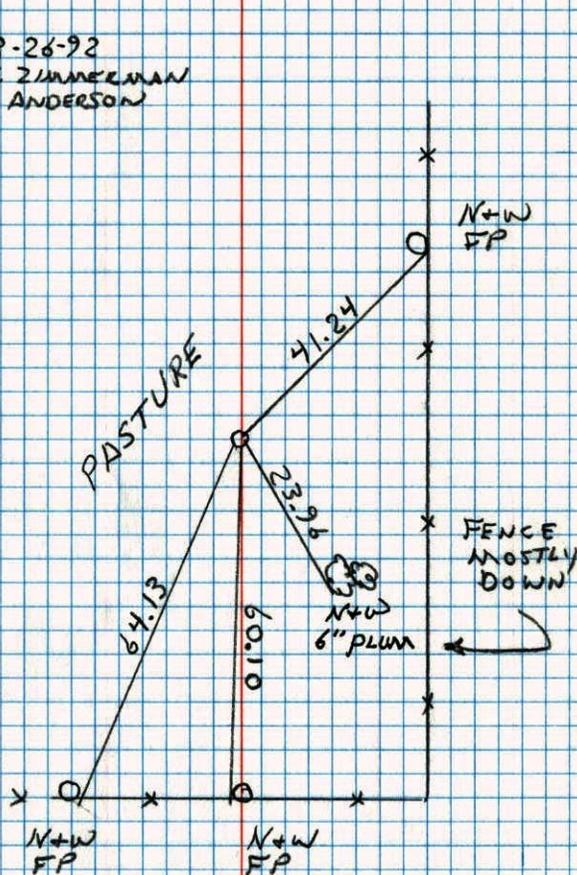

8-26-92
T. ZIMMERMAN
J. ANDERSON