

CERTIFICATE OF LOCATION OF GOVERNMENT CORNER

County of Anoka

State of Minnesota


North 1/4 Corner of Sec. 29 Township 34 Range 22

On the 1st day of February, 1979, the described corner was evidenced by area resurvey

and to perpetuate the location of said corner, at the exact location thereof, a permanent marker was placed consisting of a cast iron monument with a sign and post on the north side

AND on the ___ day of _____, _____, said permanent marker was _____

Updated reference ties are as shown below.

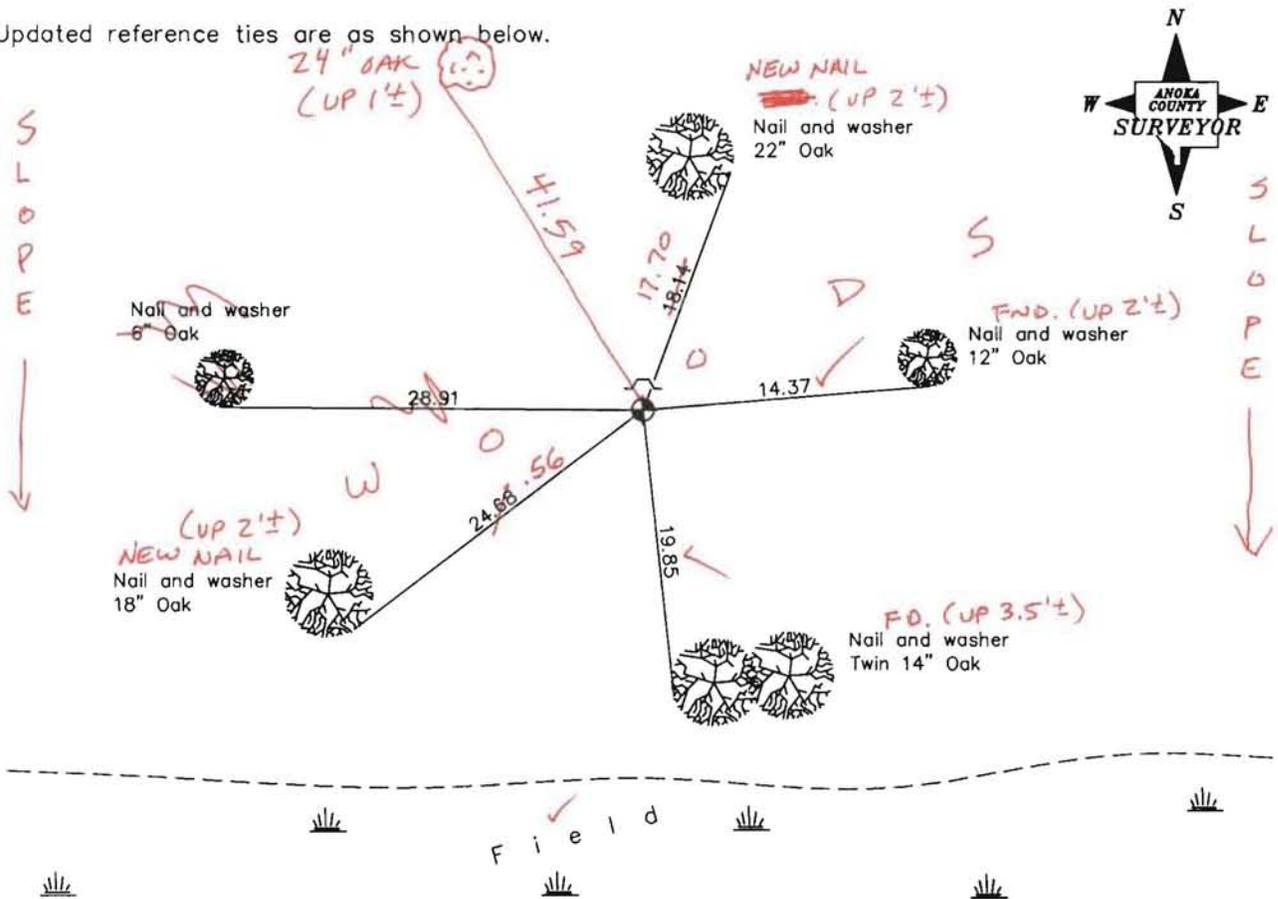

5-5-14
BK-55
TAPED

Revised date
8/13/86
7/12/93

N.A.D. 1983 Coordinates (1996 Adjustment)	
County Project Coordinates	
Northing	<u>238039.3703</u>
Easting	<u>539554.2029</u>
Date	<u>3/31/04</u>

I hereby certify that this United States public land survey monument record is correct and complete to the best of my knowledge and belief.

_____ Date _____

_____, Anoka County Surveyor

Minnesota License Number _____

CERTIFICATE OF LOCATION OF GOVERNMENT CORNER

County of Anoka


State of Minnesota

NORTH QTR. Corner of Sec. 29 Township 34 Range 22

I hereby certify that on the 1 day of FEB., 1979, I found the described corner which was evidenced by AREA-RE-SURVEY


and I further certify that to perpetuate the location of said corner, I did, at the exact location thereof, place a permanent marker consisting of CAST IRON WITH SIGN AND POST

which reference or witness monuments are located in the manner following:

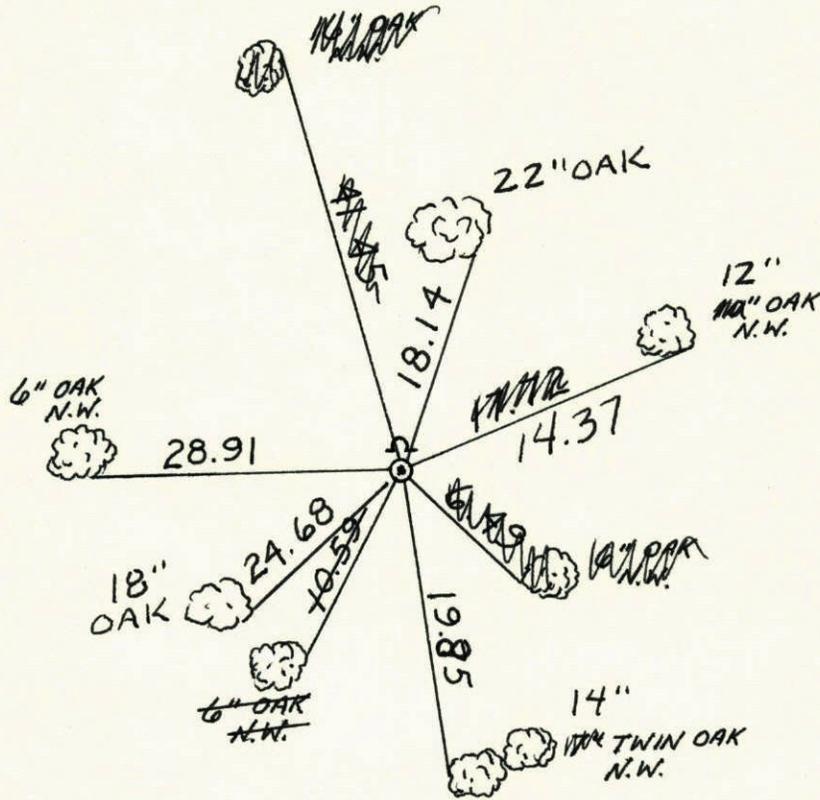

FIELD

Revised date	Revised date	Revised date
8-13-86		
7-12-93		

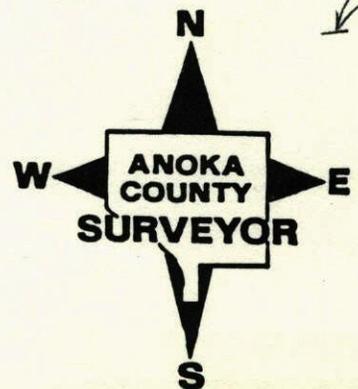

CERTIFICATE OF LOCATION OF GOVERNMENT CORNER

NORTH QUARTER Corner of Section 29, Township 34 N., Range 22 W., 4th P.M.

STATE OF MINNESOTA, County of ANOKA


At the corner location shown on the sketch:

On 1-19-88 found on ANOKA COUNTY CAST IRON MONUMENT, UP 0.1'
DATE

left monument as found, lowered monument, removed monument (explain)

On _____ placed a _____
DATE

SKETCH OF REFERENCE TIES

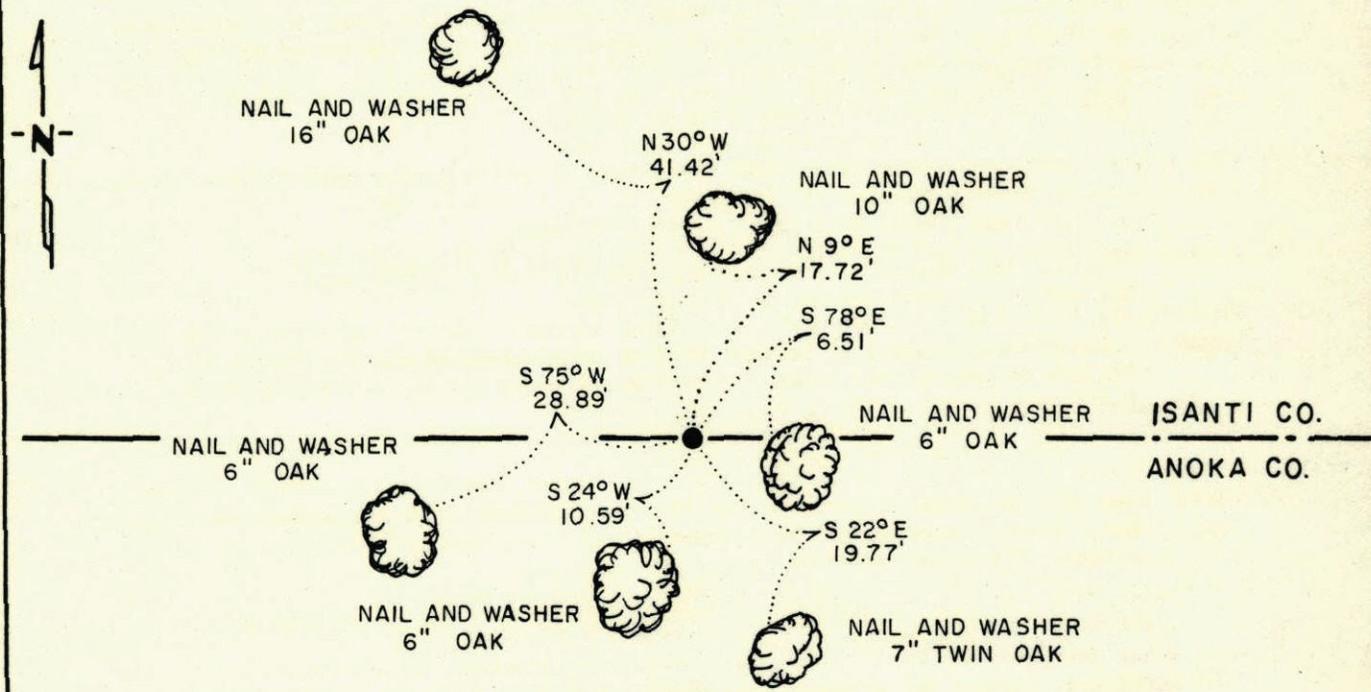

NOTE:
SET SURVEY MARKER
SIGN AND POST 1.0'
NORTH OF MONUMENT.

BEARINGS OBSERVED WITH COMPASS

Statement of evidence relative to this corner location is on back of page.

J. A. G. 5/6/88
G-1121

I hereby certify that this document and the data contained herein was prepared by me or under my direct supervision.

Bruce W. Sheppard
SIGNATURE

6-30-88
DATE

Registration No. 17003

Land Surveyor, Professional Engineer

County Surveyor, County Engineer

OFFICE OF THE COUNTY RECORDER

County of _____

I hereby certify that this document was filed in the Co. Recorders office at _____ .M. on the _____ day of _____ A.D., 19 _____

County Recorder _____

By _____, Deputy

DOCUMENT NO. _____

North Quarter Corner of Section 29, Township 34 North, Range 22 West

The DNR Bureau of Engineering contacted the following for survey information:

Secretary of State's Office
Isanti County Recorder's Office
Isanti County Surveyor - Don E. Hansen, RLS #9260
Hult and Associates, Inc., of Forest Lake
Kurth Surveying, Inc., of Columbia Heights
Dale B. Anderson, RLS #16091
Anoka County Surveyor's Office

- 1854 U.S. General Land Office notes obtained from the Secretary of State's Office show that a wood post was set to mark the corner with the following bearing trees marked:
8" Black Oak, South 62° 30' East, 159 links (104.94 feet)
7" White Oak, North 55° 15' East, 124 links (81.84 feet)
- 1904 Surveyor's Record Book B, on page 100, obtained from the County Recorder's Office contains a survey by A. W. Holm. Survey states that the northeast corner of Section 30 was established by proportional measurement using government corners north and west of its location. Survey does not give any information on the north quarter corner of Section 29.
- 1978 August, a worksheet obtained from the Anoka County Surveyor's Office shows the computed lost position of corner:
2607.885 feet from adjoining section corners
A monument was not set at the computed position of corner.
- 1978 Worksheets and field notes obtained from Isanti County Surveyor, Don E. Hansen, RLS #9260, show the corner at the lost position:
2607.885 feet from adjoining section corners
A monument was not set at the lost position.
- 1979 A tie sheet for corner obtained from the Anoka County Surveyor's Office shows that a cast iron monument was set for corner from an area resurvey. The following ties are shown to corner:
set sign and post on north side of monument
nail and washer in 10" Oak, northeast, 17.72 feet
nail and washer in 6" Oak, southeast, 6.65 feet
nail and washer in 7" twin Oak, south-southeast, 19.80 feet
nail and washer in 6" Oak, southwest, 10.59 feet
nail and washer in 6" Oak, west-northwest, 28.91 feet
nail and washer in 16" Oak, northwest, 41.38 feet
The above ties were checked in 1982.
- 1987 December, DNR Bureau of Engineering found an Anoka County cast iron monument at corner. Searched for but found no evidence of the GLO bearing trees. Searched for and found the 1979 ties as shown on sketch of reference ties. The cast iron monument was found to be:
2607.74 feet from the northeast corner of Section 29
2608.30 feet from the northeast corner of Section 30
0.04 of a foot south and 0.28 of a foot east of the lost position for corner.

Analysis of the above information led the DNR Bureau of Engineering to conclude that:

- A) In 1904, A. W. Holm established the northeast corner of Section 30 incorrectly and an Anoka County cast iron monument was found at this location (see statement of evidence for the northeast corner of Section 30).
- B) The found Anoka County cast iron monument at the north quarter corner of Section 29 marks the practical location of the corner.

CERTIFICATE OF LOCATION OF GOVERNMENT CORNER

County of Anoka


State of Minnesota

North One Quarter Corner of Sec. 29 Township 34 Range 22

I hereby certify that on the 1 day of February, 1979, I found the described corner which was evidenced by area resurvey

and I further certify that to perpetuate the location of said corner, I did, at the exact location thereof, place a permanent marker consisting of cast iron monument with a warning sign and post on the north side.

which reference or witness monuments are located in the manner following:

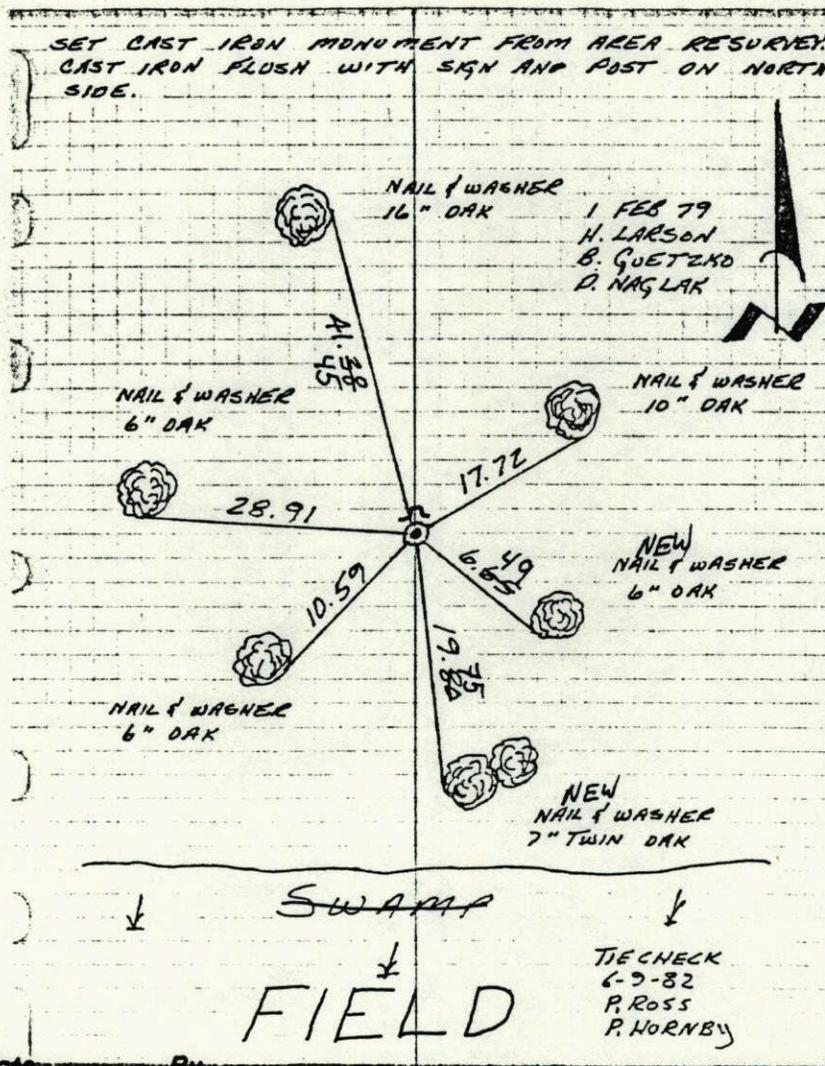

Revised date

By

6-9-82
8-13-86

P. Ross
D. Ross

Minnesota State Plane Coordinates
South Zone

Y _____ X _____


County Surveyor

Date

Registered Land Surveyor No. _____

N¹/₄ CORNER SECTION 29-T34-R22

SET CAST IRON MONUMENT FROM AREA RESURVEY.
CAST IRON FLUSH WITH SIGN AND POST ON NORTH
SIDE.

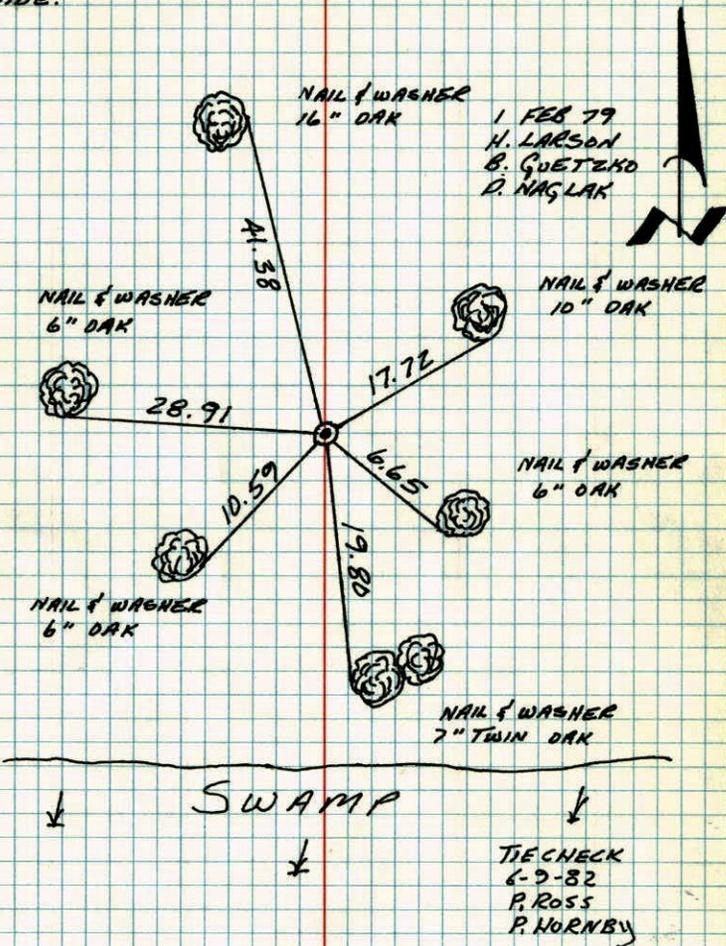


TEMPERATURE CORRECTED
AND HORIZONTALLY
TAPED MEASUREMENTS

ROLAND W. ANDERSON
COUNTY SURVEYOR
ANOKA COUNTY, MINNESOTA

N¹/₄ Cor. Sec. 29 T34 R22


Set cast iron monument From
Area Resurvey. C.I. flush with
sign + post on N. side

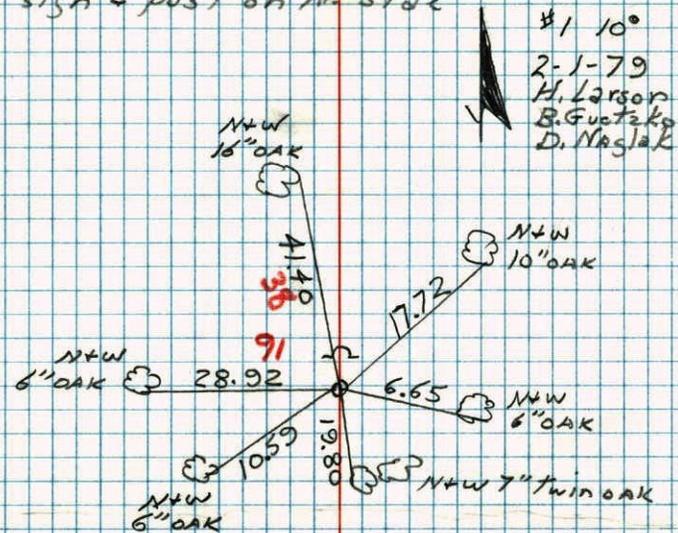

N 1/4 COR. SECTION 29-T34-R22

SET CAST IRON MONUMENT FROM AREA RESURVEY
CAST IRON FLUSH.

NO. 448
TELEPHONE

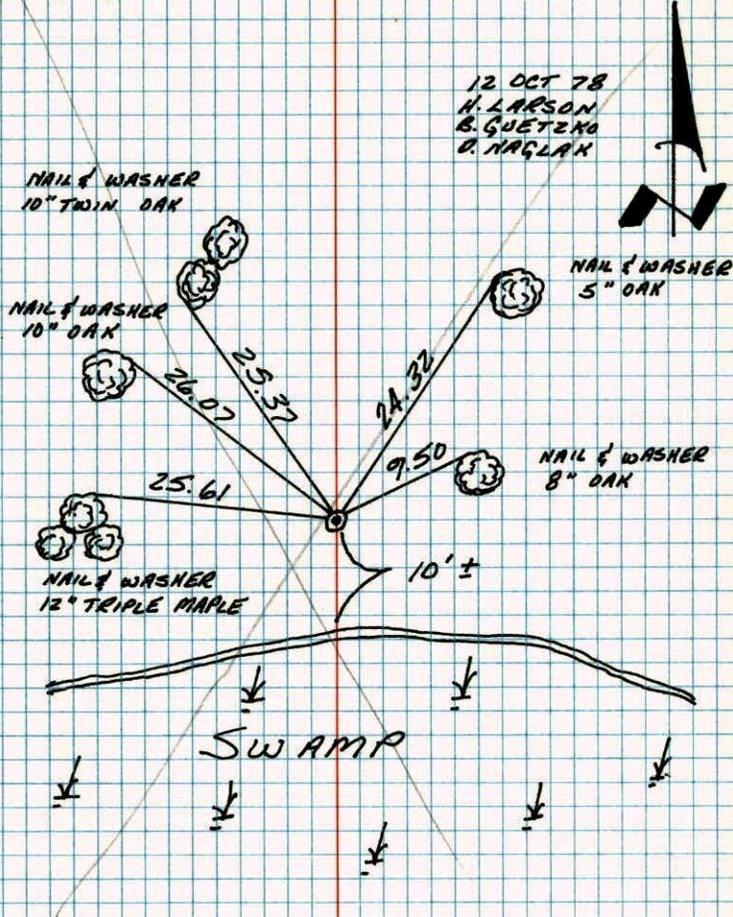

TEMPERATURE CORRECTED
AND HORIZONTALLY
TAPED MEASUREMENTS

ROLAND W. ANDERSON
COUNTY SURVEYOR
ANOKA COUNTY, MINNESOTA

N 1/4 Cor. Section 29 T34 R22

Set cast iron from area resurvey.
C.I. flush.

NO. 448
TELEPHONE

