

# CERTIFICATE OF LOCATION OF GOVERNMENT CORNER

County of Anoka

State of Minnesota

Northwest Corner of Sec. 29 Township 34 Range 22


On the 1st day of February, 1979, the described corner was evidenced by area resurvey

and to perpetuate the location of said corner, at the exact location thereof, a permanent marker was placed consisting of a cast iron monument with a sign and post on the north side

(MON. UP 0.5'± and leaning S'LY)

AND on the \_\_\_ day of \_\_\_\_\_, \_\_\_\_\_, said permanent marker was \_\_\_\_\_

Updated reference ties are as shown below:

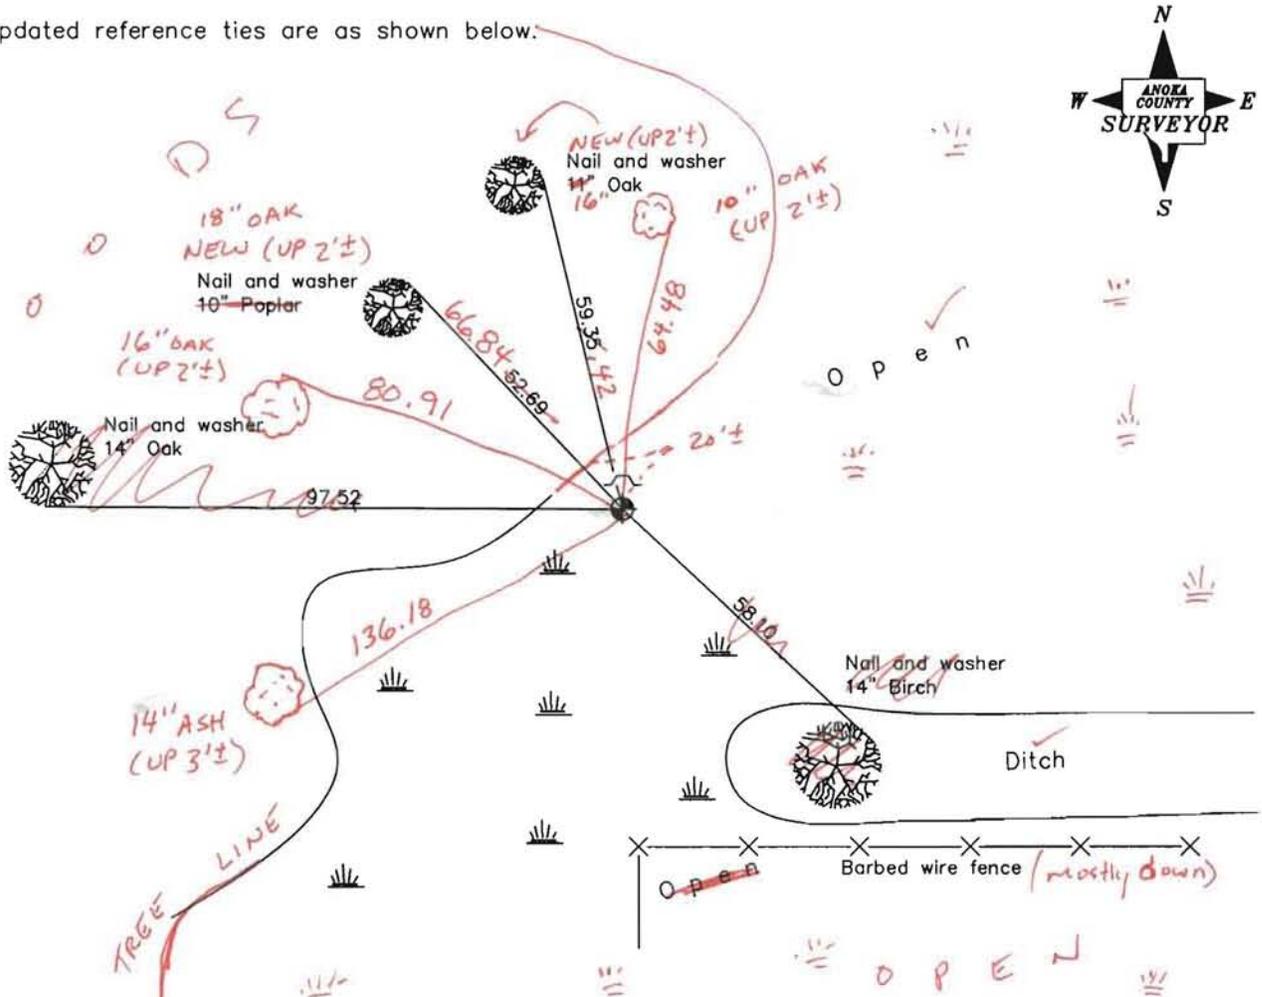

5-6-14  
BK-55  
TAPED

Revised date
6/09/82
8/13/86
7/07/93

N.A.D. 1983 Coordinates (1996 Adjustment)	
County Project Coordinates	
Northing	<u>238028.8283</u>
Easting	<u>536945.8900</u>
Date	<u>4/27/04</u>

I hereby certify that this United States public land survey monument record is correct and complete to the best of my knowledge and belief.

\_\_\_\_\_ Date \_\_\_\_\_

\_\_\_\_\_, Anoka County Surveyor

Minnesota License Number \_\_\_\_\_

VRS  
3DQ=0.06 N=238028.6695 E=536945.9160

# CERTIFICATE OF LOCATION OF GOVERNMENT CORNER

County of Anoka


State of Minnesota

NORTHWEST Corner of Sec. 29 Township 34 Range 22


I hereby certify that on the 1 day of FEB., 19 79, I found the described corner which was evidenced by AREA RESURVEY

and I further certify that to perpetuate the location of said corner, I did, at the exact location thereof, place a permanent marker consisting of CAST IRON, SIGN AND POST ON NORTH SIDE.

which reference or witness monuments are located in the manner following:

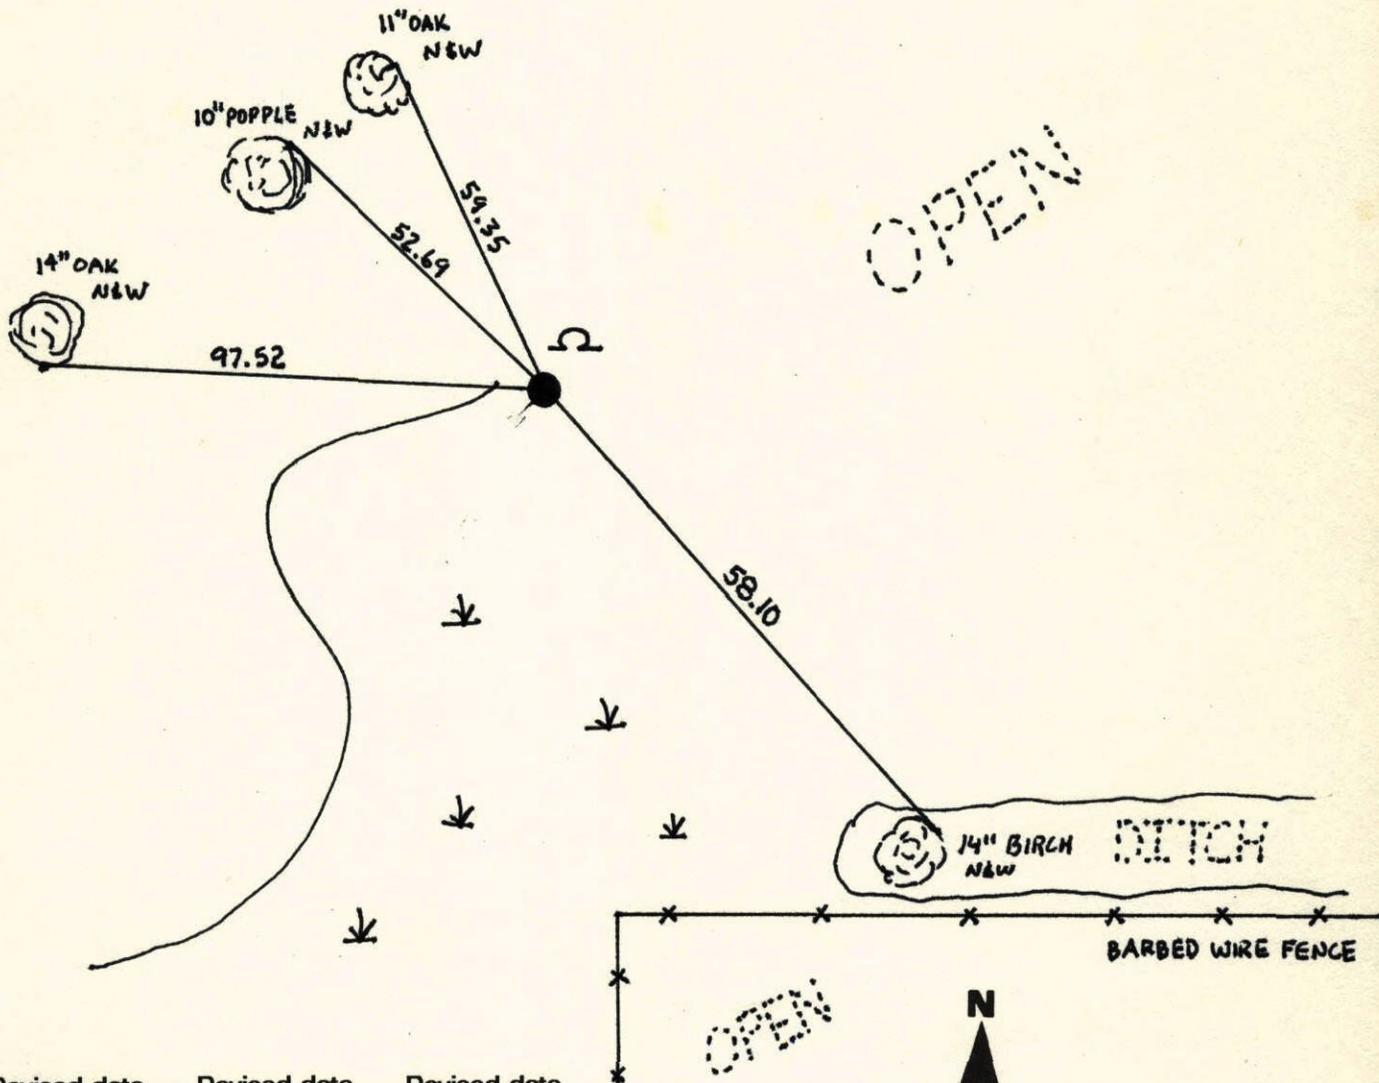

Revised date	Revised date	Revised date
6-9-82		
8-13-86		
7-7-93		

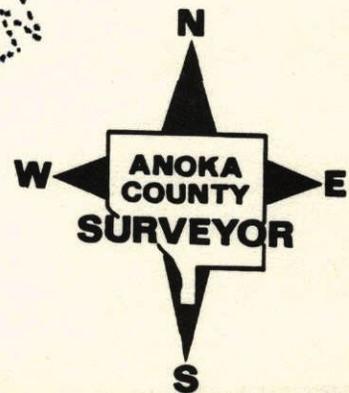

# CERTIFICATE OF LOCATION OF GOVERNMENT CORNER


NORTHEAST NW Corner of Section 30<sup>29</sup>, Township 34 N., Range 22 W., 4th P.M.

STATE OF MINNESOTA, County of ANOKA

At the corner location shown on the sketch:

- On 1-21-88 found an ANOKA COUNTY CAST IRON MONUMENT, FLUSH  
DATE
- left monument as found,  lowered monument,  removed monument (explain)
- On \_\_\_\_\_ placed a \_\_\_\_\_  
DATE

### SKETCH OF REFERENCE TIES

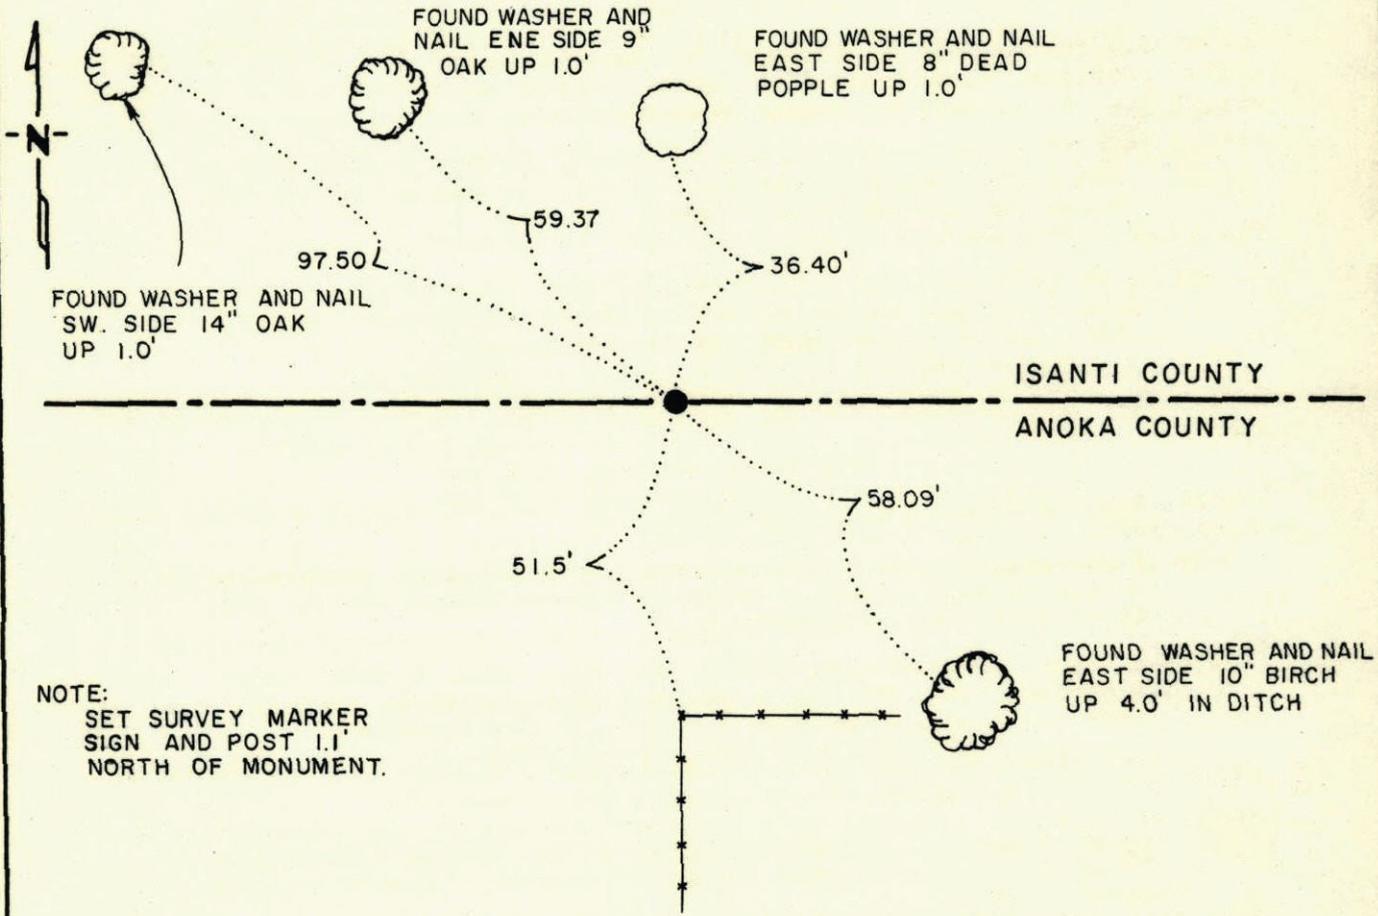

NOTE:  
SET SURVEY MARKER  
SIGN AND POST 1.1'  
NORTH OF MONUMENT.

Statement of evidence relative to this corner location is on back of page.

J.A.G. 6/24/88  
G-1121

I hereby certify that this document and the data contained herein was prepared by me or under my direct supervision.

Bruce W. Shappell 6-30-88  
SIGNATURE DATE

Registration No. 17003  
 Land Surveyor,  Professional Engineer  
 County Surveyor,  County Engineer

OFFICE OF THE COUNTY RECORDER  
County of \_\_\_\_\_

I hereby certify that this document was filed in the Co. Recorders office at \_\_\_\_\_ M. on the \_\_\_\_\_ day of \_\_\_\_\_ A.D., 19 \_\_\_\_\_

County Recorder \_\_\_\_\_  
By \_\_\_\_\_, Deputy  
DOCUMENT NO. \_\_\_\_\_

The DNR Bureau of Engineering contacted the following for survey information:

Secretary of State's Office  
Isanti County Recorder's Office  
Isanti County Surveyor - Don E. Hansen, RLS #9260  
Hult and Associates, Inc., of Forest Lake  
Kurth Surveying, Inc., of Columbia Heights  
Dale B. Anderson, RLS #16091  
Anoka County Surveyor's Office

- 1854 U.S. General Land Office notes obtained from the Secretary of State's Office show that a wood post was set to mark the corner in the margin of a marsh with the following bearing trees marked:  
8" Black Oak, North 8° East, 139 links (91.74 feet)  
9" Black Oak, South 73° West, 431 links (284.46 feet)
- 1904 Surveyor's Record Book B, on page 100, obtained from the County Recorder's Office contains a survey by A. W. Holm. Survey states that the corner was established by proportional measurement. Survey does not indicate what was set to mark corner but the following ties are shown to it:  
10" Black Oak, South 65° West, 365  
9" Black Oak, North 43° 30' West, 152  
The corner is shown:  
2640.00 feet from the east quarter corner of Section 19  
5280.00 feet from the northeast corner of Section 19  
2644.62 feet from the north quarter corner of Section 30  
4972.11 feet from the northwest corner of Section 30  
Survey does not show any distances to government corners to the south and east.
- 1978 August, a worksheet obtained from the Anoka County Surveyor's Office shows a coordinate for the corner. The corner is shown:  
2630.06 feet (2640.00' GLO distance) from the east quarter corner of Section 30  
5215.77 feet (5248.32' GLO distance) from the northeast corner of Section 29  
2644.62 feet (2640.00' GLO distance) from the north quarter corner of Section 30  
2636.56 feet (2640.00' GLO distance) from the east quarter corner of Section 19  
Worksheet does not indicate if a monument was set at the coordinates for the corner.
- 1978 Worksheets and field notes obtained from Isanti County Surveyor, Don E. Hansen, RLS #9260, show that an Anoka County cast iron monument was found at corner. An adjusted position for corner is also shown:  
50.14 feet north and 2.94 feet east of the found cast iron monument  
The following is stated about corner "Anoka County adjusted corner to new position." Survey does not state how the adjusted position for corner was determined but it is shown:  
2636.53 feet from the east quarter corner of Section 19  
5215.77 feet from the northeast corner of Section 29  
Survey does not state if the found cast iron monument was removed or if a monument was set at the adjusted position for corner.

1979 A tie sheet for corner obtained from the Anoka County Surveyor's Office shows that a cast iron monument was set for corner from an area resurvey. The following ties are shown to corner:

- set sign and post next to monument
- 50 feet north of a corner fence post with fences south and east
- nail and washer in 8" Popple, north-northeast, 36.38 feet
- nail and washer in 10" Birch, southeast, 57.91 feet —
- nail and washer in 10" multi-boxelder, southwest, 34.31 feet
- nail and washer in 14" Oak, west-northwest, 97.52 feet
- nail and washer in 9" Oak, northwest, 59.35 feet

The above ties were checked in 1982.

1988 January, DNR Bureau of Engineering found an Anoka County cast iron monument at corner. Searched for but found no evidence of the GLO bearing trees or the 1904 ties. The cast iron monument was found to be:

- 5216.04 feet from the northeast corner of Section 29
- 2634.80 feet from the east quarter corner of Section 19
- 5272.93 feet from the northeast corner of Section 19
- 2608.30 feet from the north quarter corner of Section 29

Searched for and found the 1979 ties as shown on sketch of reference ties.

Analysis of the above information led the DNR Bureau of Engineering to conclude that:

- A) In 1904, A. W. Holm established corner using government corners north and west of corner.
- B) A. W. Holm should have used government corners north, south, east, and west of corner to establish its location.
- C) The found Anoka County cast iron monument marks the location of the corner as established by A. W. Holm in 1904 and is the practical location of the corner.

# CERTIFICATE OF LOCATION OF GOVERNMENT CORNER

County of Anoka


State of Minnesota

North west Corner of Sec. 29 Township 34 Range 22

I hereby certify that on the 1 day of February, 1979, I found the described corner which was evidenced by Area resurvey

and I further certify that to perpetuate the location of said corner, I did, at the exact location thereof, place a permanent marker consisting of cast iron monument with a warning sign and post

which reference or witness monuments are located in the manner following:

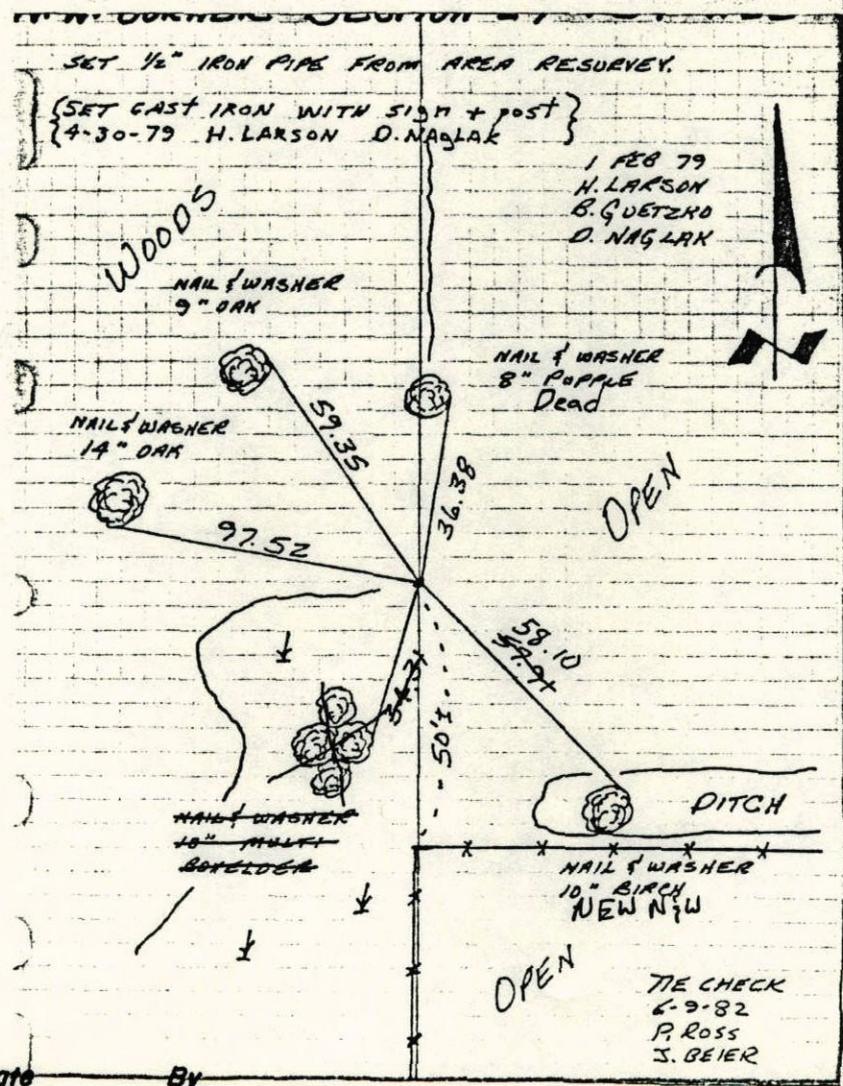

Revised date	By
4-30-79	H. Larson
6-9-82	P. Ross
8-13-86	D. Ross

Minnesota State Plane Coordinates  
South Zone


Y \_\_\_\_\_ X \_\_\_\_\_

County Surveyor \_\_\_\_\_ Date \_\_\_\_\_

Registered Land Surveyor No. \_\_\_\_\_

NW Corner Sec. 29 T. 34 R. 22

RETIRED CAST IRON MONUMENT

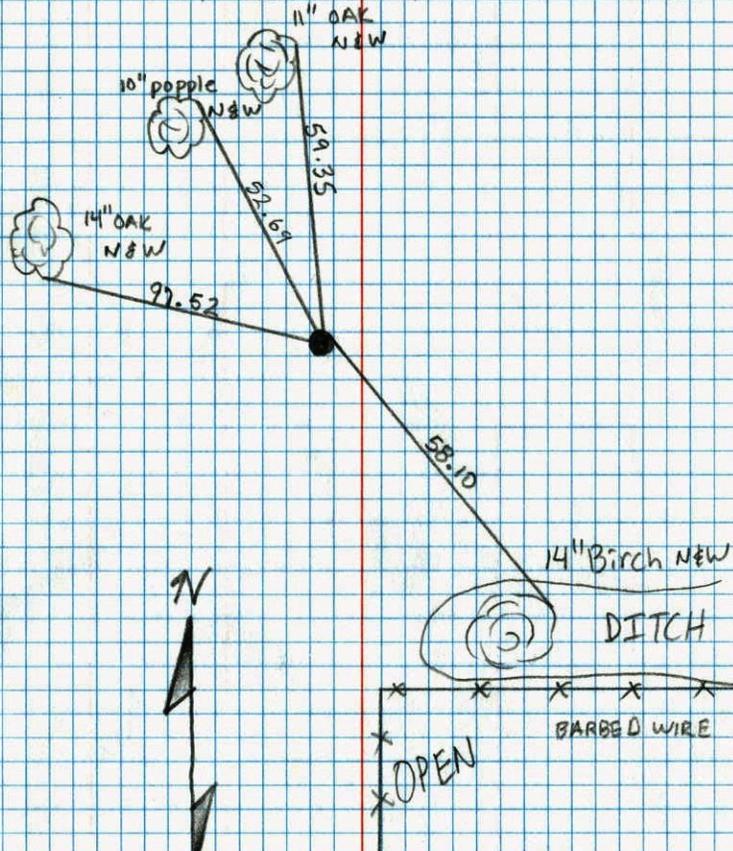


Josh Anderson  
Jayme Anderson  
7-7-93

N.W. CORNER SECTION 29-T34-R22

SET 1/2" IRON PIPE FROM AREA RESURVEY.

{SET CAST IRON WITH SIGN + POST  
4-30-79 H. LARSON D. NAGLAK}

1 FEB 79  
H. LARSON  
B. GUETZKO  
D. NAGLAK

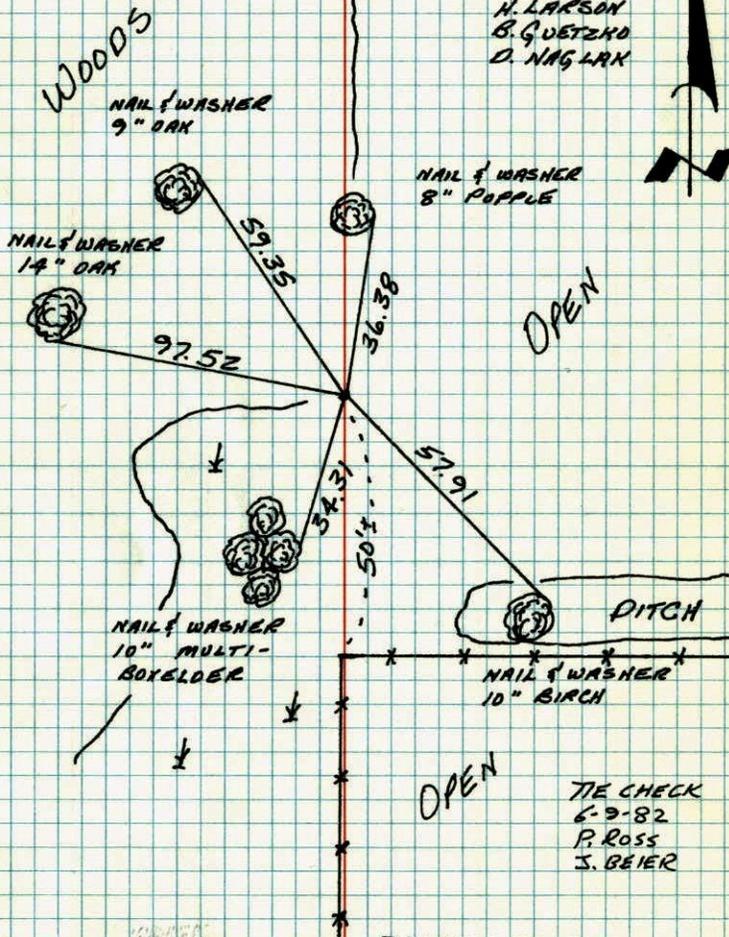

TIE CHECK  
6-9-82  
P. ROSS  
J. BEIER

TEMPERATURE CORRECTED  
AND HORIZONTALLY  
TAPED MEASUREMENTS

ROLAND W. ANDERSON  
COUNTY SURVEYOR  
ANOKA COUNTY, MINNESOTA

NW Cor. Sec. 29 T34 R22

Set 1/2" iron pipe from area  
resurvey

\*1 10°  
2-1-79  
N. Larson  
B. Gustafson  
D. Naglak

woods

open

NO. 448

TELEPHONE

